

ABERNATHY and ASSOCIATES

Kenneth B. Abernathy Jr.

Wisconsin Registered Land Surveyor S-1594


Rt. 3, Box 273
Elkhorn, Wisconsin 53121
Phone: (414) 723-4260 (office)
(414) 723-7209 (FAX)

PLAT OF SURVEY

LOTS 11 AND 12 OF CHESTNUT RIDGE
SUBDIVISION LOCATED IN PART OF
THE SE 1/4 OF THE SW 1/4 AND
PART OF THE NE 1/4 OF THE SW 1/4
OF SECTION 13, TOWN 2 NORTH,
RANGE 15 EAST, CITY OF DELAVAN,
WALWORTH COUNTY, WISCONSIN.


ORDERED BY: BROOKSTONE HOMES
SUITE 206
4450 MILTON AVE.
JANESVILLE, WI. 53546

JOB NO. 112-01-011/012

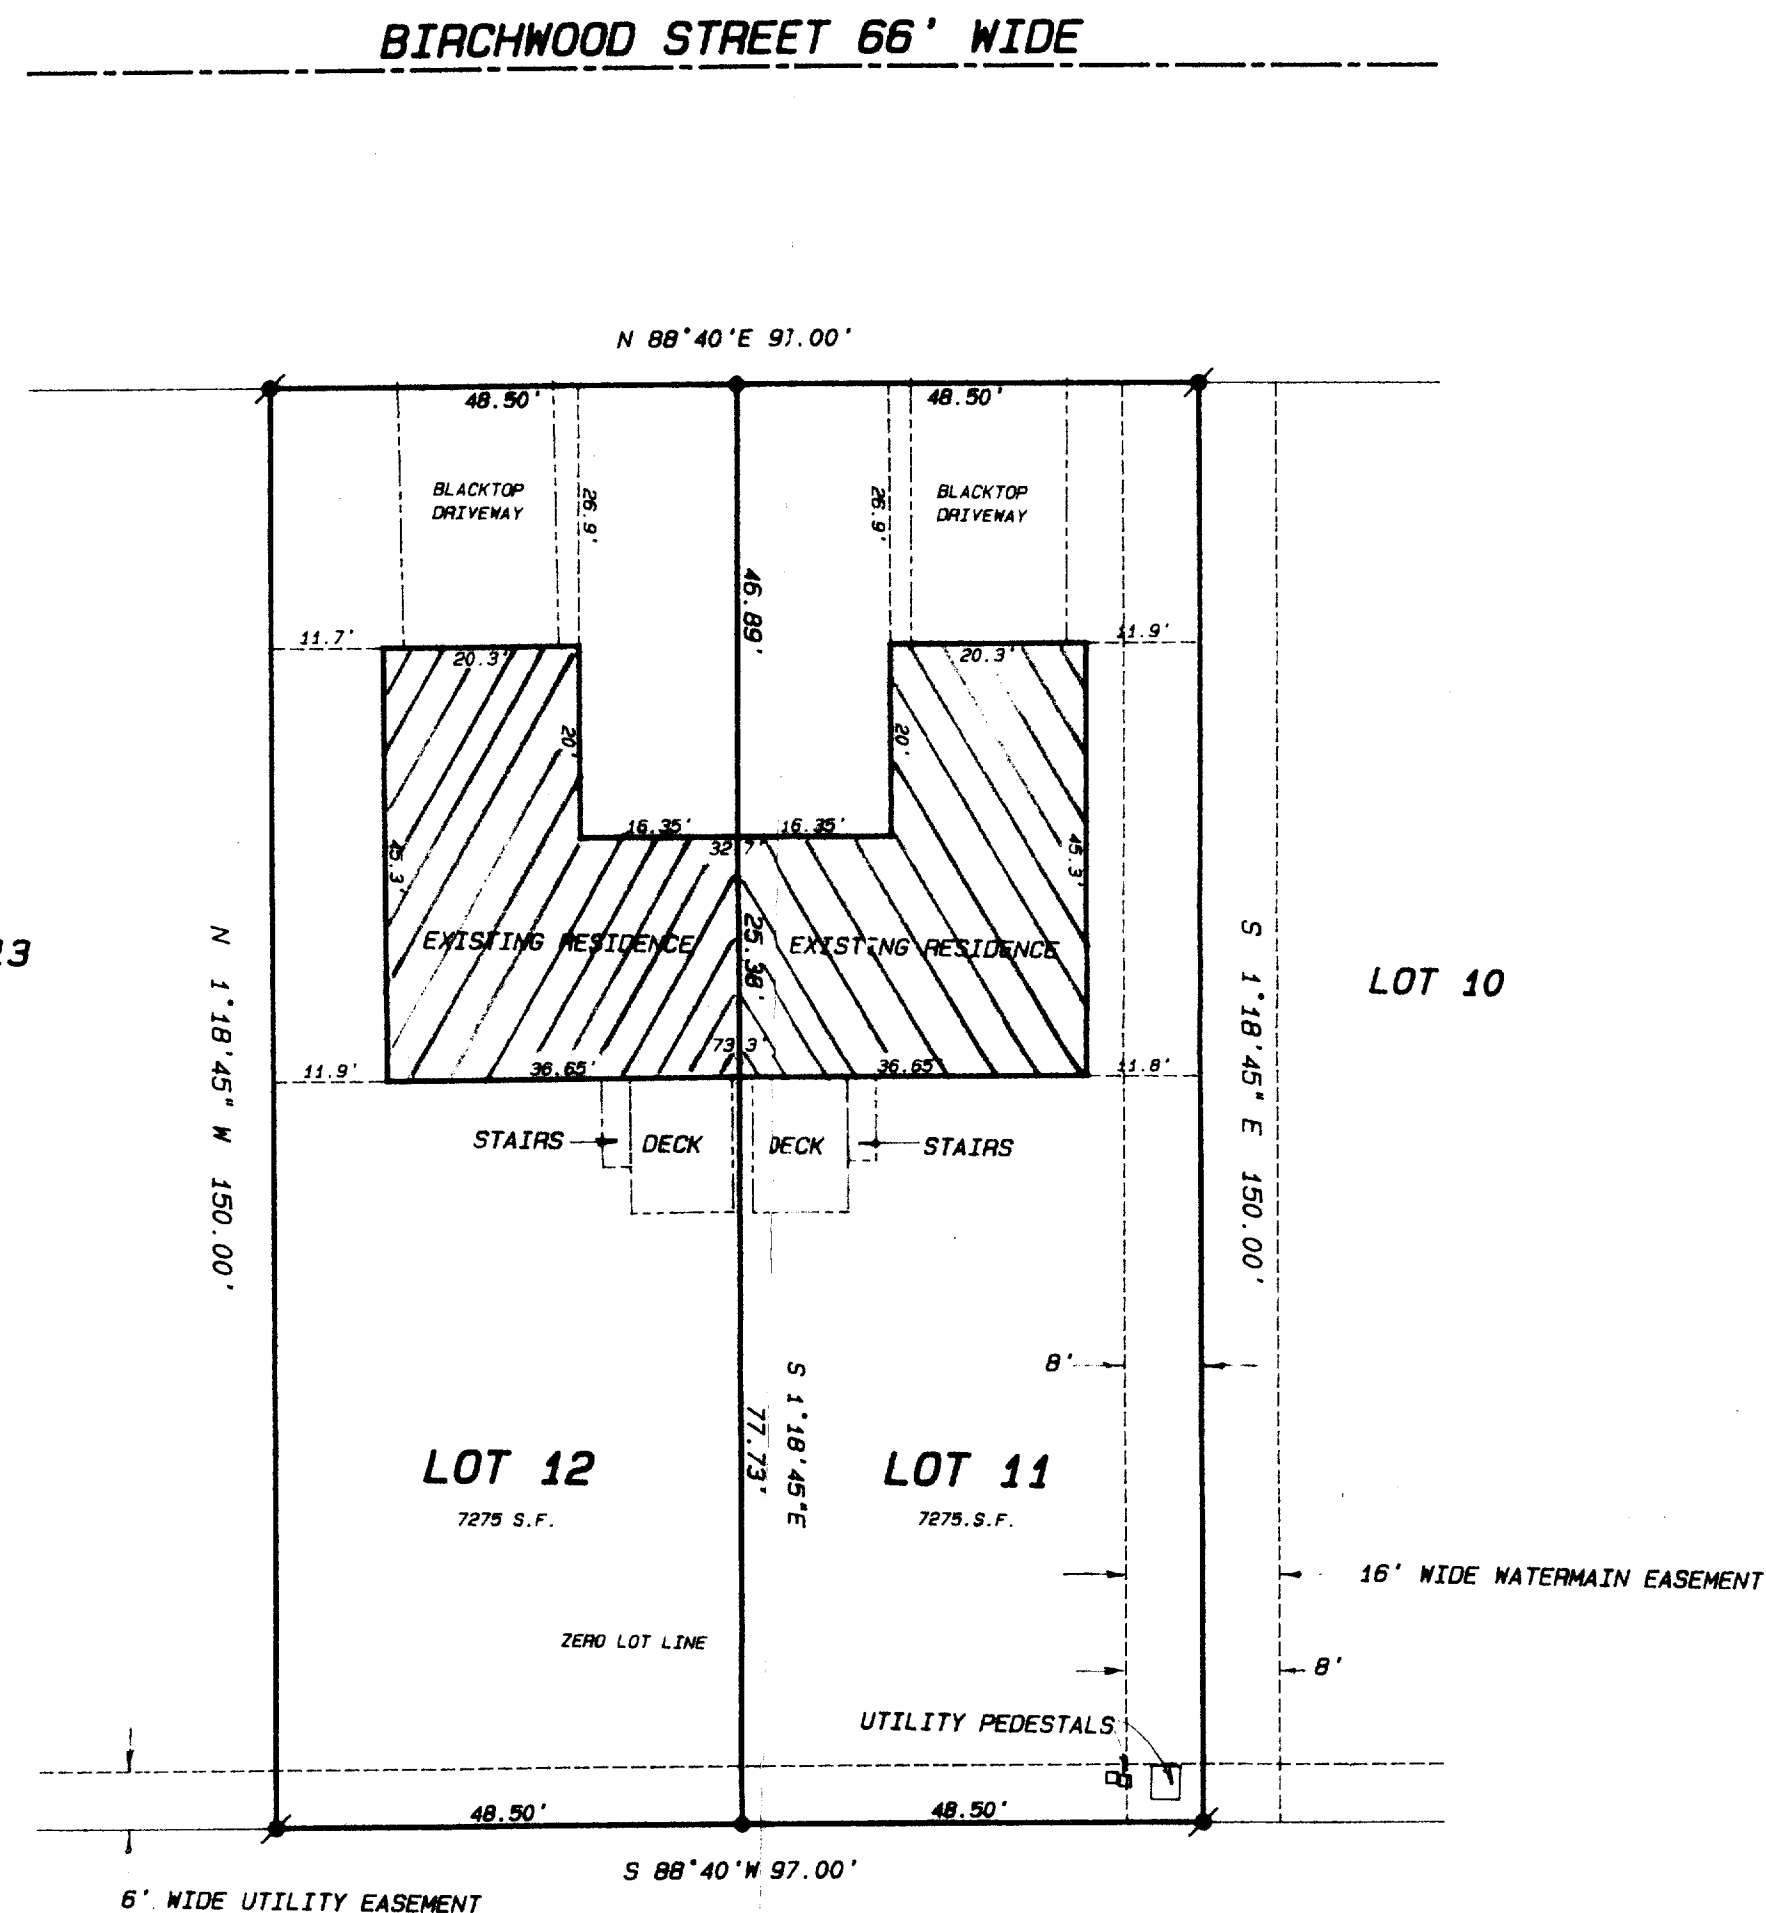


Legend

- FOUND IRON PIPE
- FOUND IRON ROD
- FOUND BRASS CAPPED MONUMENT
- FOUND CONCRETE MONUMENT
- CHISEL CUT IN CONCRETE
- SET IRON ROD, 24" LONG, WEIGHING 1.5 LBS./LINEAL FT., 3/4" DIA.
- SET IRON ROD, 30" LONG, WEIGHING 4.5 LBS./LINEAL FT., 1-11/16" DIA.
- (xx) RECORDED AS DIMENSION
- EXISTING FENCE

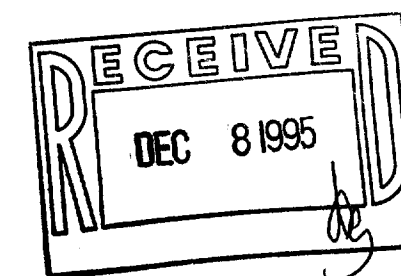

SCALE: 1"=20 FEET

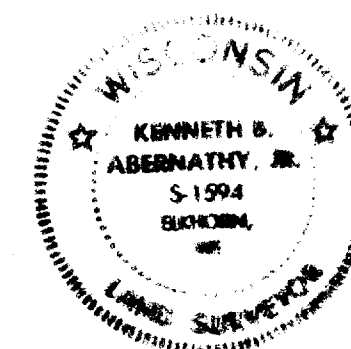

"I hereby certify that the above described property has been surveyed by me or under my direction and that the above map is a true representation thereof and shows the size and location of the property, its exterior boundaries, the location of all visible structures and dimensions of all principal buildings thereon, boundary fences, apparent easements, roadways and visible encroachments, if any."

"This survey is made for the use of the present owners of the property, and also those who purchase, mortgage, or guarantee the title thereto within one year from date hereof."

KENNETH B. ABERNATHY, JR.
WISCONSIN REGISTERED LAND SURVEYOR,
S-1594

Date: 8/23/95 Job No. 95.818

XCR-11
XCR-12

002-1472