



PLAT OF SURVEY  
LOT 30 BLOCK 4  
LAKE MEADOWS ADDITION NO. 1

WORK ORDERED BY: PREFERRED HOMES  
WILLIAM & JANE BOHN  
2903 BORG ROAD  
DELAN, WISCONSIN 53115




FARRIS, HANSEN & ASSOCIATES, INC.  
Engineering, Architecture, Surveying  
7 Ridgway Court P.O. Box 437  
ELKHORN, WISCONSIN 53121  
Office: (414) 723-2098  
Fax: (414) 723-5886

REVISIONS


PROJECT NO.  
3686.30  
DATE  
10/20/95  
SHEET NO.  
1 OF 1

## PLAT OF SURVEY

LOT 30 OF BLOCK 4 OF LAKE MEADOWS  
ADDITION NO. 1, LOCATED IN THE NE,  
SW & SE 1/4'S OF THE SE 1/4 OF  
SECTION 7, TOWN 2 NORTH, RANGE 16  
EAST, CITY OF DELAVAN, WALWORTH  
COUNTY, WISCONSIN

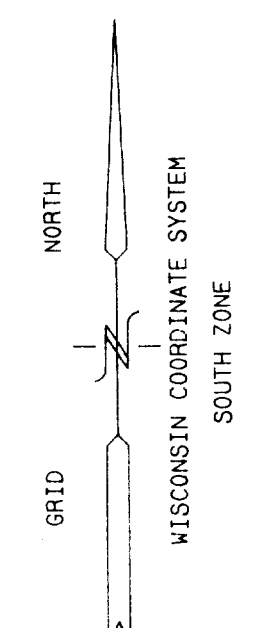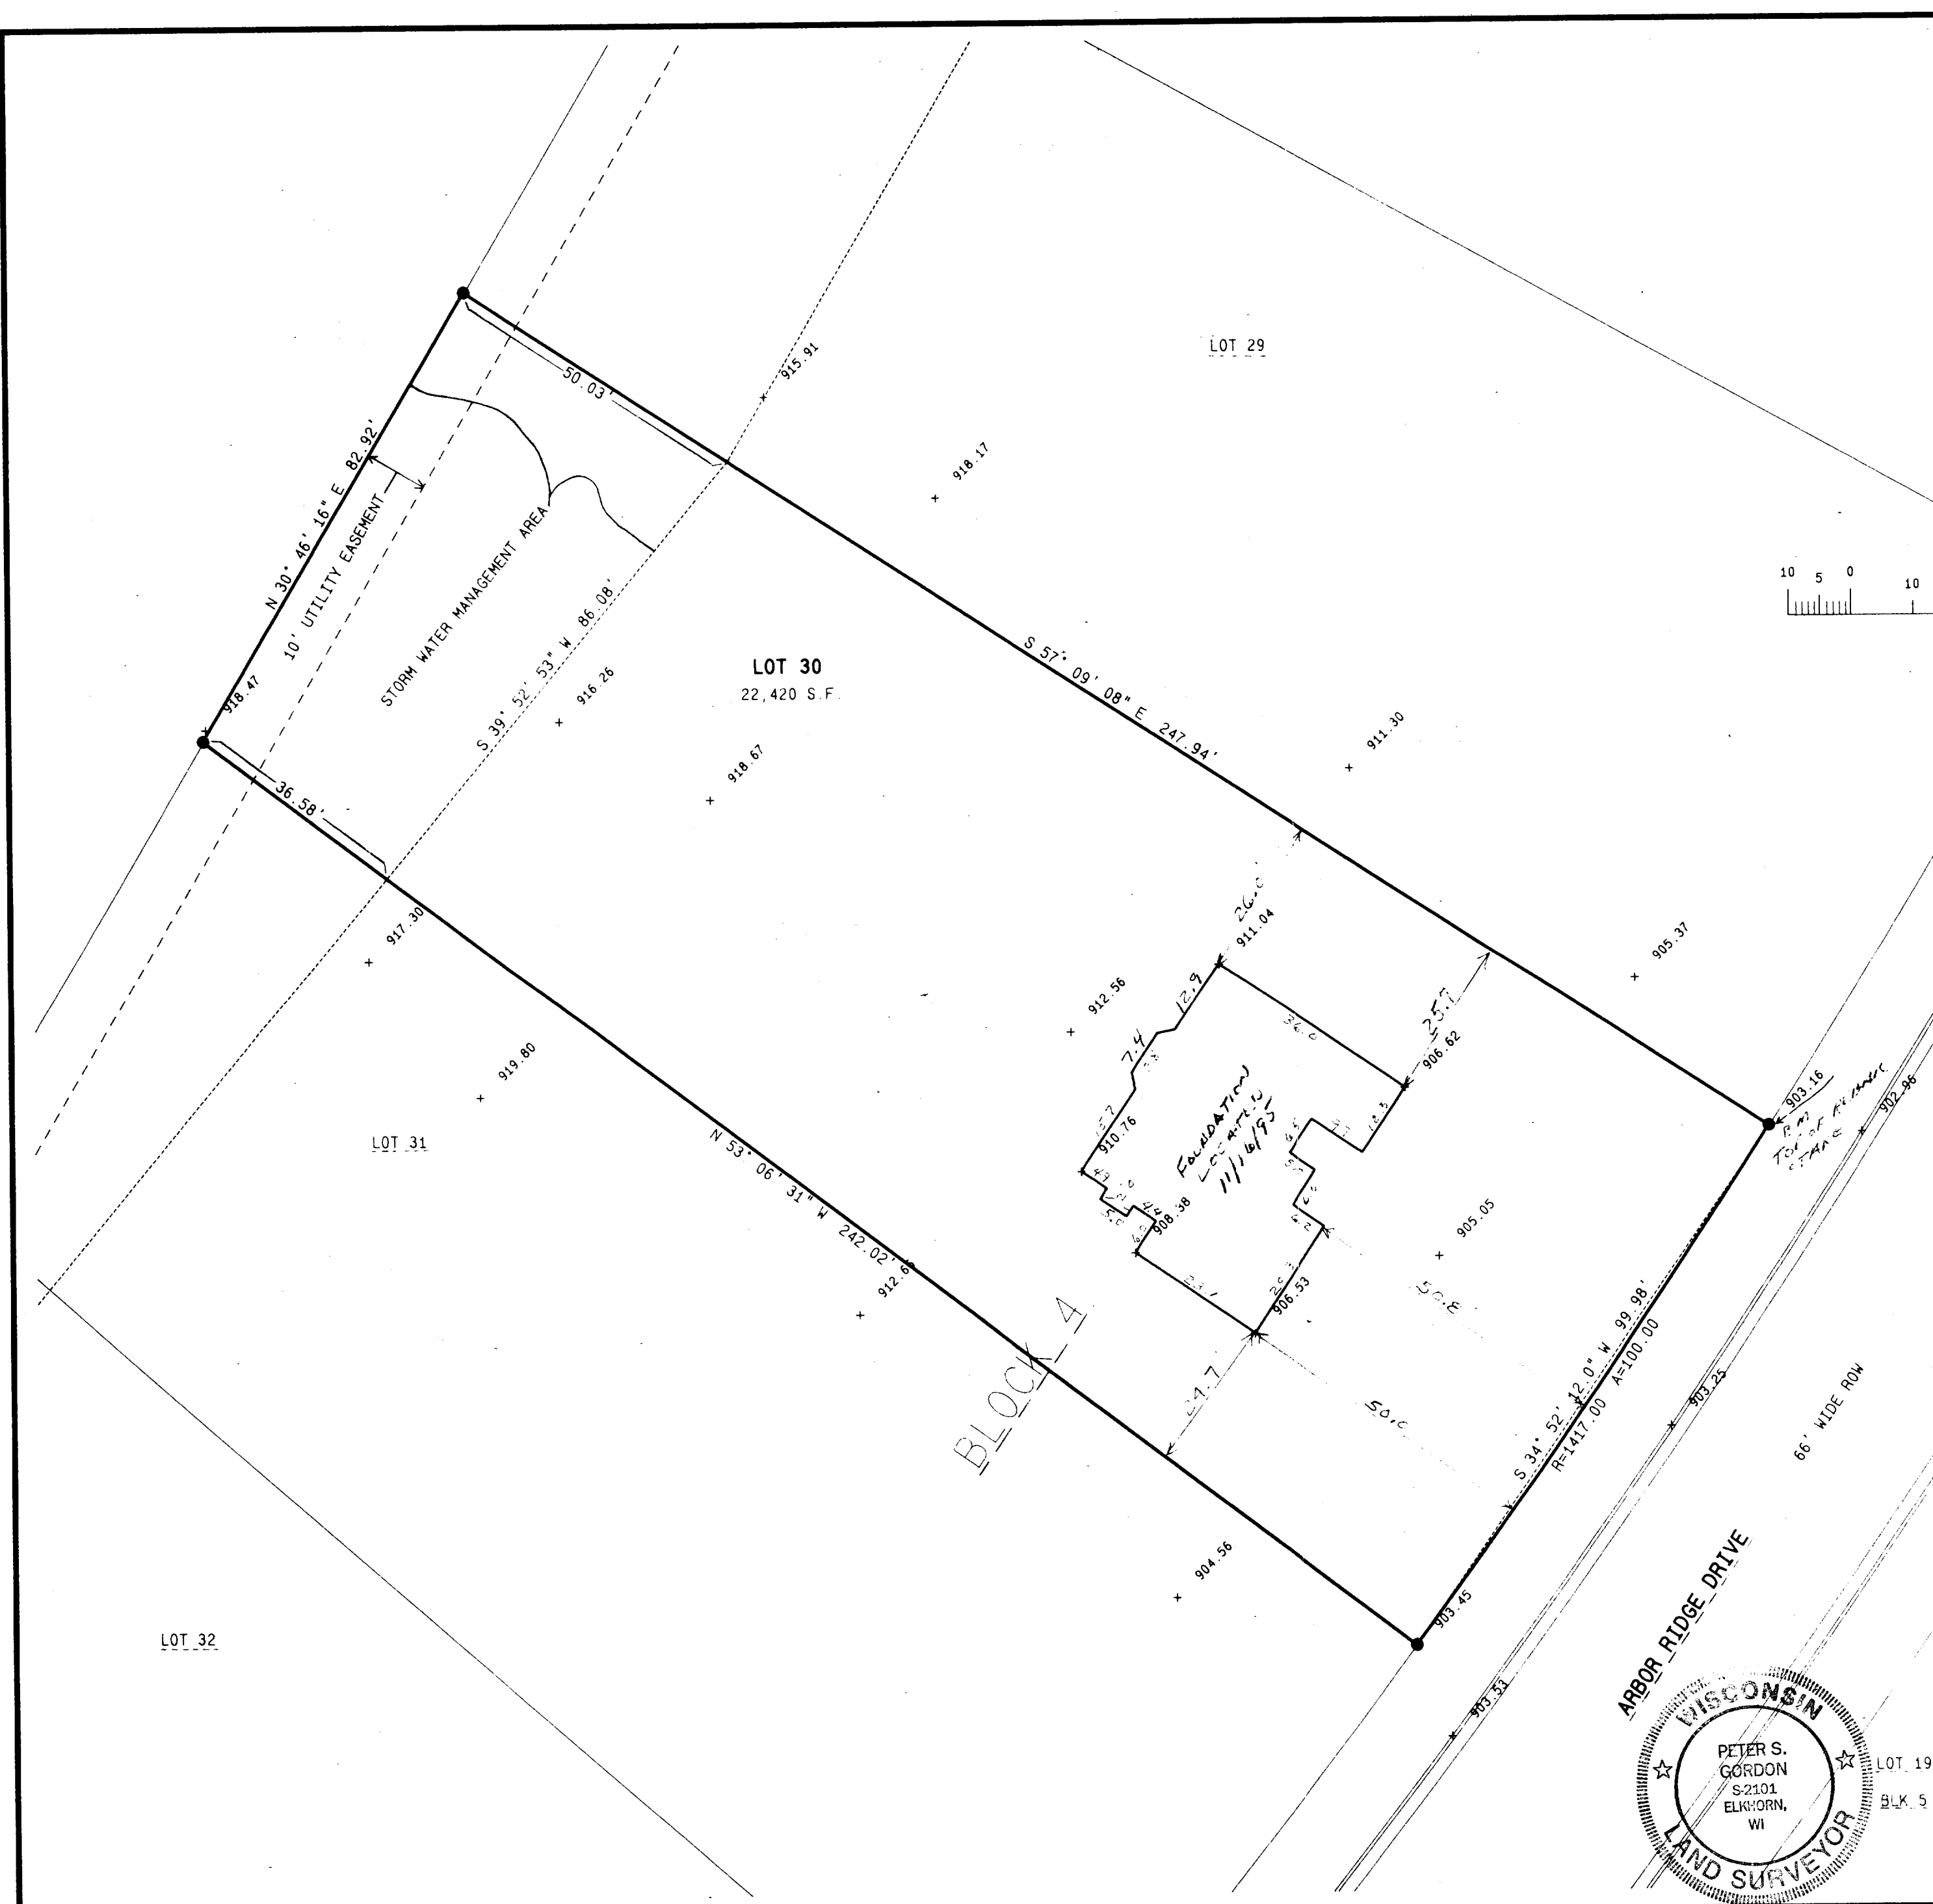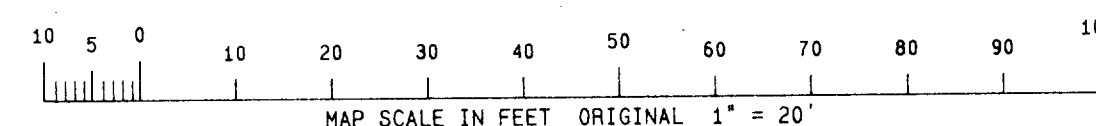

- LEGEND
- = SET IRON REBAR STAKE 3/4" DIA.
  - = FOUND IRON PIPE STAKE 1" DIA.
  - = FOUND IRON REBAR STAKE 3/4" DIA.
  - = FOUND CONCRETE COUNTY MONUMENT
  - = RECORDED AS

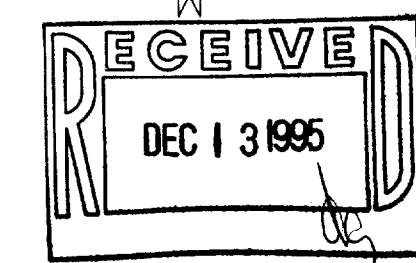


NOTE: COPIES OF THIS MAP TO WHICH THE FOLLOWING  
CERTIFICATE WILL APPLY ARE BLUE LINE PRINTS SHOWING  
SURVEYOR'S ORIGINAL SEAL AND SIGNATURE IN BLACK INK.  
COPIES BY ANY OTHER MEANS MAY HAVE ALTERATIONS WHICH DO  
NOT REPRESENT THE SURVEYOR'S WORK PRODUCT.

I HEREBY CERTIFY THAT THE ABOVE DESCRIBED PROPERTY HAS  
BEEN SURVEYED UNDER MY DIRECTION AND THAT THE ABOVE MAP IS  
A TRUE REPRESENTATION THEREOF AND SHOWS THE SIZE AND  
LOCATION OF THE PROPERTY AND ITS EXTERIOR BOUNDARIES.  
THIS SURVEY IS MADE FOR THE USE OF THE PRESENT OWNERS OF  
THE PROPERTY, AND ALSO THOSE WHO PURCHASE, MORTGAGE, OR  
GUARANTEE THE TITLE THERETO WITHIN ONE YEAR FROM THE DATE  
HEREOF

DATED: 10/23/95  
REVISOR: 11/16/95 TO SHOW SIZE + LOCATION OF  
FOUNDATION AS BUILT

*Peter S. Gordon*  
PETER S. GORDON R.L.S. 2101

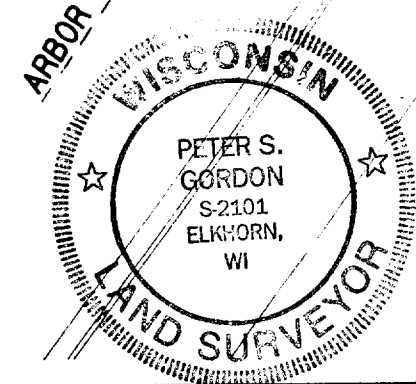

2  
XLM1-  
002-1476