
ABELL SURVEYING & MAPPING DELAVAN, WISCONSIN 53115 414-728-6737



ORDERED BY: HIBL'S REAL ESTATE SALES, INC. 10348 ANN STREET DELAVAN, WI 53115

PLAT OF SURVEY OF

LOT 73. TURTLE CREEK SUBDIVISION, LOCATED IN THE CITY OF DELAVAN, WALWORTH COUNTY, WISCONSIN.

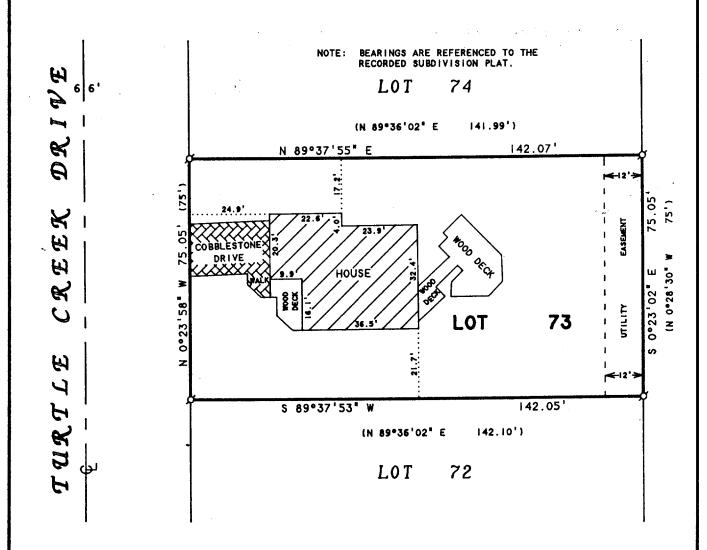



SCALE I"-30'
LEGEND

Ø -IRON PIPE FOUND
()-RECORDED AS

I HEREBY CERTIFY THAT I HAVE SURVEYED THE ABOVE DESCRIBED PROPERTY AND THAT THE ABOVE MAP IS A TRUE REPRESENTATION THEREOF AND SHOWS THE SIZE AND LOCATION OF THE PROPERTY, ITS EXTERIOR BOUNDARIES, THE LOCATION OF ALL VISIBLE STRUCTURES AND DIMENSIONS OF ALL PRINCIPAL BUILDINGS THEREON, BOUNDARY FENCES, APPARENT EASEMENTS, ROADWAYS AND VISIBLE ENCROACHMENTS, IF ANY, TO THE BEST OF MY KNOWLEDGE AND BELIEF.

THIS SURVEY IS MADE FOR THE USE OF THE PRESENT OWNERS OF THE PROPERTY, AND ALSO THOSE WHO PURCHASE, MORTGAGE, OR GUARANTEE THE TITLE THERETO WITHIN ONE (1) YEAR FROM DATE HEREON.

Lind 7. Sell

DAVID F. ABELL MISCONSIN REGISTERED LAND SURVEYOR, S-1596

July 12, 1996

0EC - 5 1996

TE JOB NUMBER ...
TE: THIS IS NOT A CERTIFIED COPY UNLESS SEALED.