


BARNES

STREET

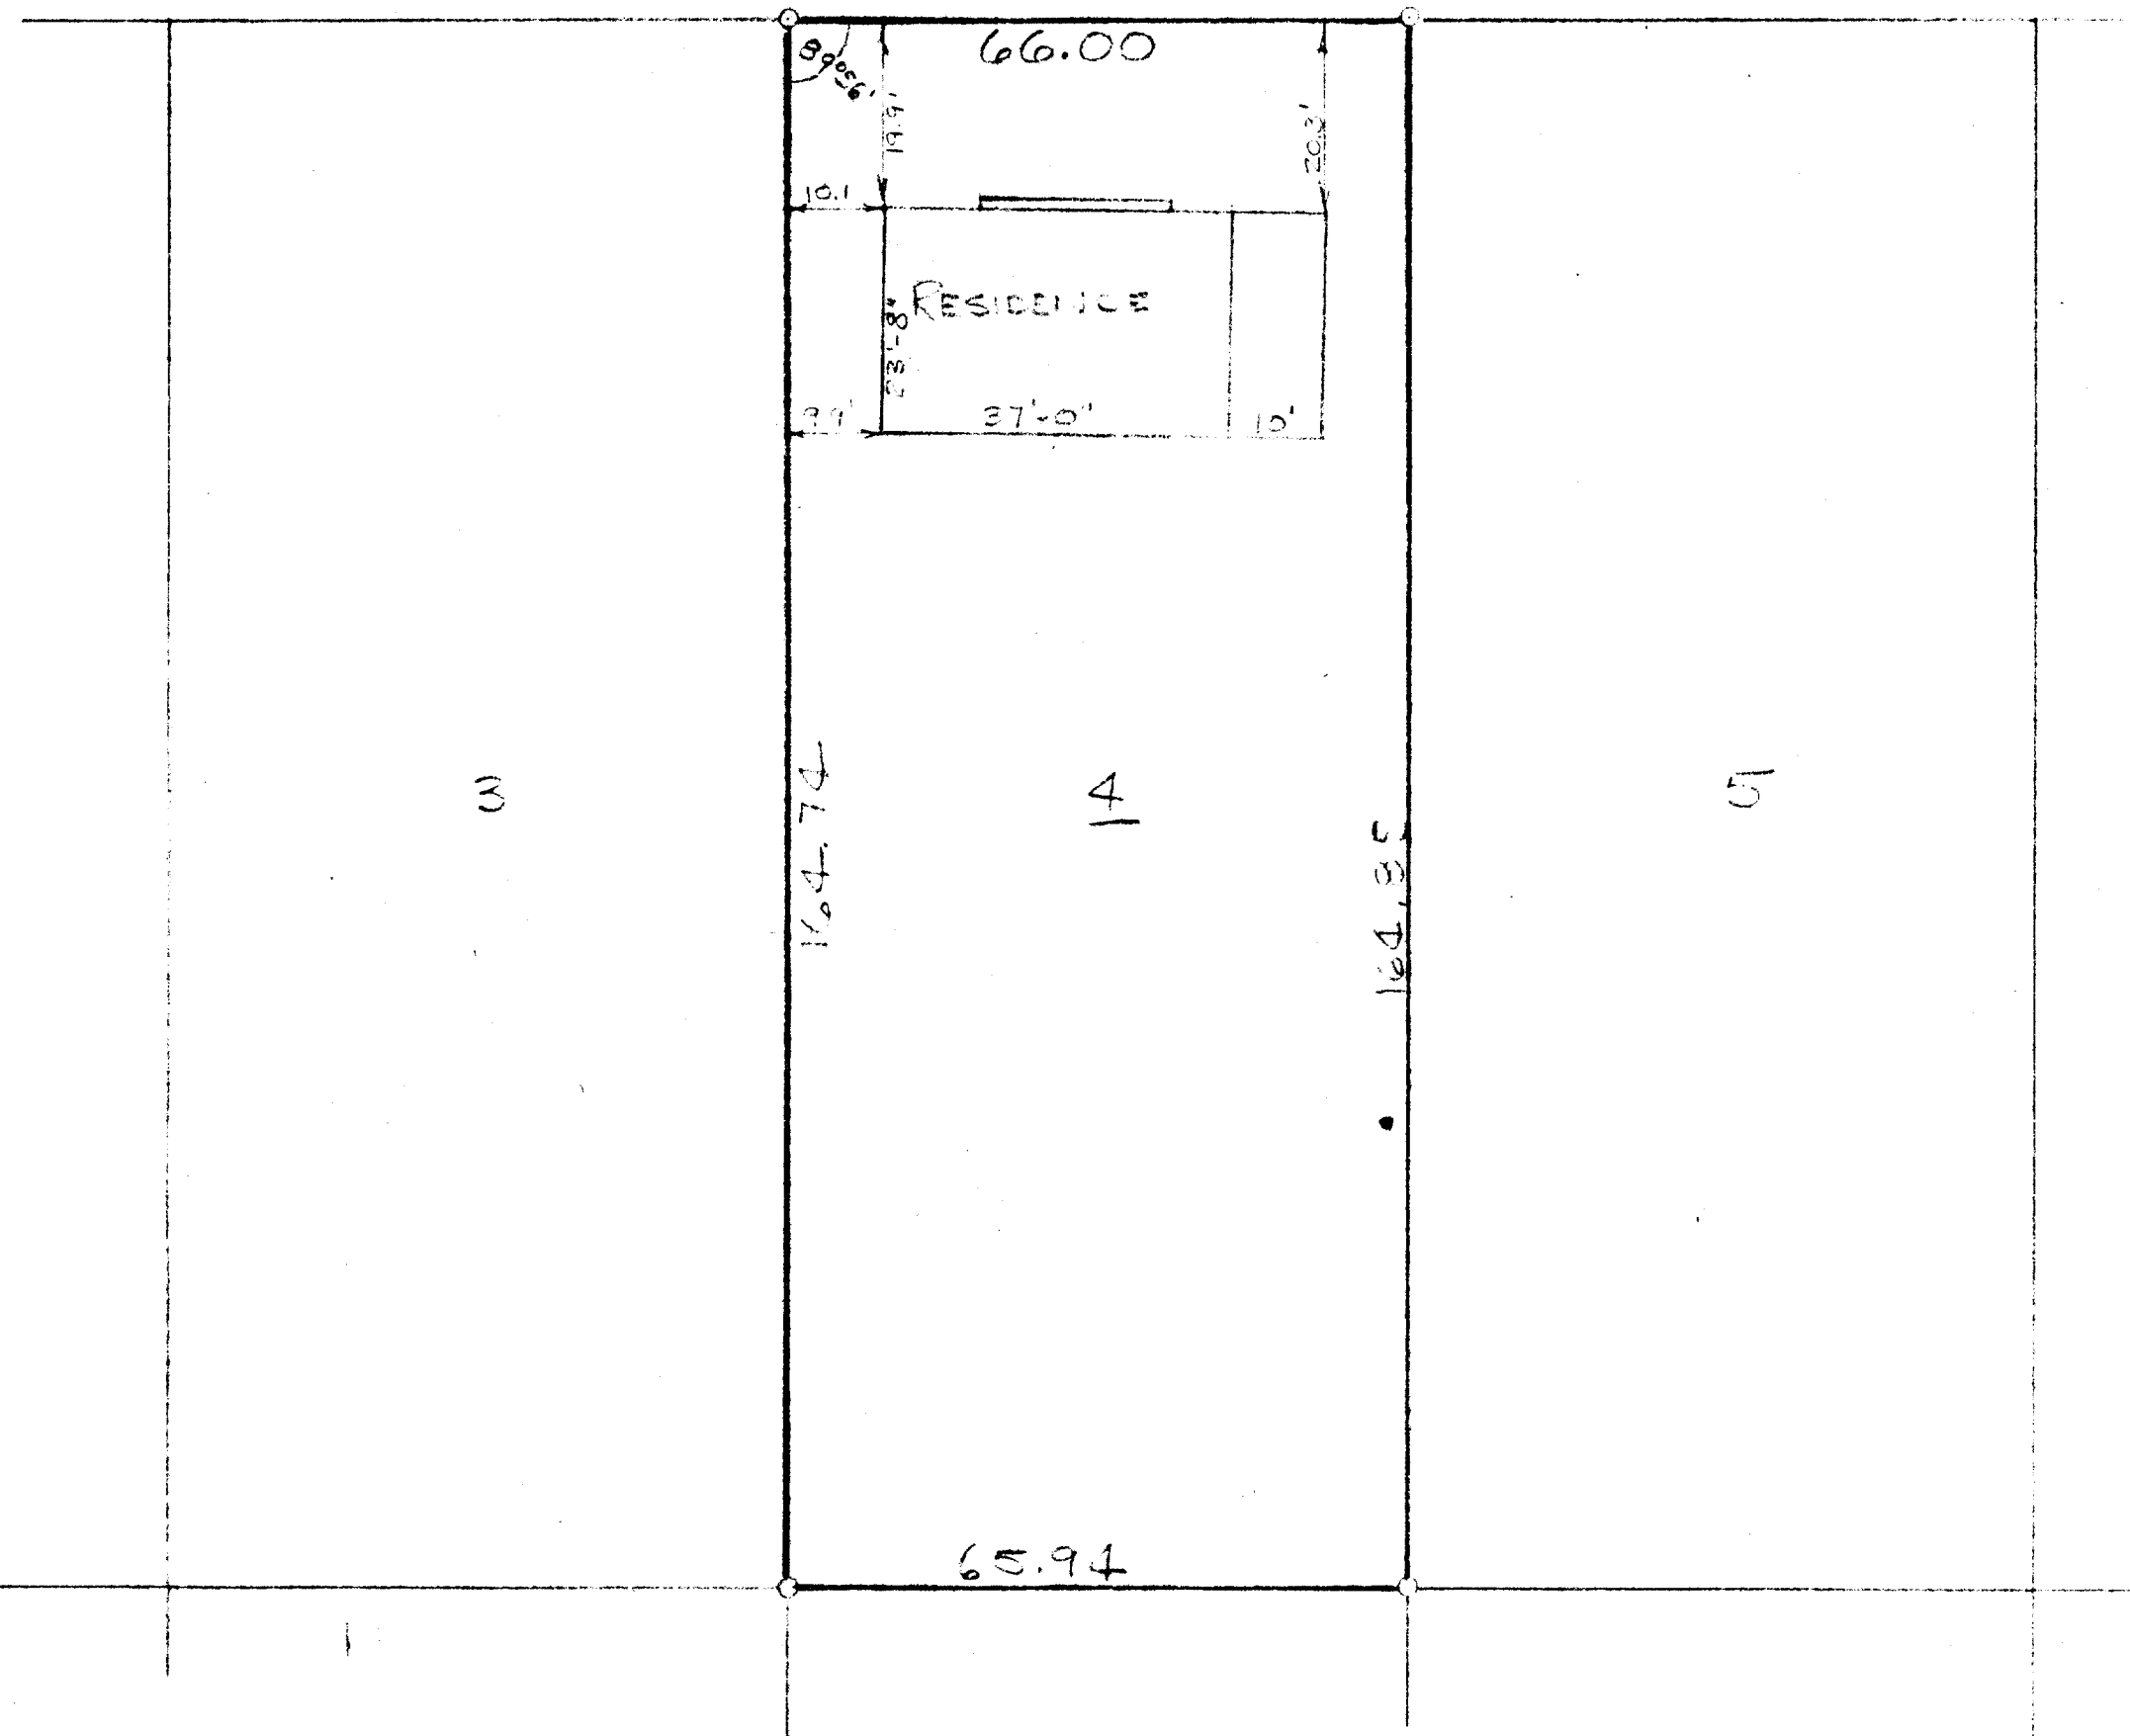

SCALE 1"=20'
OF IRON PIPE

STATE OF WISCONSIN)
COUNTY OF WALWORTH) ss

I, LLOYD L. JENSEN, DO HEREBY CERTIFY THAT I HAVE
SURVEYED THE PROPERTY DESCRIBED, ACCORDING TO THE
OFFICIAL RECORDS, AS FOLLOWS:

LOT 4 OF BLOCK 3 OF THE ELMHURST ADDITION
TO THE CITY OF DELAVAN, WALWORTH COUNTY, WISCONSIN;
AND THAT THE PLAT ABOVE IS A CORRECT REPRESENTATION
OF THE LOT LINES AND PRINCIPAL LINES OF BUILDINGS THEREON.

ELKHORN, WISCONSIN, SEPTEMBER 14, 1950

Lloyd L. Jensen
COUNTY SURVEYOR

2-15 J

VEA-22