



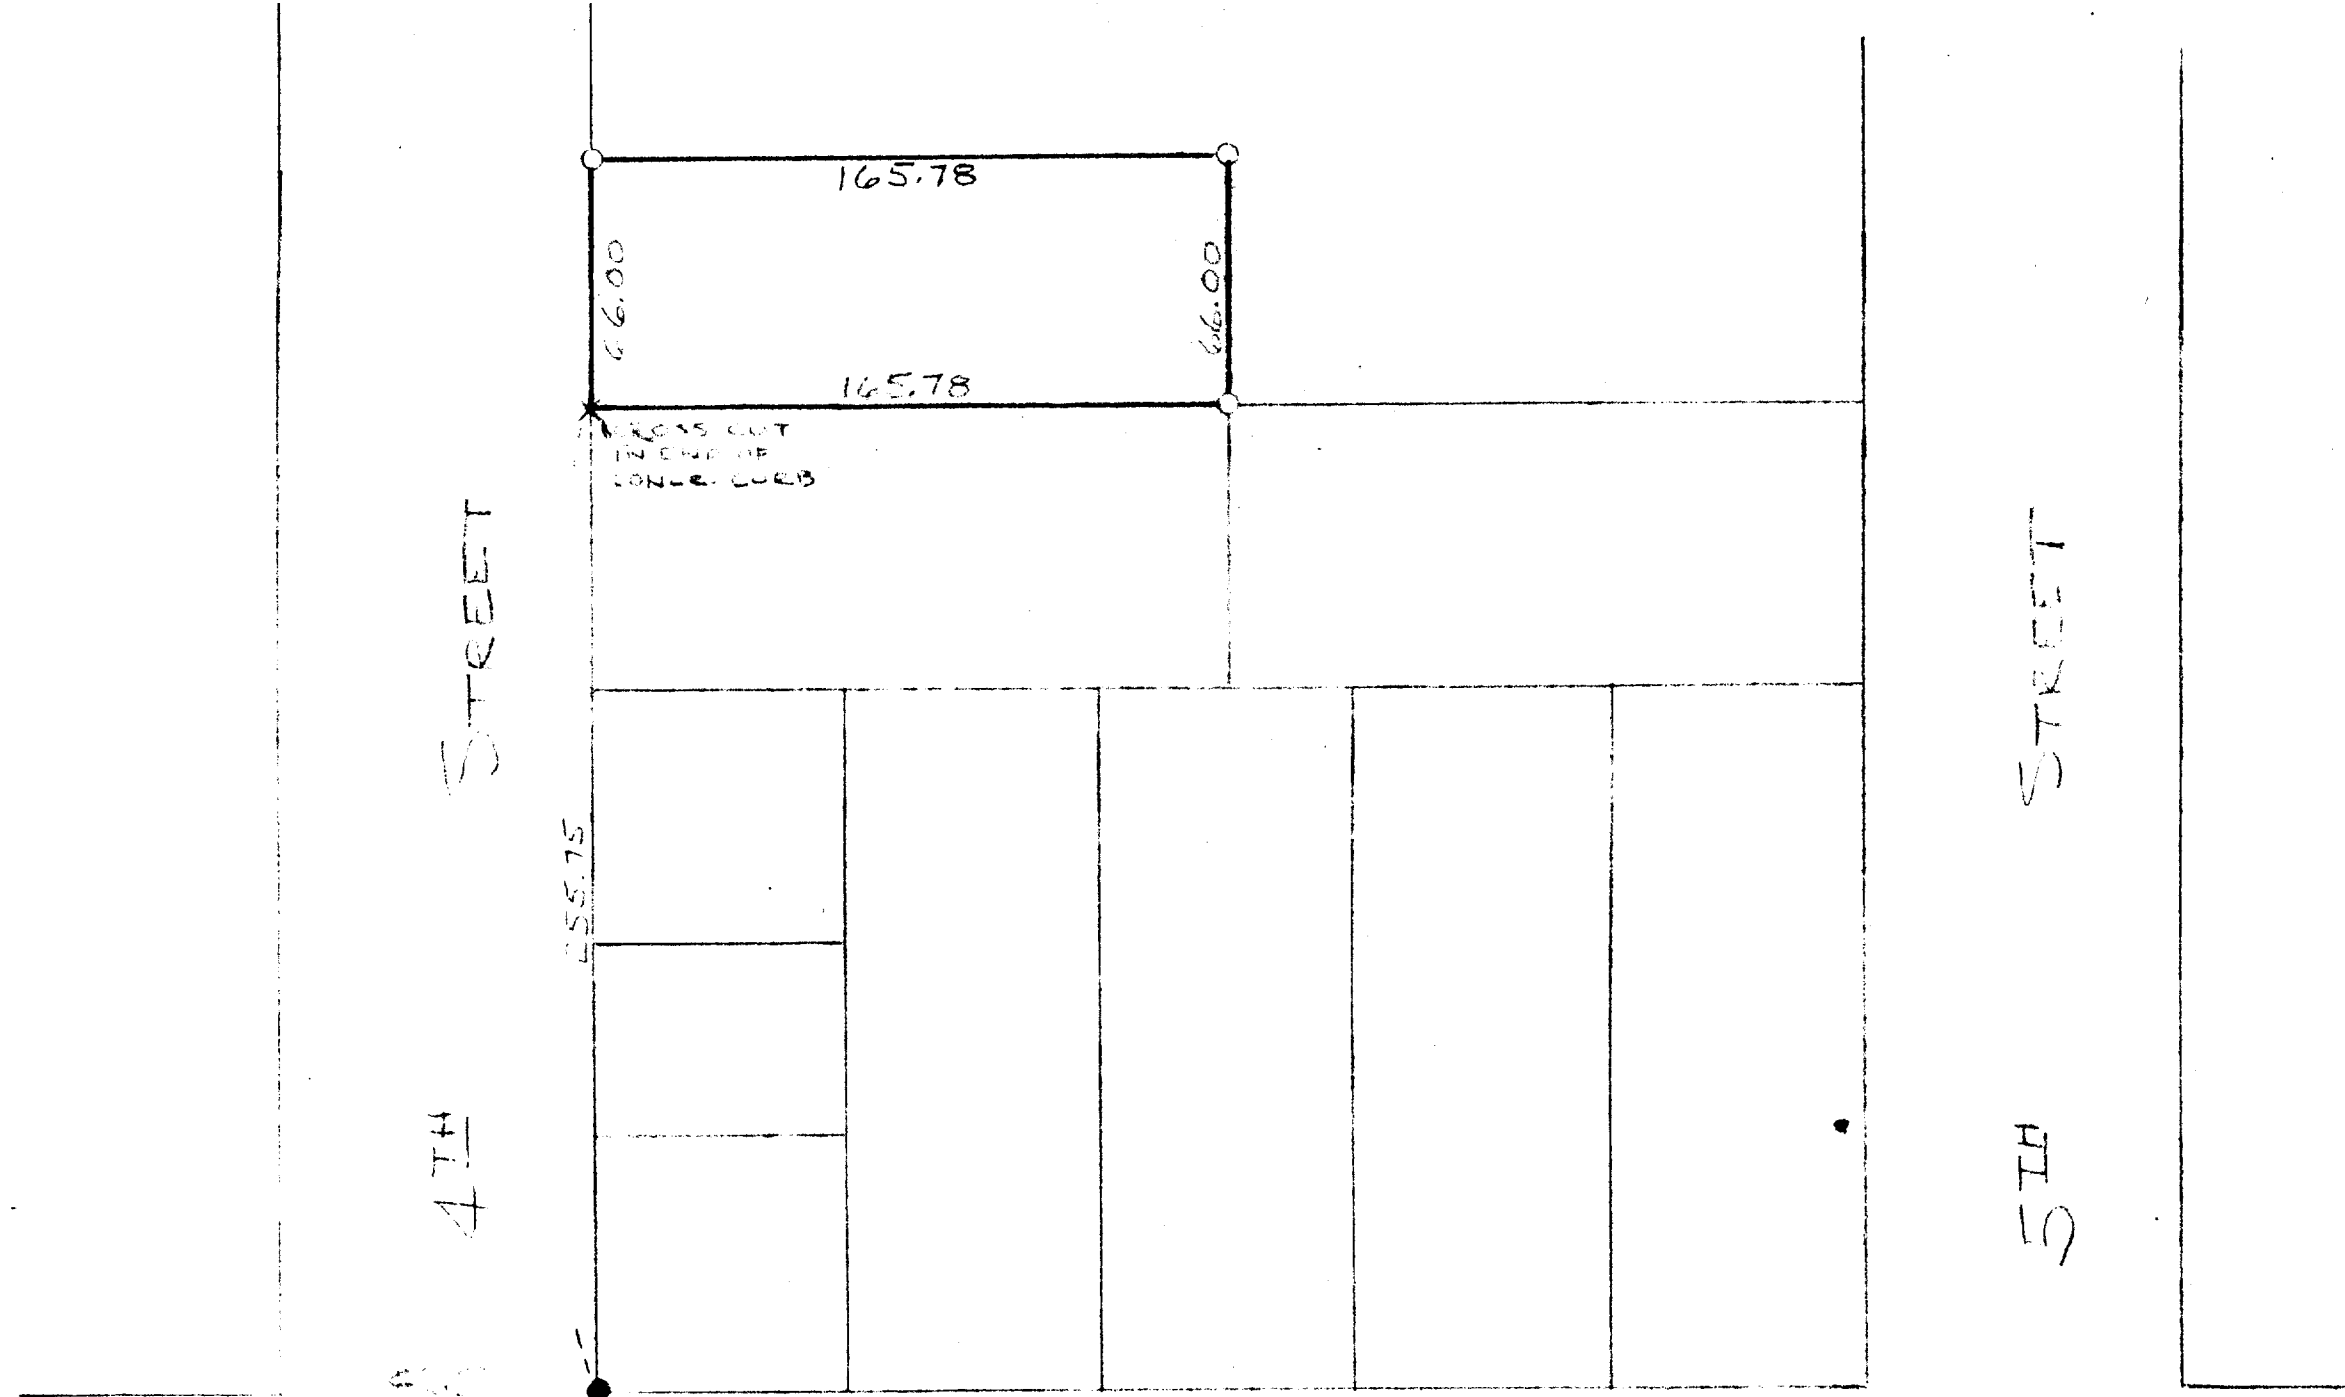

Mc DOWELL

STREET

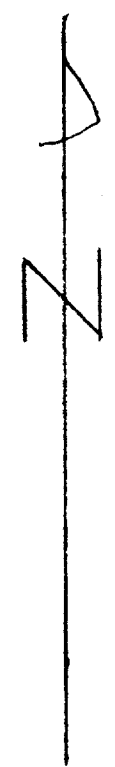

PLAT OF SURVEY OF LAND LOCATED IN THE
NORTHEAST QUARTER OF SECTION 18, T2N R16E,
IN THE CITY OF DELAVAN, WALWORTH COUNTY,
WISCONSIN.

OCT. 1950

Harold L. Jensen
COUNTY SURVEYOR

SCALE 1" = 50'
O = IRON PIPE
● = CONCR. MONU. xup-80A

2-16J