


DEGEN, FOAT SURVEYING ASSOCIATES

100 SOUTH SECOND STREET
WATERFORD, WISCONSIN
(414)534-5404 (FAX)534-2022

993222
993222S1.DWG

PLAT OF SURVEY


LOT 12 AND THE SOUTH 1/2 OF LOT 11, BLOCK 2, FAIRVIEW HEIGHTS,
A SUBDIVISION LOCATED IN THE CITY OF DELAVAN, WALWORTH COUNTY,
WISCONSIN.

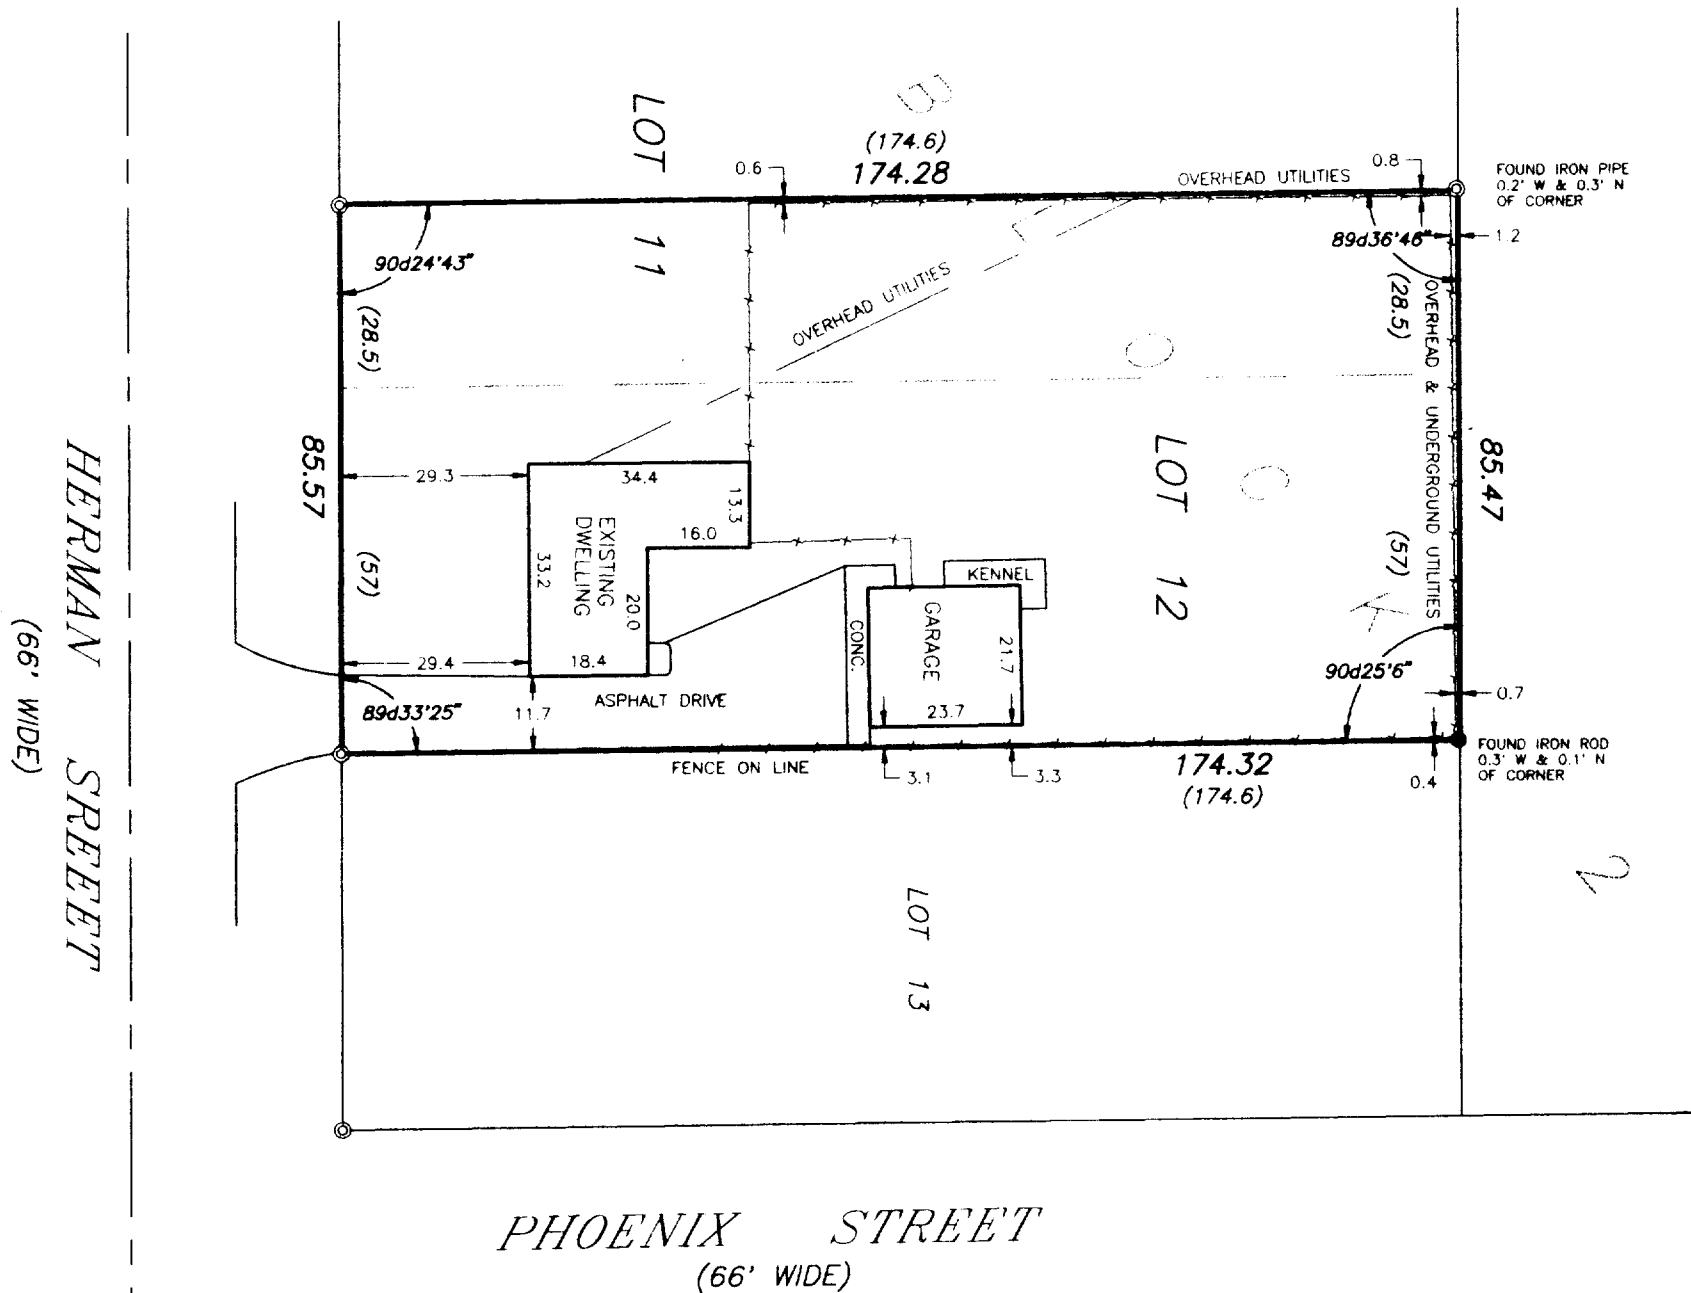

LEGEND

- ⊙ - FOUND IRON PIPE
- - FOUND IRON ROD
- - SET IRON PIPE
- - CHAIN LINK FENCE
- () - RECORDED AS
- ⚡ - UTILITY POLE

SURVEY ORDERED BY: VICKIE PEIFFER
CENTURY 21 - ZENK REALTY
112 ELIZABETH LANE
GENOA CITY, WI 53128

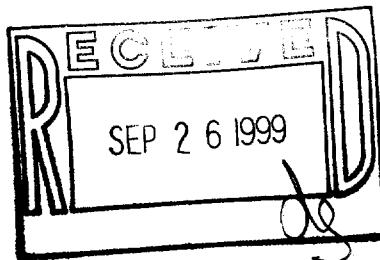

SCALE: 1" = 30'

I HEREBY CERTIFY THAT I HAVE SURVEYED THE ABOVE DESCRIBED PROPERTY AND THE ABOVE MAP IS A TRUE REPRESENTATION THEREOF AND SHOWS THE SIZE AND LOCATION OF THE PROPERTY, THE LOCATION OF ALL VISIBLE STRUCTURES AND DIMENSIONS OF ALL PRINCIPAL BUILDINGS THEREON, BOUNDARY FENCES, APPARENT EASEMENTS, ROADWAY AND VISIBLE ENCROACHMENTS, IF ANY.

THIS SURVEY IS MADE FOR THE PRESENT OWNERS OF THE PROPERTY, AND ALSO THOSE WHO PURCHASE, OR GUARANTEE THE TITLE THERETO WITHIN (1) YEAR FROM THE DATE HEREOF

DATED AT WATERFORD THIS 13TH DAY OF JULY 1999

RECERTIFIED

Gary B. Foat

002-1785
XF4-15