

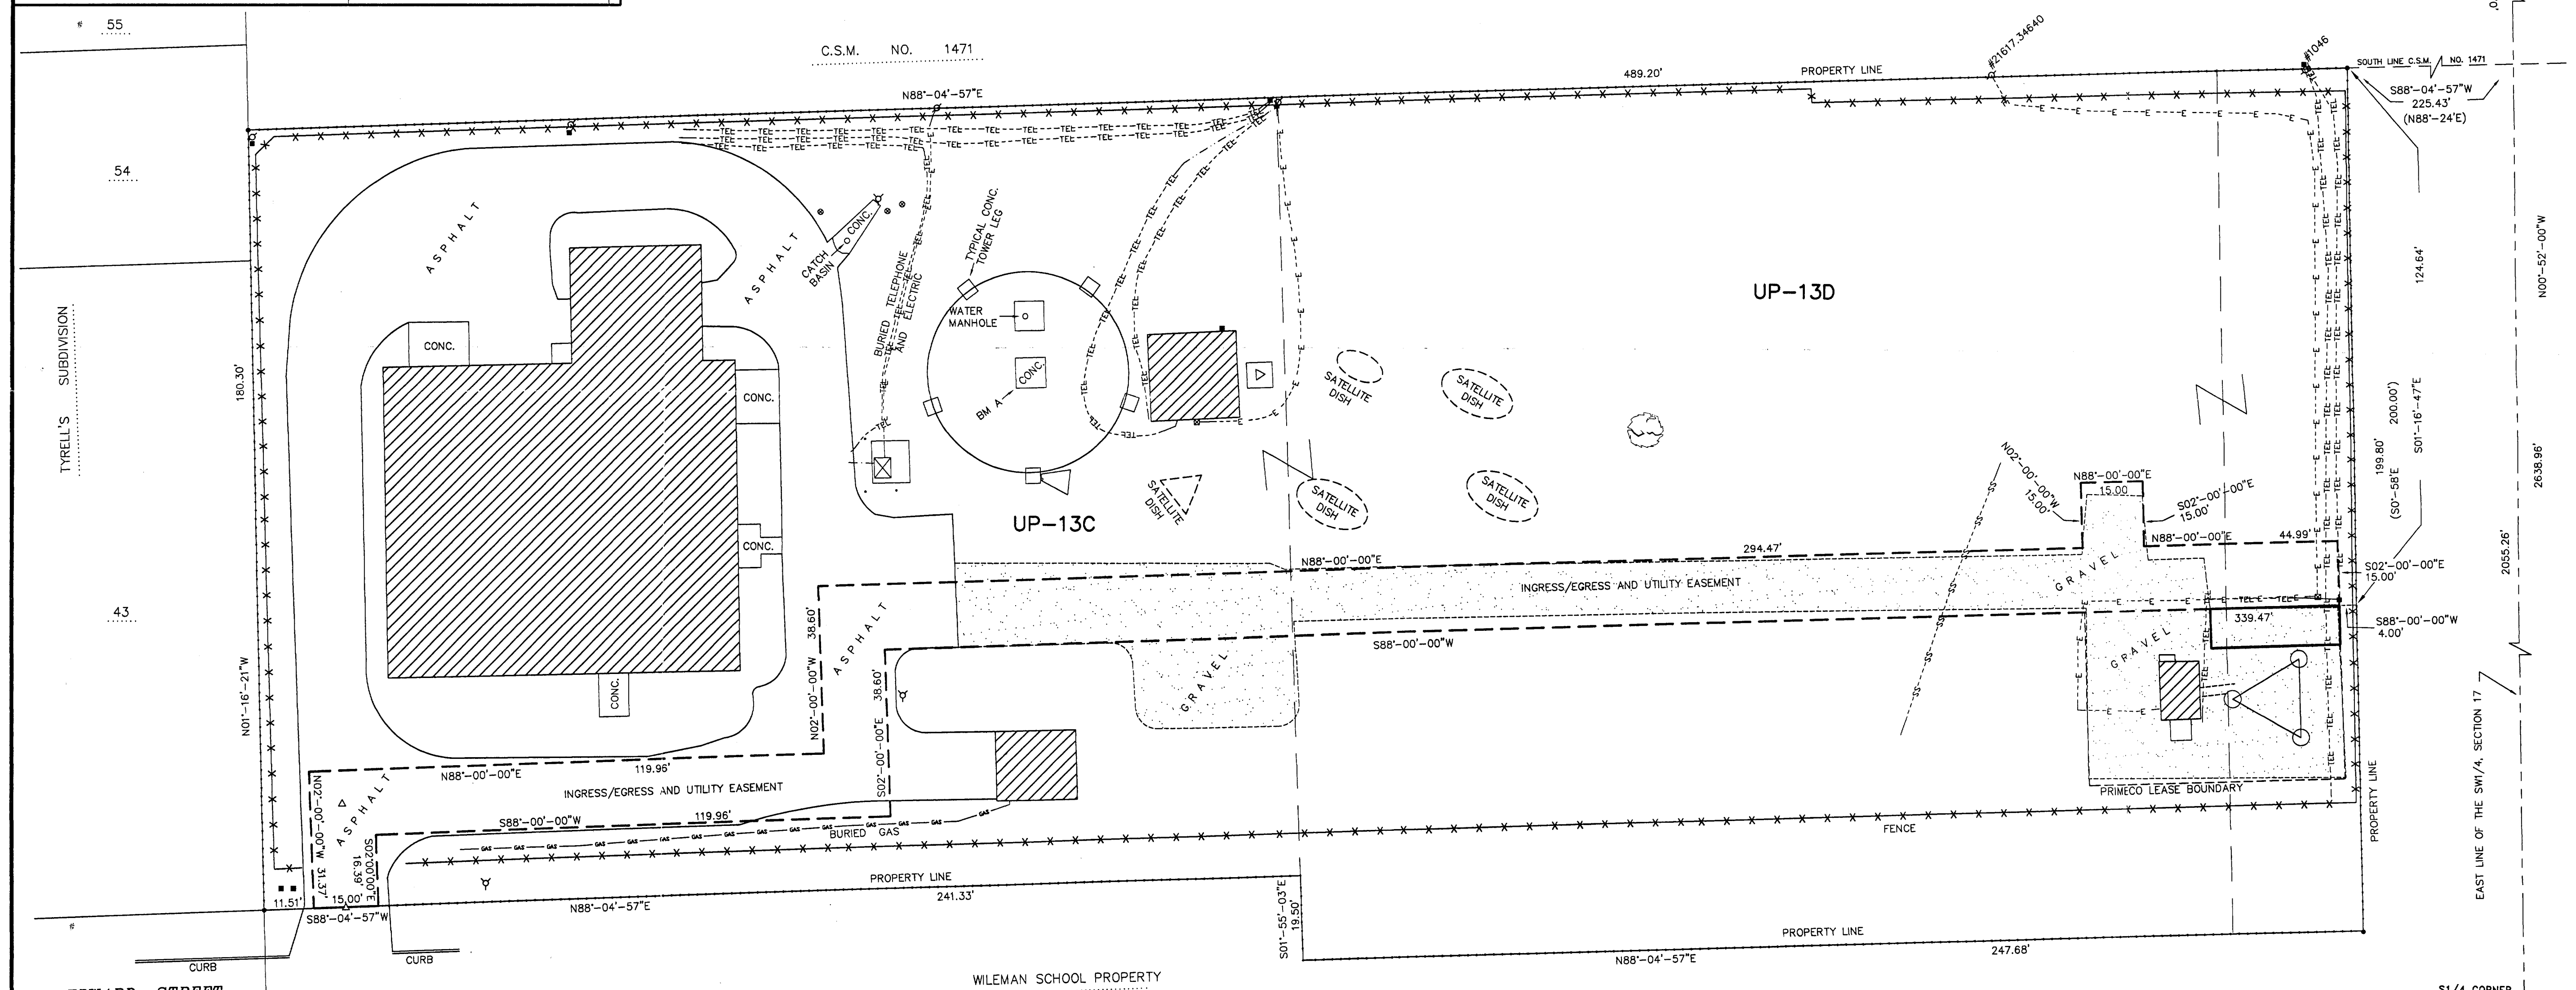
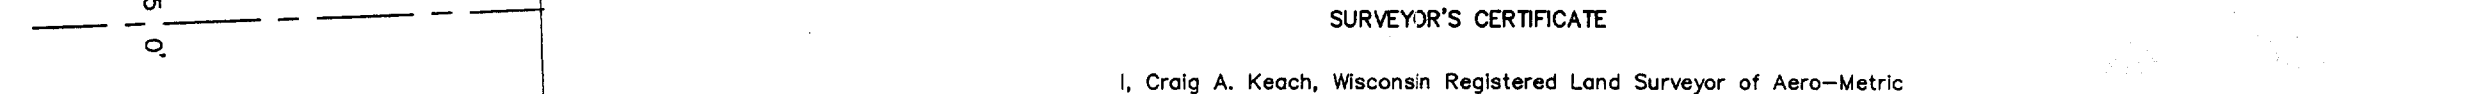
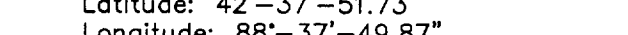


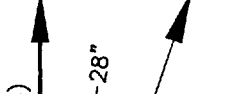

EDWARD STREET 		- TOWER BASE - Latitude: 42°-37'-51.73" Longitude: 88°-37'-49.87" (Per North American Datum of 1983/91) Elevation: 939.8' Top of Tower Elevation: 1119.7' Top of Antenna Elevation: 1122.9' Bottom of Antenna Elevation: 1116.7' (Per National Geodetic Vertical Datum of 1929) SCALE: 1" = 20' 		BEARINGS REFERENCED TO THE WISCONSIN STATE PLANE COORDINATE SYSTEM - SOUTH ZONE 	
SURVEYOR'S CERTIFICATE I, Craig A. Keach, Wisconsin Registered Land Surveyor of Aero-Metric Incorporated, certify that I have surveyed the above property and that the map shown to the left is a true and accurate representation thereof to the best of my knowledge and belief. ALSO I, Craig A. Keach, Wisconsin Registered Land Surveyor of Aero-Metric, Inc., certify that I have surveyed the described property and that the map shown is a true and accurate representation thereof to the best of my knowledge and belief. Dated this <u>16th</u> day of <u>OCTOBER</u>, 2000.  WISCONSIN REGISTERED LAND SURVEYOR Craig A. Keach, S-2333 Only if the surveyor's signature or stamp is in RED is this an original copy. Anything other than an original copy may contain unauthorized alterations to the original. The surveyor accepts no responsibility for non-original copies of this document.		PROJECT: CITY OF DELAVAN WT ML33XC023A PROPERTY OWNER: CITY OF DELAVAN 123 S. SECOND STREET DELAVAN, WI 53115 PROPERTY ADDRESS: 1111 EDWARDS STREET TAX KEY NO. XWUP 00013C & XWUP 000.13D SURVEYED FOR: SPRINT PCS 9801 W. HIGGINS ROAD SUITE 340 ROSEMONT, ILLINOIS 60018 TOWER OWNER: VERIZON WIRELESS 700 WEST VIRGINIA STREET SUITE 300 MILWAUKEE, WI 53204 414-390-5200			

XWUP-13C
XWUP-13D

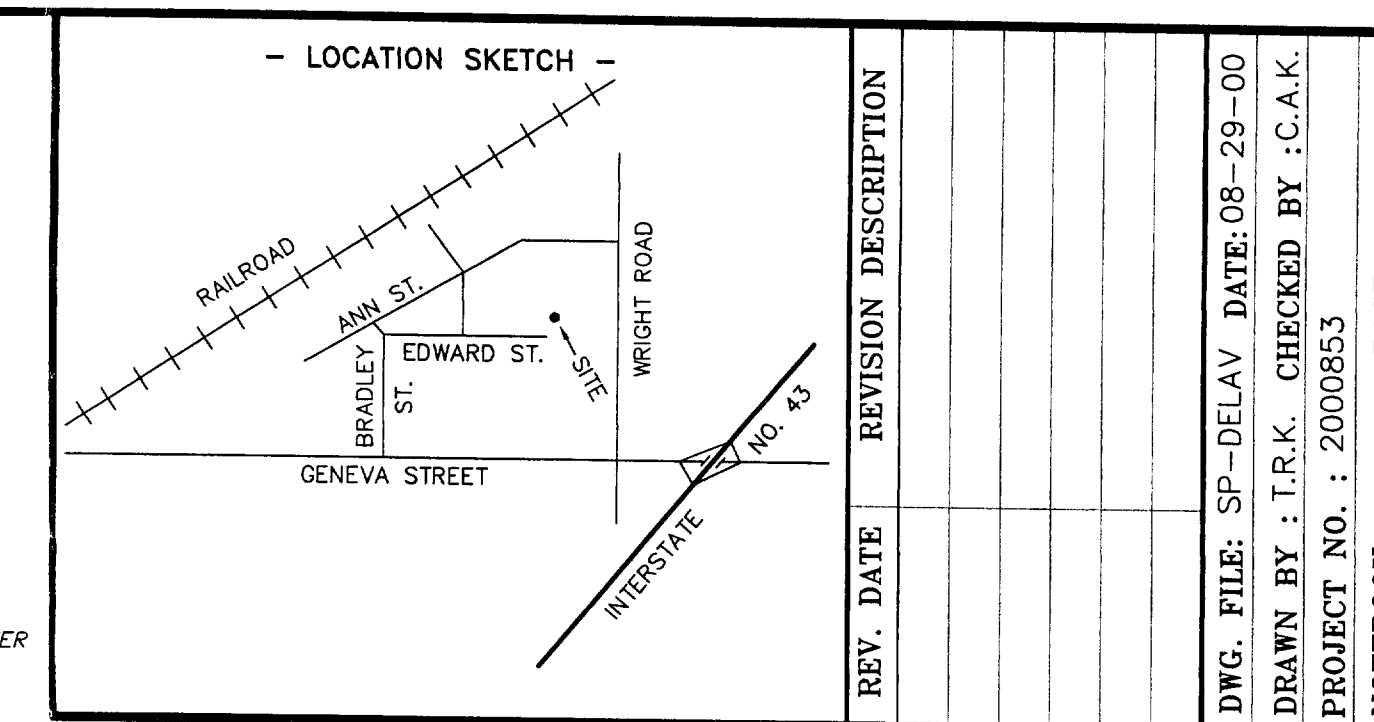

 **AERO-METRIC**
Aero-Metric, Incorporated
Land Planning & Design Division
920-849-7708 800-472-5313 FAX (949-7709)

SITE SURVEY
FOR
SPRINT PCS
A PART OF THE NE 1/4 OF THE SW 1/4,
SECTION 17, T.2N., R.16E., CITY OF
DELANAY, WALWORTH COUNTY, WISCONSIN



SHEET NO
1 OF 1

FILE NO.
K-837

SPRINT PCS
SITE NO.
MI 33XC023