

PLAT OF SURVEY  
LOT 39 BLOCK 12  
LAKE MEADOWS ADDITION NO. 4

WORK ORDERED BY -  
WILLIAM BOHN  
2903 BORG ROAD  
DELEVAN, WISCONSIN 53115



FARRIS, HANSEN & ASSOCIATES, INC.  
Engineering, Architecture, Surveying  
7 Ridgway Court P.O. Box 437  
ELKHORN, WISCONSIN 53121  
Office: (262) 723-2098  
Fax: (262) 723-5856

REVISIONS

PROJECT NO.  
3686.39.12  
DATE:  
07-26-01  
SHEET NO.  
1 OF 1

# PLAT OF SURVEY

LOT 39 OF BLOCK 12 OF LAKE MEADOWS  
ADDITION NO. 4, LOCATED IN THE SW  
1/4 OF THE SE 1/4 OF SECTION 7,  
TOWN 2 NORTH, RANGE 16 EAST, CITY  
OF DELEVAN, WALWORTH COUNTY, WISCONSIN

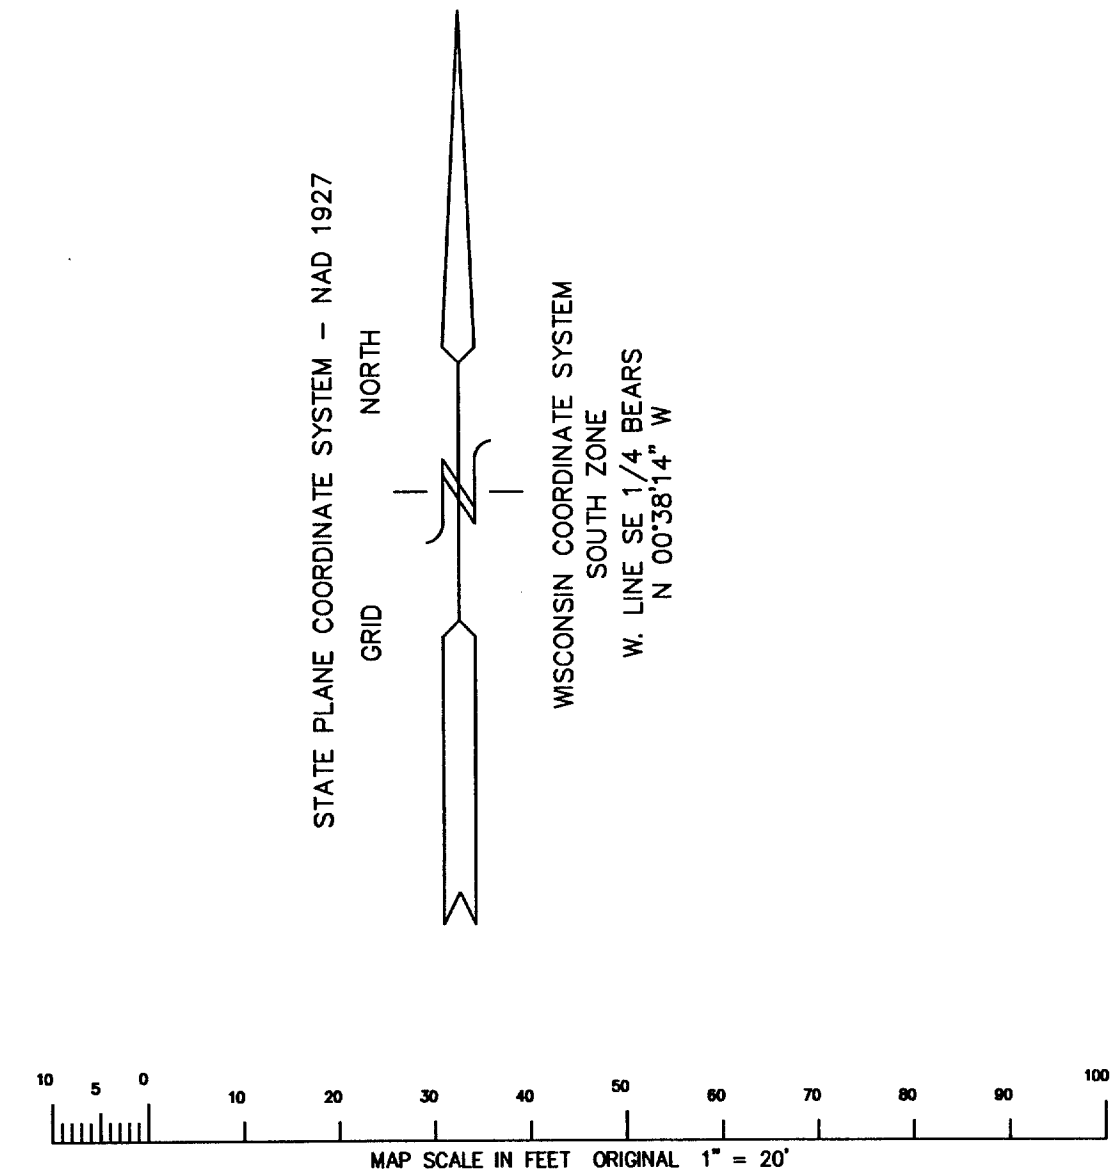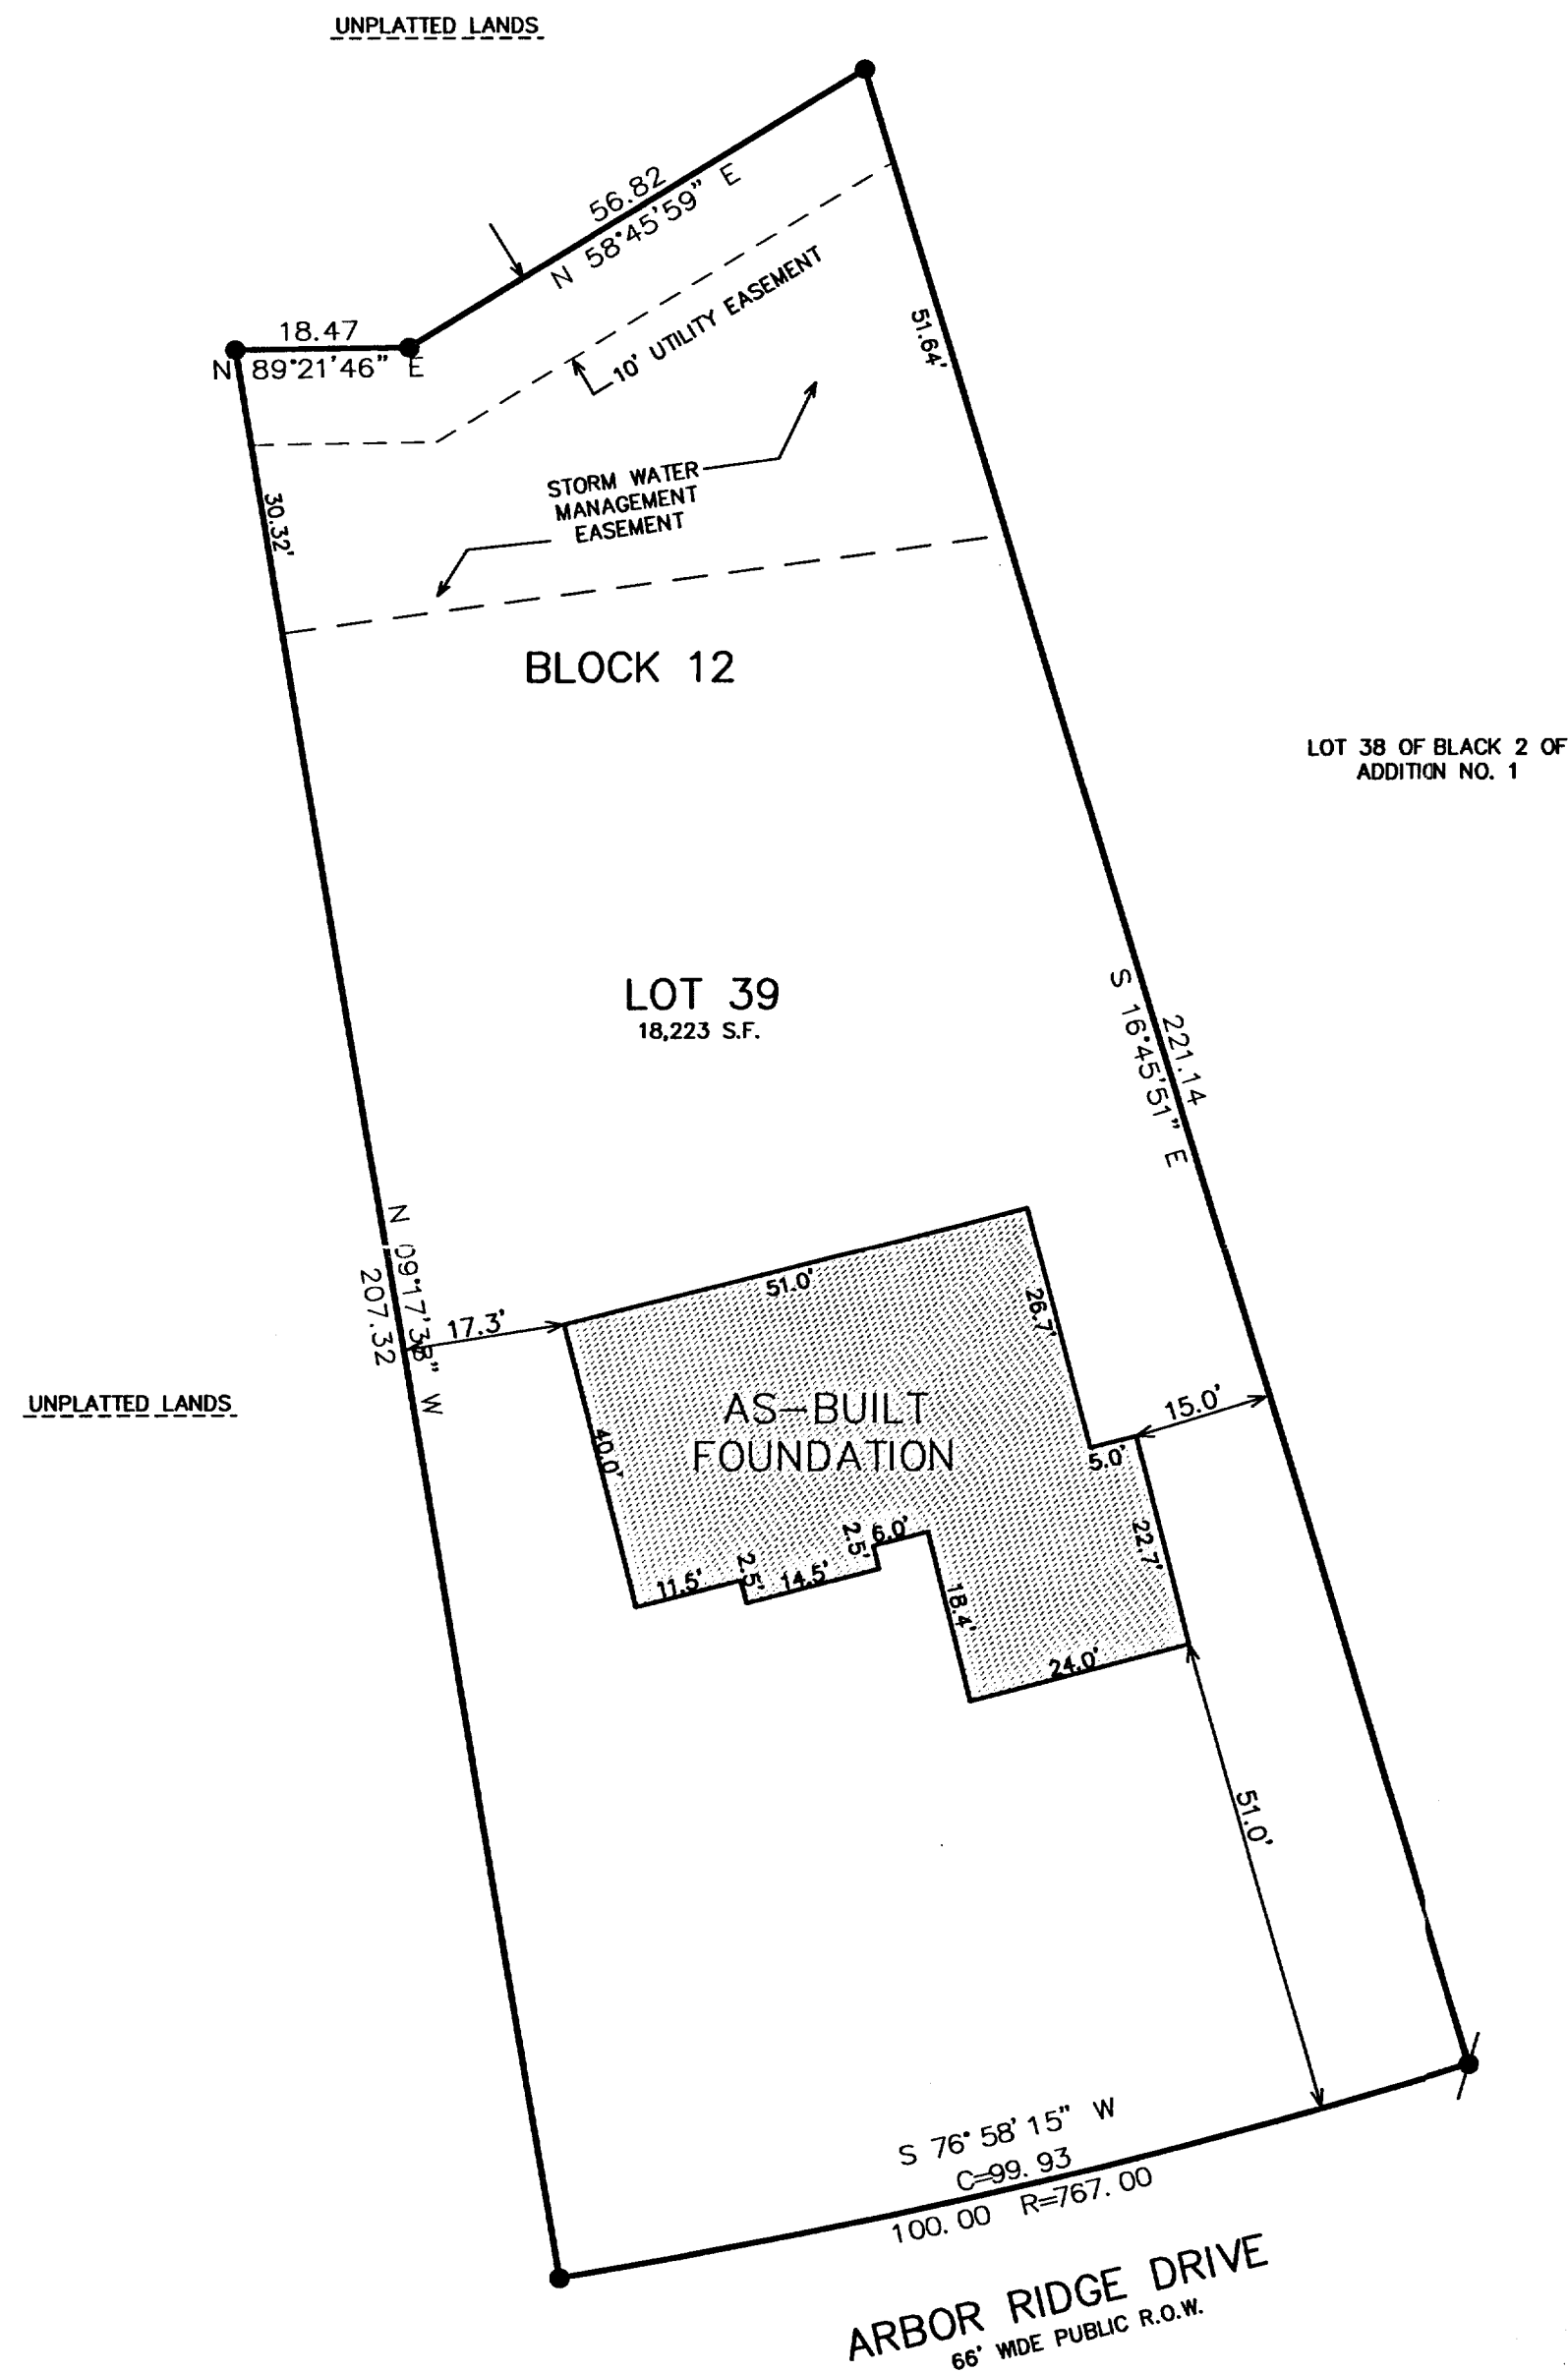


- = FOUND IRON PIPE STAKE 1" DIA.
- ⦿ = SET SOLID ROUND IRON BAR STAKE 3/4"
- = FOUND CONCRETE COUNTY MONUMENT
- ⦿ = SET SOLID ROUND IRON BAR STAKE 1 5/16"
- ( XXX ) = RECORDED AS

NOTE: COPIES OF THIS MAP TO WHICH THE FOLLOWING  
CERTIFICATE WILL APPLY SHOW SURVEYOR'S ORIGINAL  
SEAL AND SIGNATURE IN RED INK. COPIES BY  
ANY OTHER MEANS MAY HAVE ALTERATIONS WHICH DO NOT  
REPRESENT THE SURVEYOR'S WORK PRODUCT.

I HEREBY CERTIFY THAT THE ABOVE DESCRIBED PROPERTY  
HAS BEEN SURVEYED UNDER MY DIRECTION AND THAT THE  
ABOVE MAP IS A TRUE REPRESENTATION  
THEREOF AND SHOWS THE SIZE AND LOCATION OF THE  
PROPERTY AND ITS EXTERIOR BOUNDARIES. THIS SURVEY  
IS MADE FOR THE USE OF THE PRESENT OWNERS  
OF THE PROPERTY, AND ALSO THOSE WHO PURCHASE,  
MORTGAGE, OR GUARANTEE THE TITLE THERETO WITHIN  
ONE YEAR FROM THE DATE HEREOF.

DATED: 07/26/01

PETER S. GORDON R.L.S. 2101

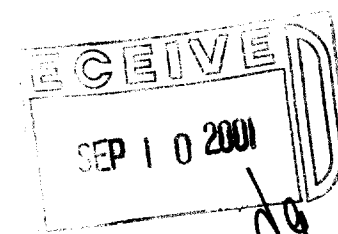

XLMM4-1  
002-1936

JUL 26 2001