
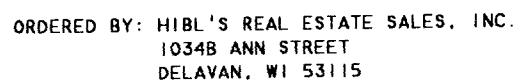


1140 SEQUOIA STREET • DELAVAN, WISCONSIN 53115
262-728-6737

(EAST)
S 89°56'31" E 90.17'

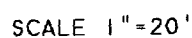

LOT 37 AND THE WEST 1/2 OF LOT 36,
MAR-DEL ESTATES, CITY OF DELAVAN,
WALWORTH COUNTY, WISCONSIN.

 \mathcal{N} 

Ø - IRON PIPE FOUND
O - 1" DIA. IRON PIPE SET
CS - CONCRETE STOOP
() - RECORDED AS


I HEREBY CERTIFY THAT I HAVE SURVEYED THE ABOVE DESCRIBED PROPERTY AND THAT THE ABOVE MAP IS A TRUE REPRESENTATION THEREOF AND SHOWS THE SIZE AND LOCATION OF THE PROPERTY, ITS EXTERIOR BOUNDARIES, THE LOCATION OF ALL VISIBLE STRUCTURES AND DIMENSIONS OF ALL PRINCIPAL BUILDINGS THEREON, BOUNDARY FENCES, APPARENT EASEMENTS, ROADWAYS AND VISIBLE ENCROACHMENTS, IF ANY, TO THE BEST OF MY KNOWLEDGE AND BELIEF.

THIS SURVEY IS MADE FOR THE USE OF THE PRESENT OWNERS OF THE PROPERTY, AND ALSO THOSE WHO PURCHASE, MORTGAGE, OR GUARANTEE THE TITLE THERETO WITHIN ONE (1) YEAR FROM DATE HEREON.

DAVID F. ABELL
WISCONSIN REGISTERED LAND SURVEYOR. S-1596

September 5, 2001

DATE September 3, 2001 JOB NUMBER - 01131
NOTE: THIS IS NOT A CERTIFIED COPY UNLESS SEALED.

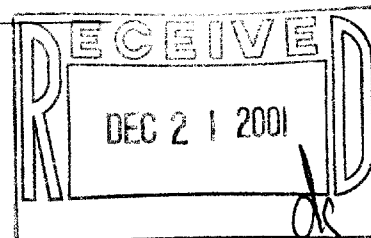

XMD-36 ✓

002-1945