



GEORGE T. DUNHAM
SURVEYING & SUBDIVIDING
DELAVER, WISCONSIN

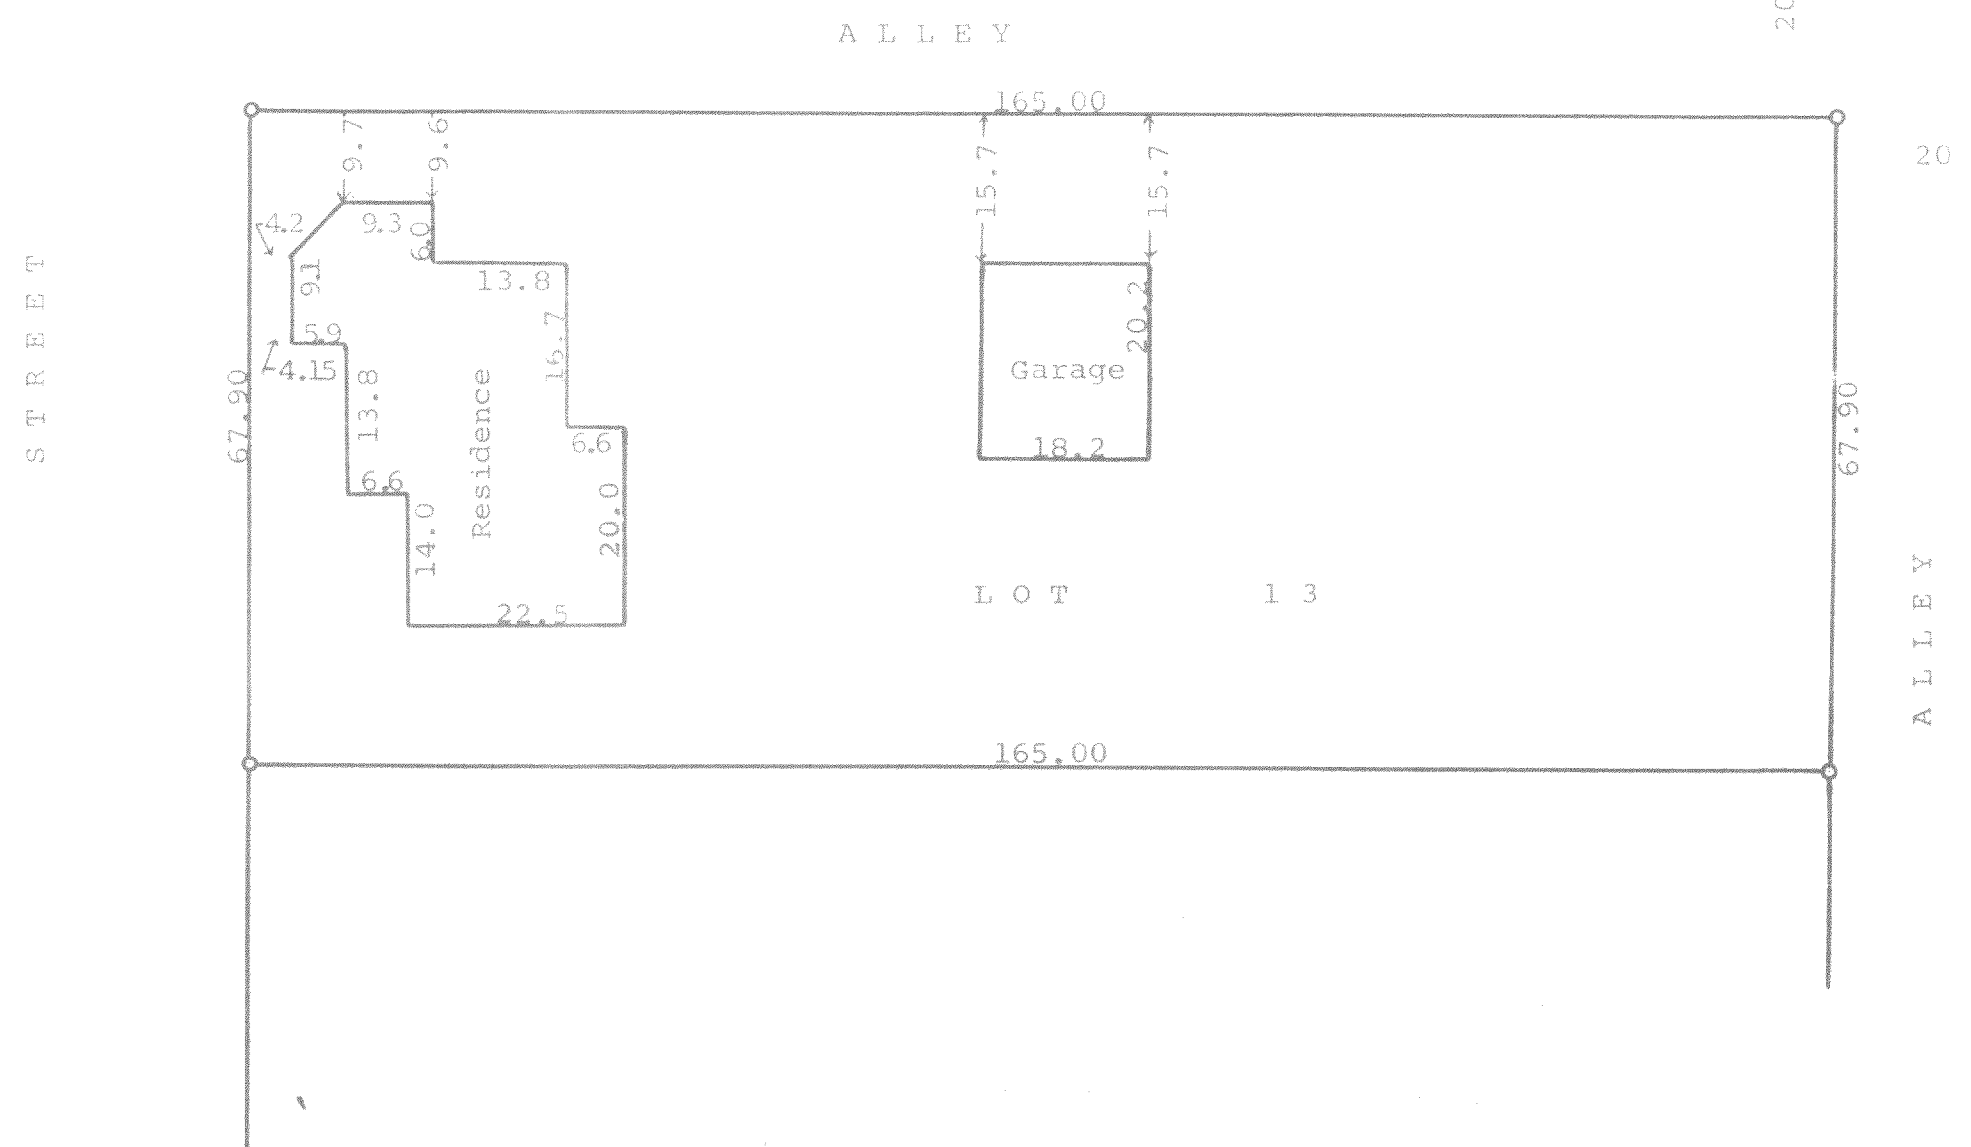

Scale - 1" = 20'

○ = Iron Pipe

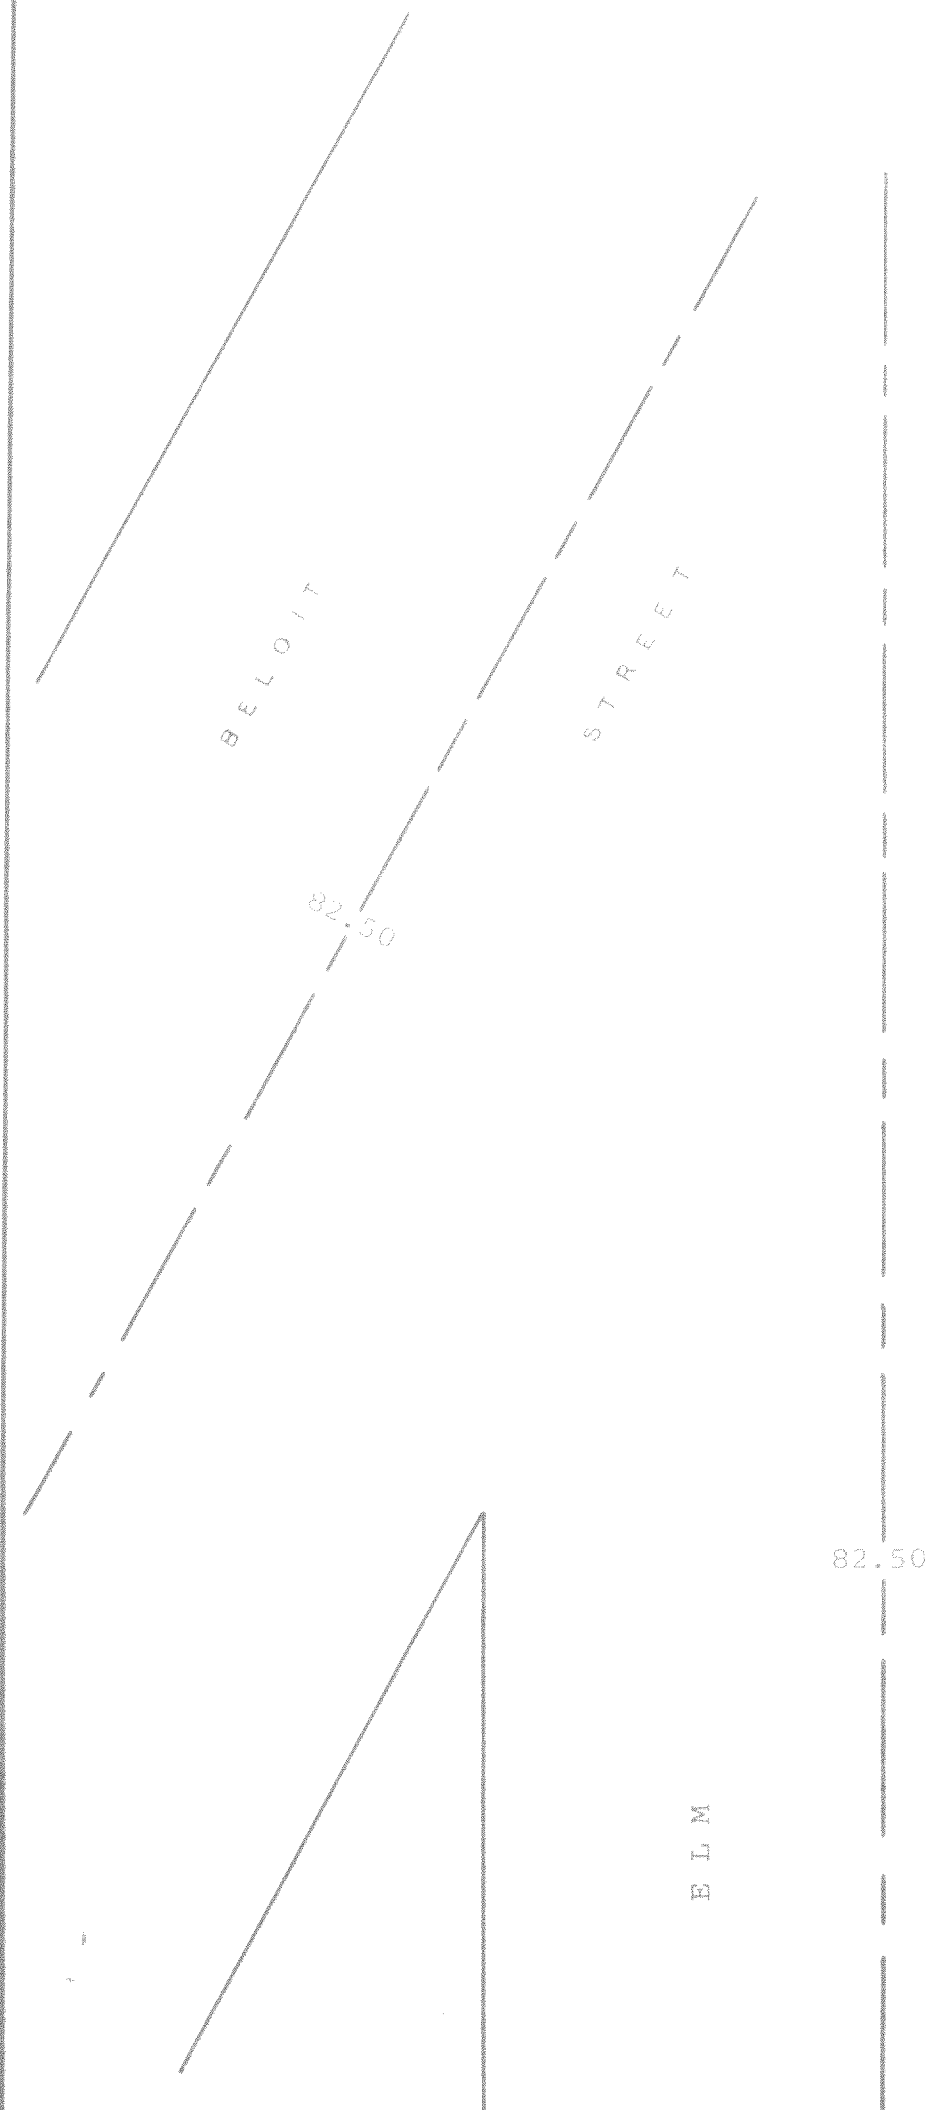

STATE OF WISCONSIN) ss
WALWORTH COUNTY)

I, George T. Dunham, do hereby certify that I have surveyed the property described as follows:
Lot 13, Block 4 of the F. K. Phoenix West Addition to the City of Delavan, Walworth County, Wisconsin.
and that the plat shown above is a correct representation of the property lines and of the improvements located thereon.
July 9, 1964

George T. Dunham
George T. Dunham, Surveyor