
DUNHAM SURVEYING, S.C. SURVEYING & SUBDIVIDING DELAYAN, WISCONSIN 53115

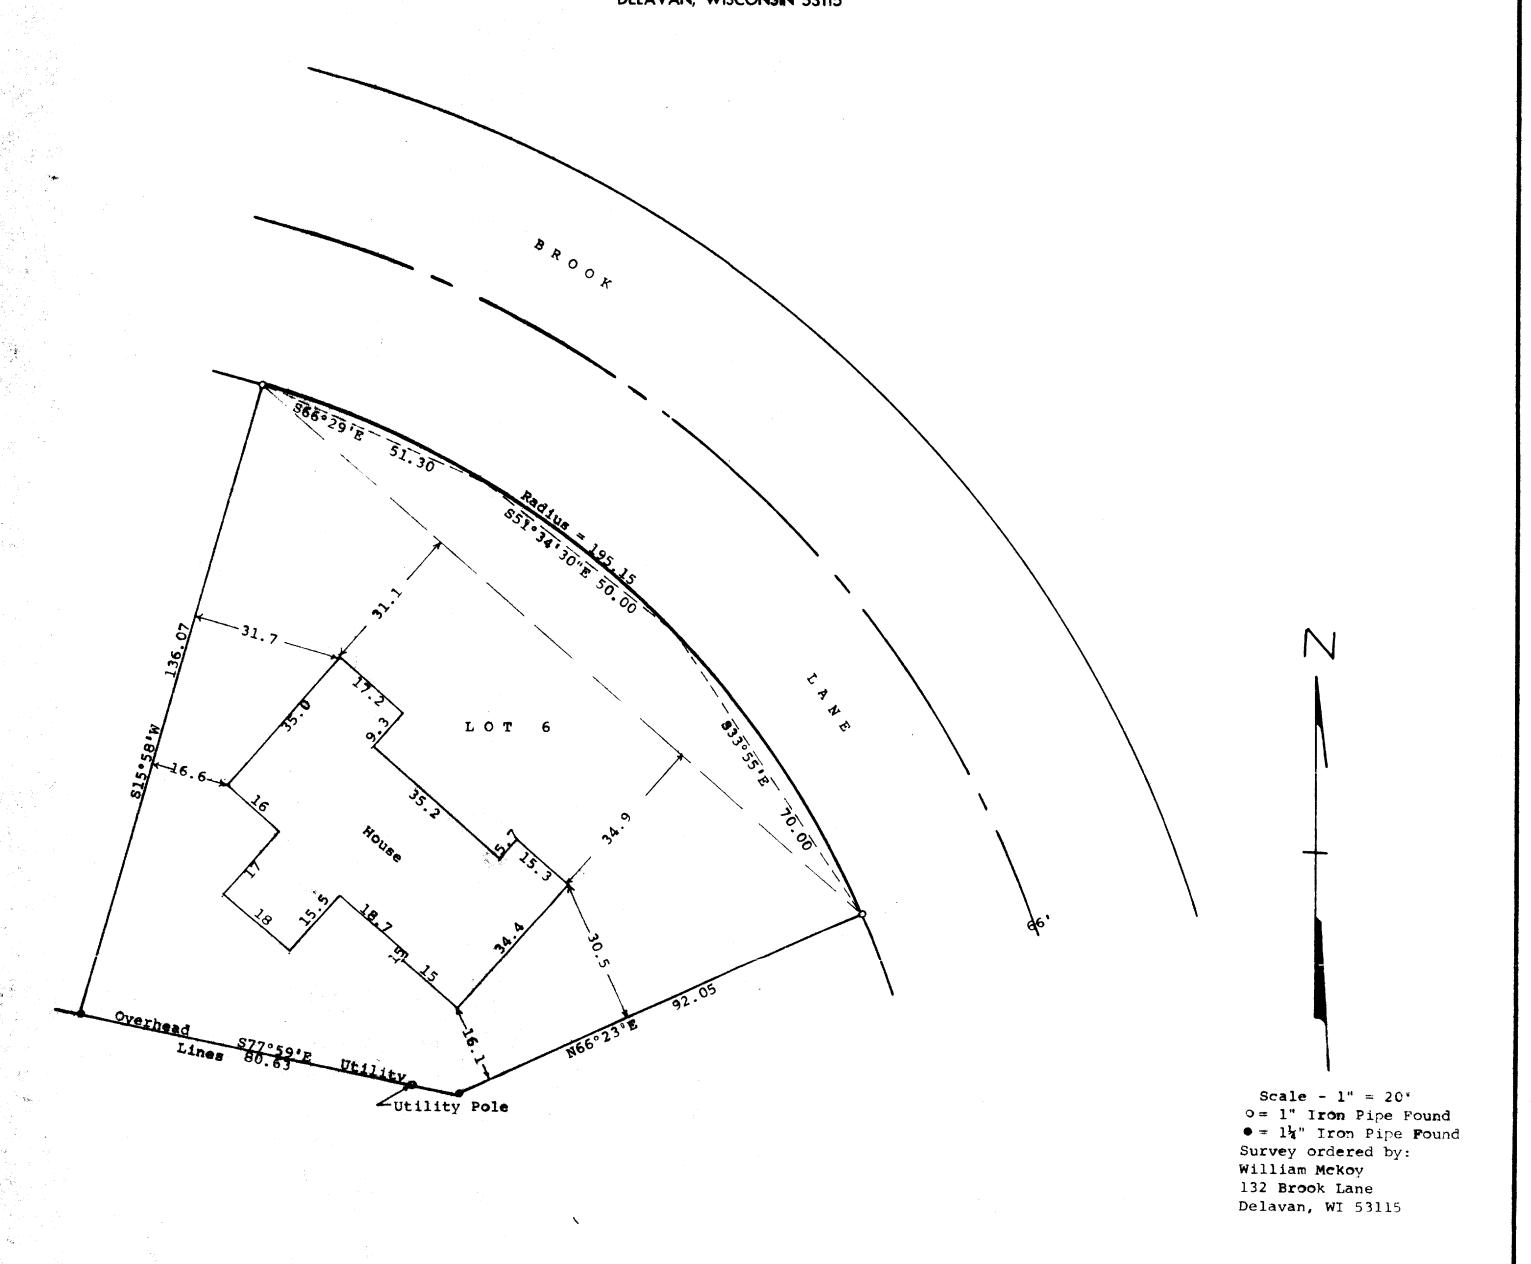

STATE OF WISCONSIN) SS COUNTY OF WALWORTH)

I, George T. Dunham, Surveyor, certify that I have surveyed the property described as follows:

Lot 6 in Brook Lane Subdivision, located in the City of Delavan, Walworth County, Wisconsin,

and that the plat shown hereon is a correct representation thereof and shows the size and location of the property, its exterior boundaries, the location of all visible structures and dimensions of all principal buildings thereon, boundary fences, apparent easements, roadways and visible encroachments, if any, and that I have surveyed the property hereon described, according to the official records, to the best of my knowledge and belief.

June 1, 2000

George T. Dunham, Surveyor



MAY

DRD

9 2003