

PLAT OF SURVEY

SITUATED ON S.T.H. 50, IN THE CITY OF DELAVAN, WALWORTH COUNTY, WISCONSIN

LOT 8, FINAL PLAT OF DELAVAN CROSSING, BEING A PART OF THE NORTHEAST, SOUTHEAST, SOUTHWEST AND NORTHWEST QUARTERS OF THE SOUTHWEST QUARTER AND PART OF THE SOUTHWEST AND NORTHWEST QUARTERS OF THE SOUTHWEST QUARTER OF SECTION 16, TOWN 2 NORTH, RANGE 16 EAST, IN THE CITY OF DELAVAN, WALWORTH COUNTY, WISCONSIN.

APRIL 14 2003


CHILI'S

SURVEY NO.: 161003-CLH

NOTES:
- ALL RECORDED EASEMENTS, MAY NOT BE SHOWN.
- PIPE SIZES SHOWN, MEASURED IN FIELD, MUST BE VERIFIED.


LEGEND

- △ BENCHMARK
- SECTION CORNER
- IRON PIPE FOUND
- IRON PIPE SET
- ⊙ BOLLARD
- ⊙ SOIL BORING/MONITORING WELL
- ⊙ FLAGPOLE
- ⊙ MAILBOX
- ⊙ SIGN
- ⊙ BILLBOARD
- ⊙ CONTROL BOX
- ⊙ TRAFFIC SIGNAL
- ⊙ RAILROAD CROSSING SIGNAL
- ⊙ CABLE PEDESTAL
- ⊙ POWER POLE
- ⊙ GUY POLE
- ⊙ GUY WIRE
- ⊙ LIGHT POLE
- ⊙ GROUND OR OTHER SPOT SHOT
- ⊙ HANDICAPPED PARKING
- ⊙ ELECTRIC MANHOLE
- ⊙ ELECTRIC PEDESTAL
- ⊙ ELECTRIC METER
- ⊙ TELEPHONE MANHOLE
- ⊙ TELEPHONE PEDESTAL
- ⊙ MARKED FIBER OPTIC
- ⊙ GAS VALVE
- ⊙ GAS METER
- ⊙ STORM MANHOLE
- ⊙ ROUND INLET
- ⊙ SQUARE INLET
- ⊙ STORM SEWER END SECTION
- ⊙ SANITARY MANHOLE
- ⊙ SANITARY CLEANOUT OR SEPTIC VENT
- ⊙ SANITARY INTERCEPTOR MANHOLE
- ⊙ MISCELLANEOUS MANHOLE
- ⊙ WATER VALVE
- ⊙ HYDRANT
- ⊙ WATER SERVICE CURB STOP
- ⊙ WATER MANHOLE
- ⊙ WELL
- ⊙ WATER SURFACE
- ⊙ WETLANDS FLAG
- ⊙ MARSH
- ⊙ CONIFEROUS TREE
- ⊙ DECIDUOUS TREE
- ⊙ SHRUB
- EDGE OF TREES
- s- SANITARY SEWER
- STO- STORM SEWER
- W- WATERMAIN
- G- MARKED GAS MAIN
- E- MARKED ELECTRIC
- O- OVERHEAD WIRES
- B- BUREAU ELEC. SERV.
- T- MARKED TELEPHONE
- TV- MARKED CABLE TV LINE
- FO- MARKED FIBER OPTIC

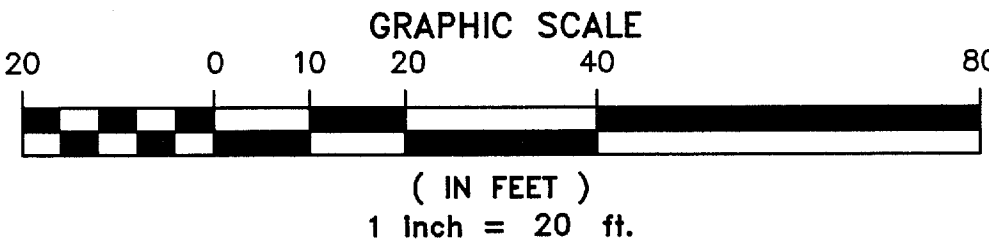

I Certify that I have surveyed the above described property (Property), and the above map is correct to the best of my professional knowledge and belief and shows the size and location of the Property, its exterior boundaries, the location and dimensions of all visible structures thereon, boundary fences, apparent easements and roadways and visible encroachments. If any, this survey is made for the exclusive use of the present owners of the Property, and also those who purchase, mortgage, or guarantee the title thereto, within one (1) year from date hereof.

JOHN P. CASUCCI
REGISTERED WISCONSIN LAND SURVEYOR S-2055

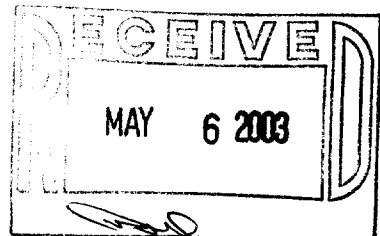

National Survey & Engineering

Telephone 262-781-1000
Facsimile 262-797-7373
16745 W. Bluemound Road
Suite 200
Brookfield, WI 53005-5938
www.nseeb.com
5161003 \ 161003 \ PS101220 \ CLH

