


PLAT OF SURVEY
CITY OF DELAVAN
WALWORTH COUNTY, WISCONSIN

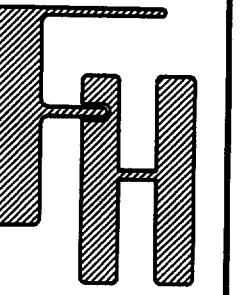


PLAT OF SURVEY
LOTS 2, 3, 4 OF C.S.M. 1448
LOT 1 OF C.S.M. 1469
CITY OF DELAVAN
WALWORTH COUNTY, WISCONSIN

WORK ORDERED BY -
VASILI D. RUSSO
C/O LEVIN, GOODMAN, & COHEN
500 SOKOL BLVD., SUITE 650
NORTHBROOK, IL 60062

FARRIS, HANSEN & ASSOCIATES, INC.
ENGINEERING - ARCHITECTURE - SURVEYING
7 RIDGWAY COURT, P.O. BOX 437
ELKHORN, WISCONSIN 53121
OFFICE: (262) 723-2098 FAX: (262) 723-5886

REVISIONS

PROJECT NO.
2518.03
DATE
07/29/03
SHEET NO.
1 OF 1

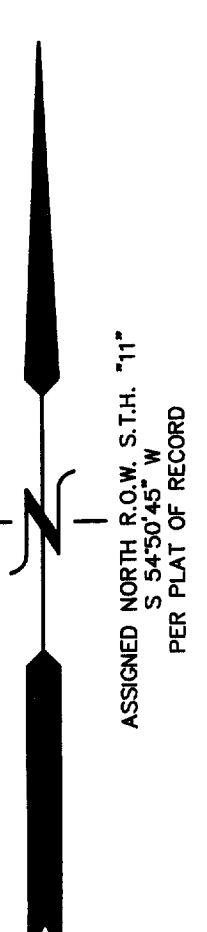

LINE	BEARING	DISTANCE
L1	N 81°14'28" W	28.21
L2	N 34°20'32" W	17.36
L3	S 35°10'00" E	17.00
L4	S 09°50'23" W	28.28

NOTE:
L1 (N 80°09'38" W 28.29")
L2 (N 35°12' W 17.00")


- LEGEND
- = FOUND IRON PIPE STAKE
 - = FOUND IRON REBAR STAKE
 - ✱ = SET IRON REBAR STAKE
 - x = FOUND CHISELED "X" IN CONCRETE
 - (XXX) = RECORDED AS

PARCEL 1: Lots 2, 3 and 4 of Certified Survey Map No. 1448, according to the plat thereof recorded in Volume 6 of Certified Surveys on page 350 as Document No. 121277, City of Delavan, Walworth County, Wisconsin.

Tax Key No. XA144800002, XA144800003 and XA144800004

PARCEL 2: Lot 1 of Certified Survey Map No. 1469 according to the plat thereof recorded in Vol. 7 of Certified Surveys on page 36 as Document No. 124838, City of Delavan, Walworth County, Wisconsin.

Tax Key No. XA146900001

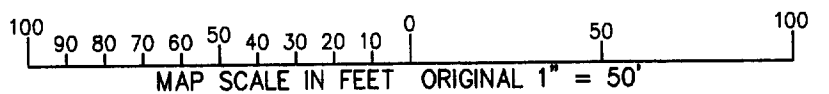

7/29/03 X:\Projects\2518\GADD SURVEY

XA1469-1
XA1448-2
XA1448-3

XA1448-9

002-2158