


ABELL
SURVEYING & MAPPING

1140 SEQUOIA STREET • DELAVAN, WISCONSIN 53115
262-728-6737

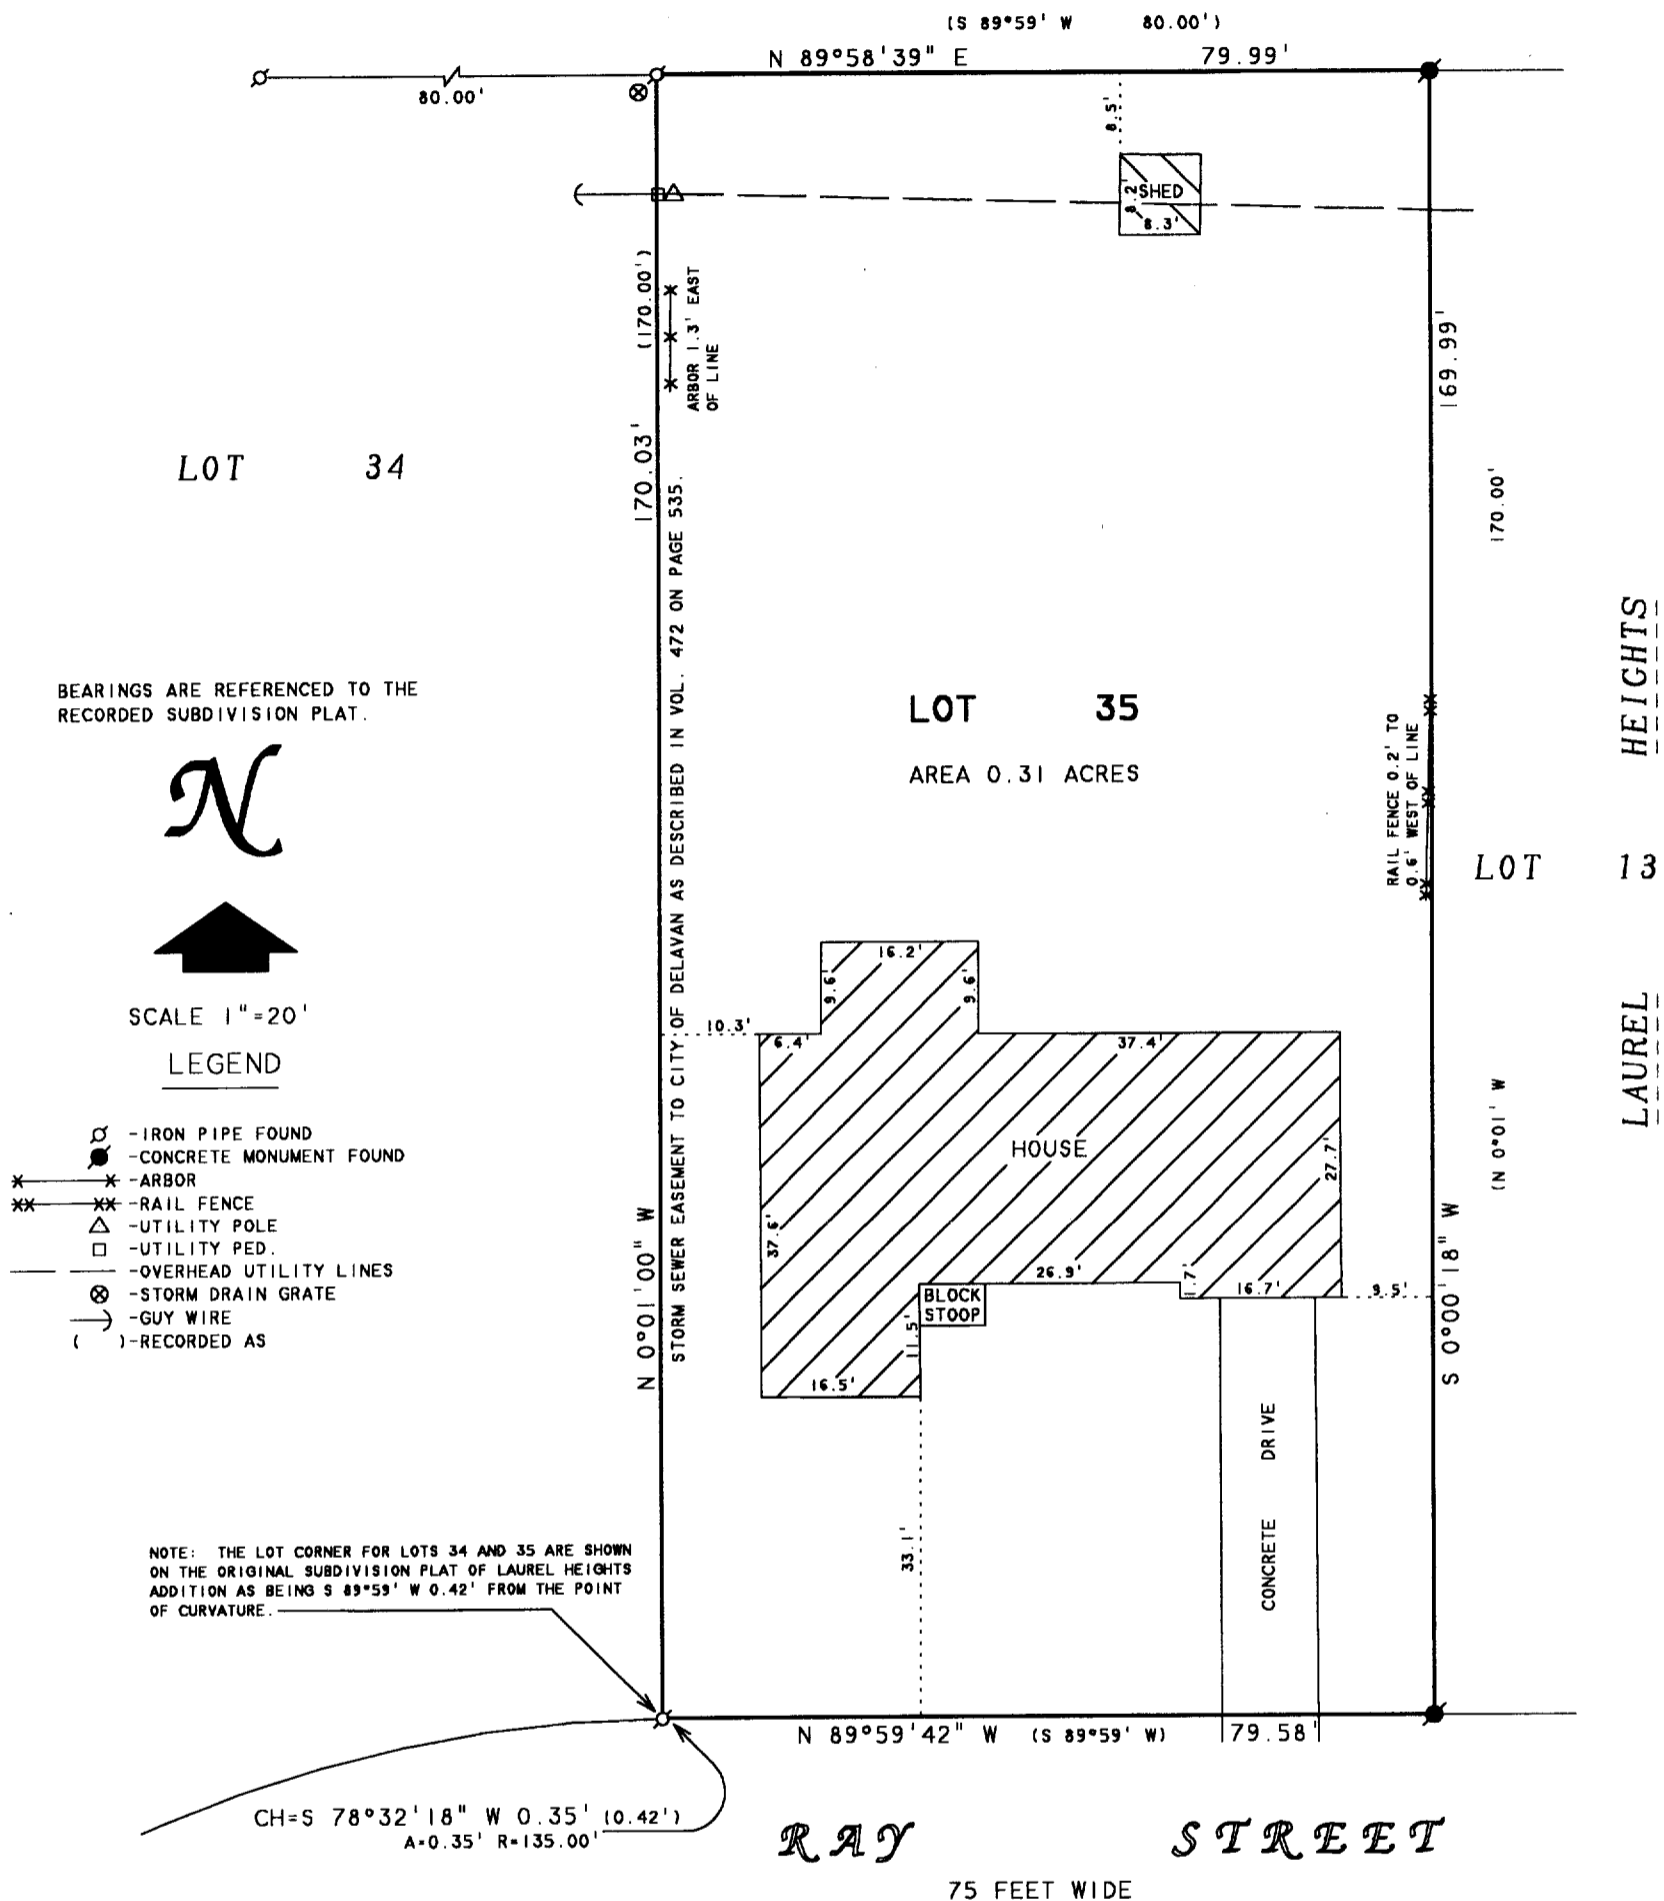

JUL 5

kw

ORDERED BY: KEEFE REAL ESTATE
1155 E. GENEVA STREET
DELAVAN, WI 53115

May 18, 2004

DATE: May 18, 2004
JOB NUMBER - 04055
NOTE: THIS IS NOT A CERTIFIED COPY UNLESS SEALED.

XLHA 00013

002-2224