



Plat of Survey

of
Lot 4 of Block 1 of Broadview Subdivision,
located in the Northeast 1/4 of Section 17, Town 2 North,
Range 16 East, City of Delavan, Walworth County, Wisconsin.

Surveyed for: **Steve & Joanne Lockwood**
533 Sugar Creek Road
Delavan, Wisconsin. 53115

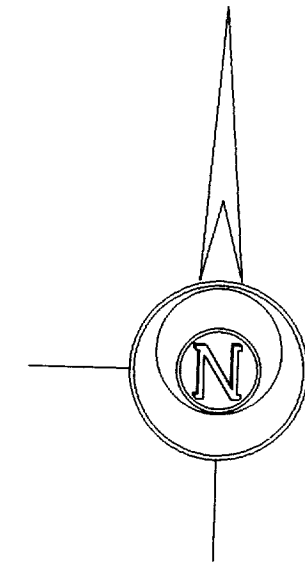

Bearings reference to the plat
of Broadview Subdivision.

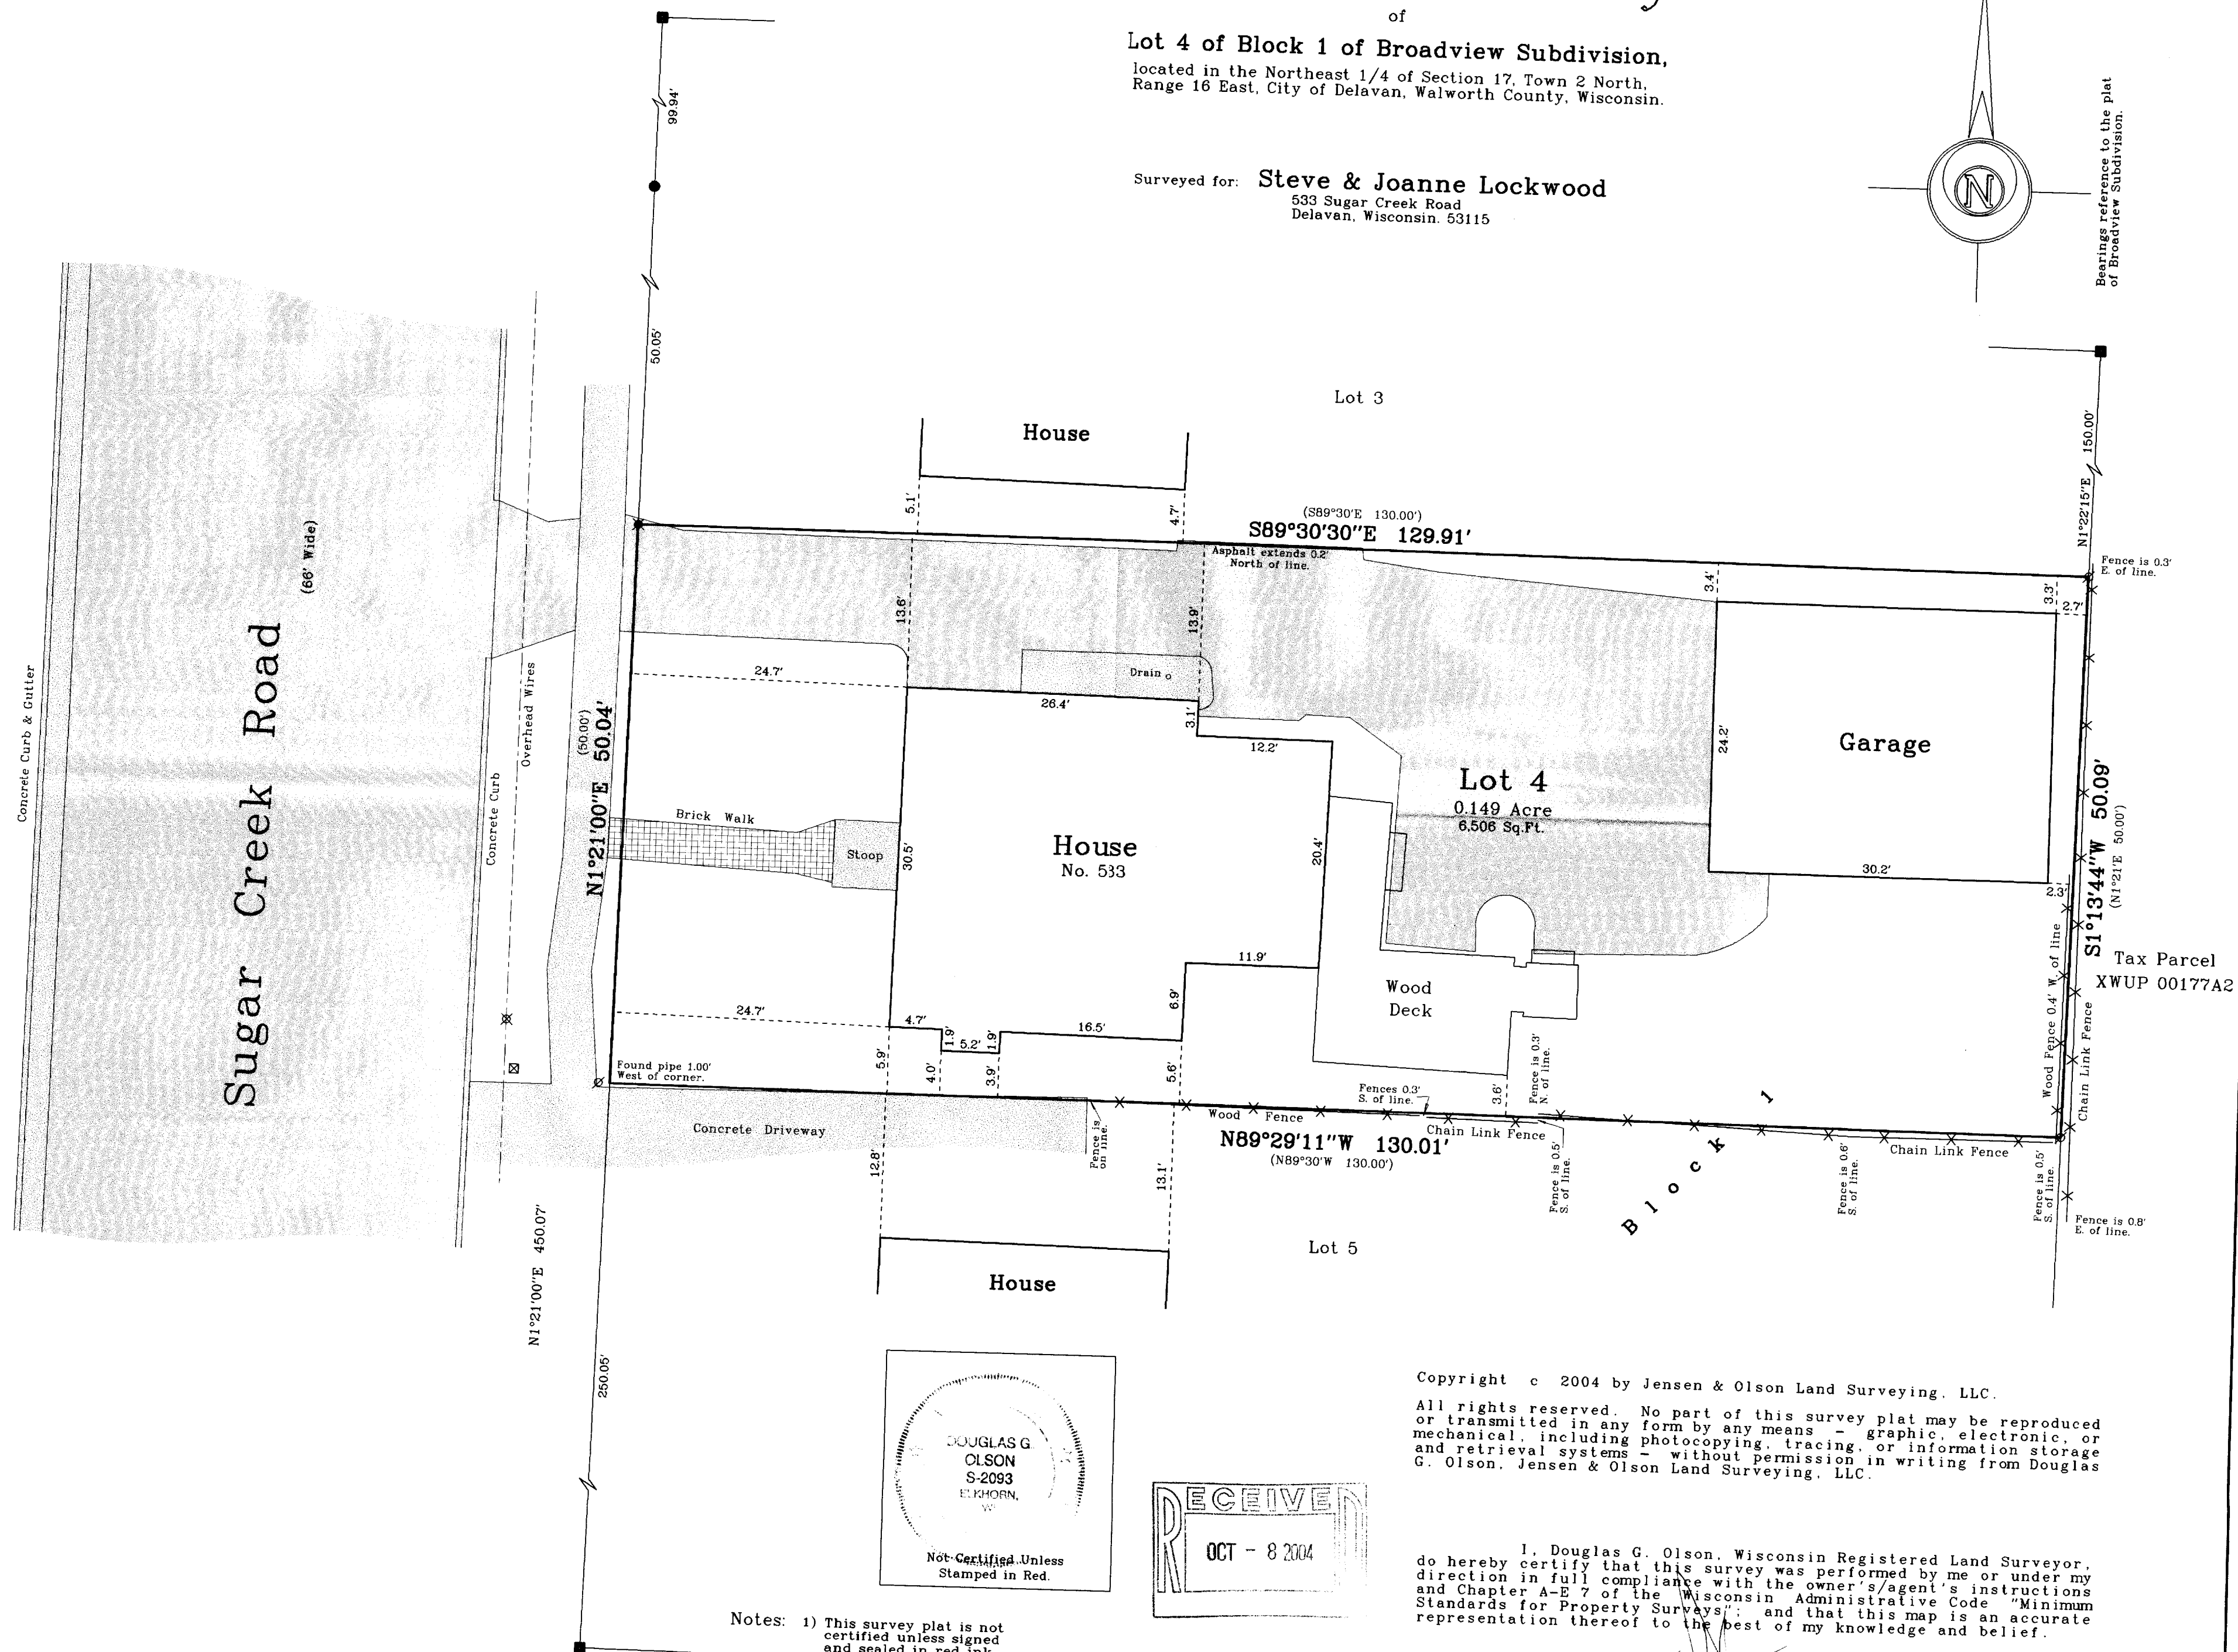

Jensen & Olson Land Surveying, LLC
45 South Wisconsin Street
Elkhorn, Wisconsin. 53121
Telephone (262) 723-3434
Facsimile (262) 723-8044

Legend
Found Concrete Monument
Found Iron Pipe
Found Iron Rod
Set Nail in Concrete
Recorded Information
Utility Pole
Concrete Surface
Asphalt

Sheet 1 of 1 Sheets
Job Reference Number
2004.128
2004.128

Survey Date: August 13, 2004.
Revisions:

Scale in Feet
1" = 10'
0 5' 10' 20'



Copyright © 2004 by Jensen & Olson Land Surveying, LLC.

All rights reserved. No part of this survey plat may be reproduced or transmitted in any form by any means - graphic, electronic, or mechanical, including photocopying, tracing, or information storage and retrieval systems - without permission in writing from Douglas G. Olson, Jensen & Olson Land Surveying, LLC.

I, Douglas G. Olson, Wisconsin Registered Land Surveyor, do hereby certify that this survey was performed by me or under my direction in full compliance with the owner's/agent's instructions and Chapter A-E 7 of the Wisconsin Administrative Code "Minimum Standards for Property Surveys"; and that this map is an accurate representation thereof to the best of my knowledge and belief.

Douglas G. Olson
Wisconsin Registered Land Surveyor - 2093

- Notes: 1) This survey plat is not certified unless signed and sealed in red ink.
2) This survey is subject to Wisconsin lien laws. This Plat of Survey is the notice of intent to file lien. Lien waiver required.

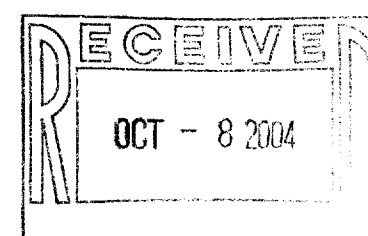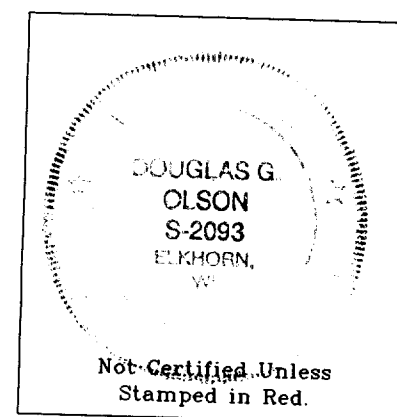

XBRD 00002

002-2250