


# FARRIS, HANSEN & COOPER, INC.


ENGINEERING, SURVEYING AND LAND PLANNING  
715 W. WALWORTH ST. - P.O. BOX 487 - ELKHORN, WI 53121  
OFFICE: 414/723-2098

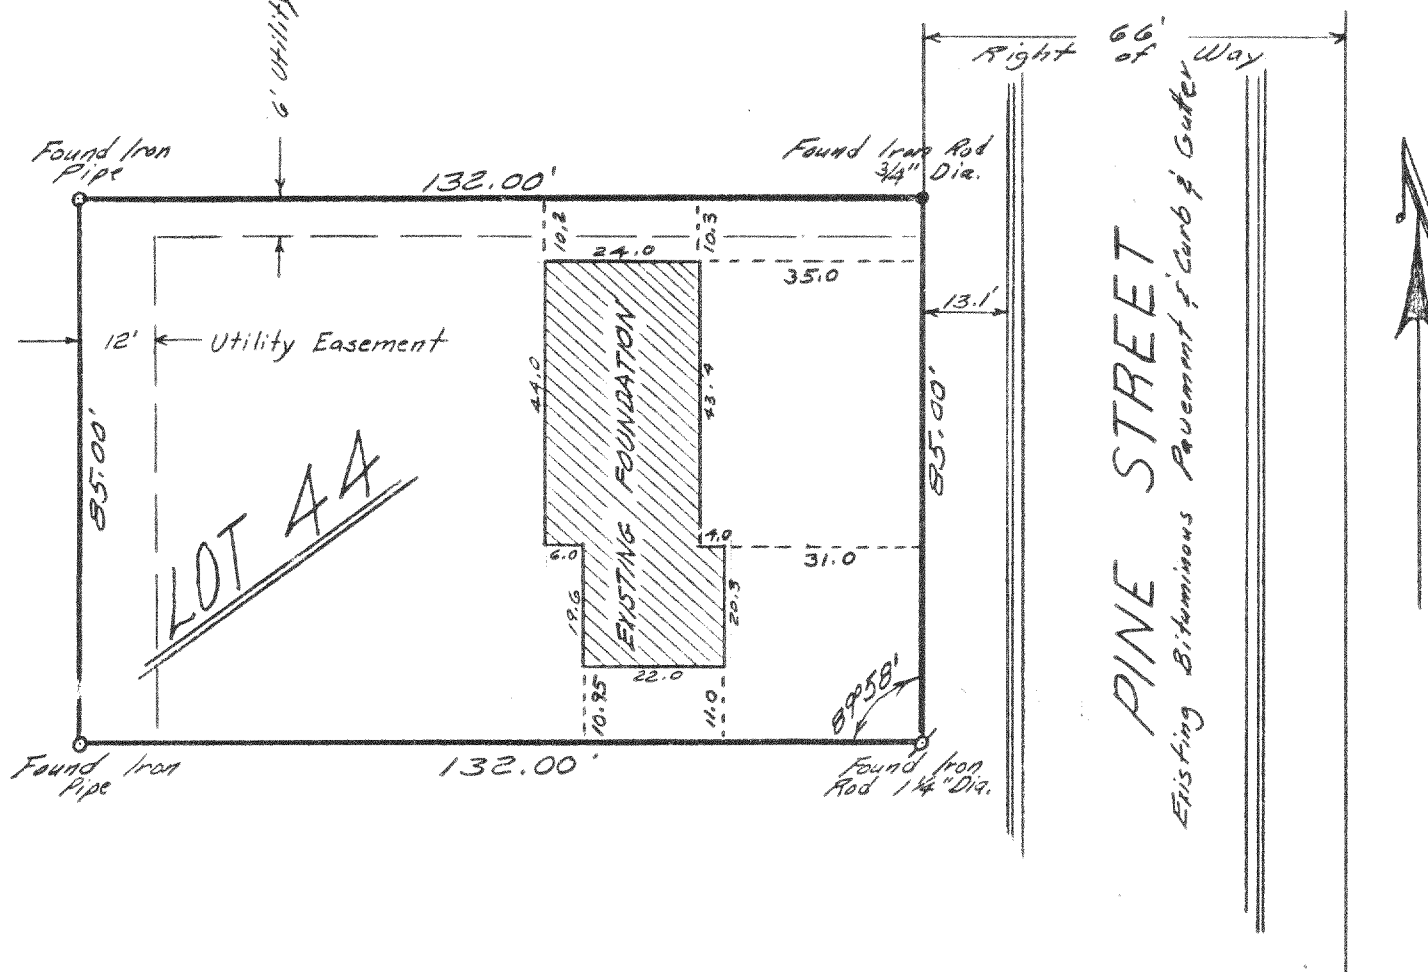

PLAT OF SURVEY OF LOT 44 OF TURTLE CREEK SUBDIVISION IN THE CITY OF DELAVAN, WALWORTH COUNTY, WISCONSIN

WORK ORDERED BY: MIKE KARCHER - OWNER  
662 E. GENEVA ST.  
DELAVAN, WIS. 53115

I HEREBY CERTIFY that this plat of survey is a true and accurate representation of the lot lines and of the basement of an unfinished residence located thereon to the best of my professional knowledge and belief.

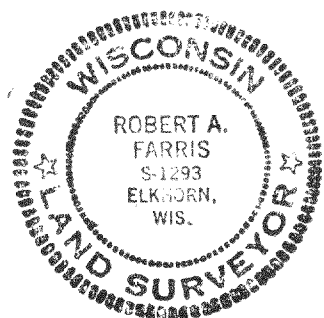

*Robert A. Farris*  
ROBERT A. FARRIS RLS

DATED THIS 25th DAY OF OCTOBER 1978

MAP SCALE 1"=30'

DRAWING NUMBER 1426

2-237