


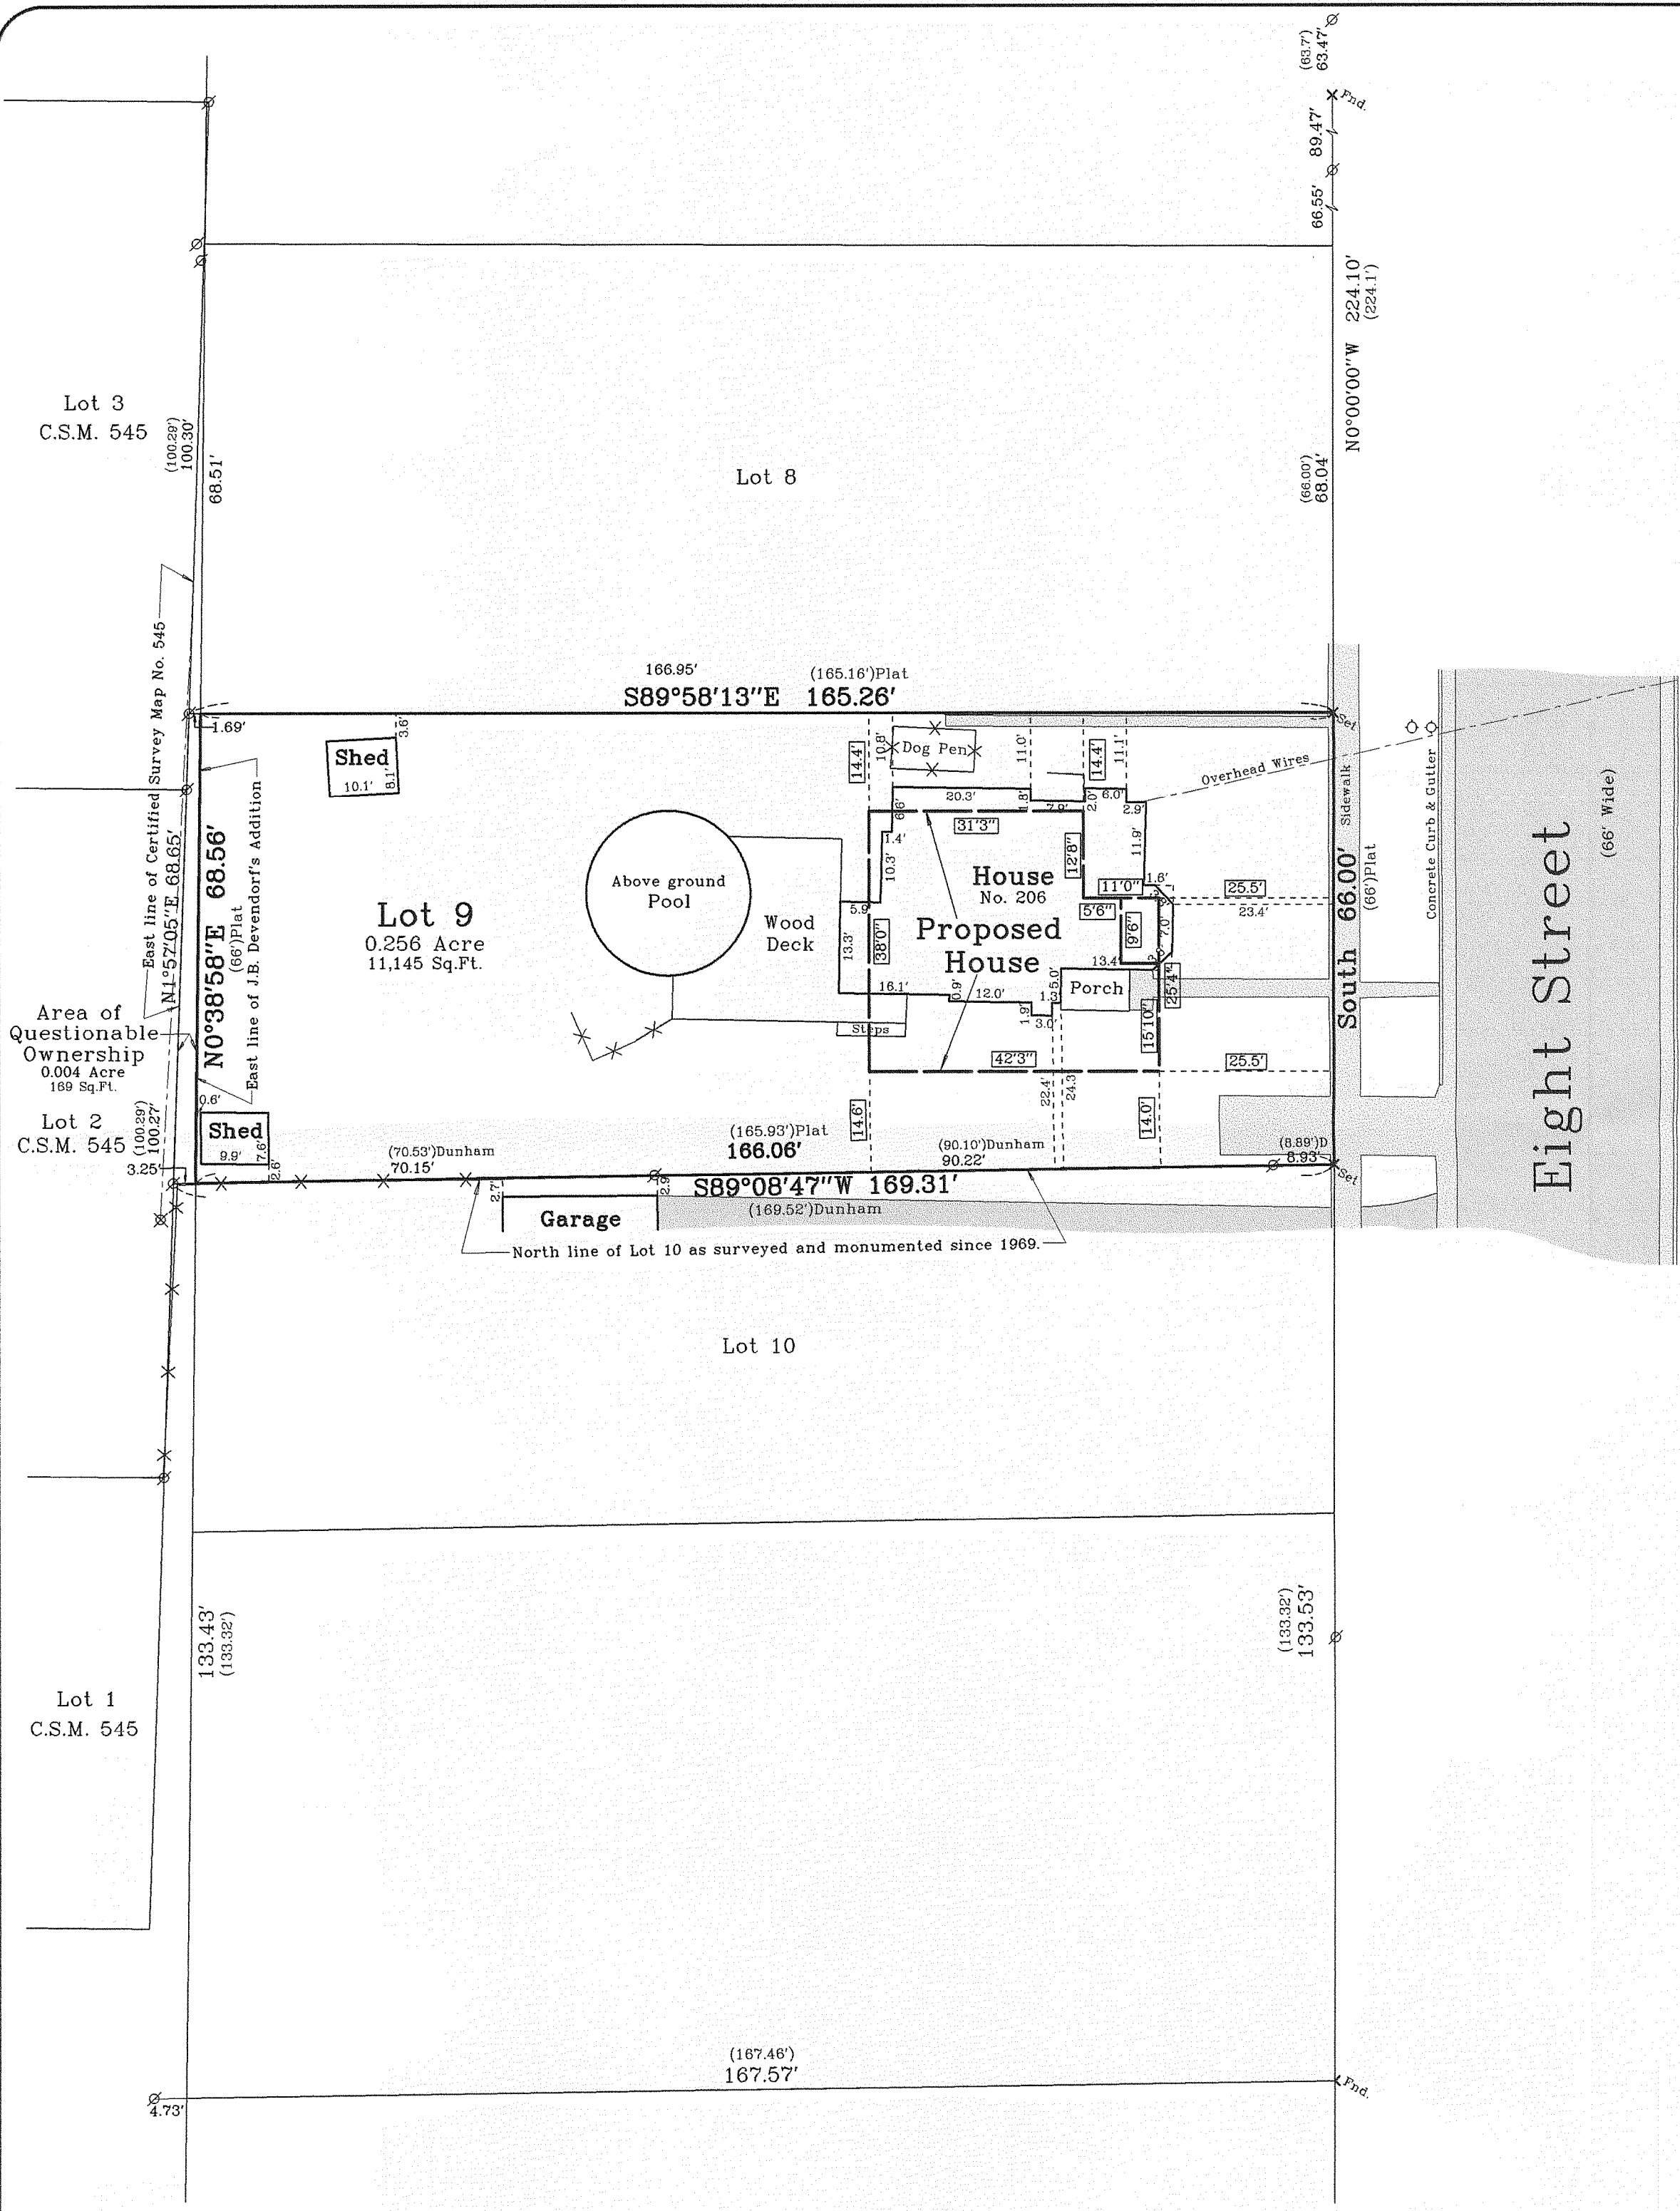




Plat of Survey

of
Lot 9 of Block 2 of J.B. Devendorf's Addition
to the Village (now City) of Delavan,
located in the Northwest 1/4 of Section 17, Town 2 North,
Range 16 East, City of Delavan, Walworth County, Wisconsin.

Surveyed for: **Naser & Cara Tahiri**
206 North 8th Street
Delavan, Wisconsin. 53115

Subdivision Detail
1"=100'

Parish Street
(162.55') Plat proportion
N89°33'22"W 162.71'

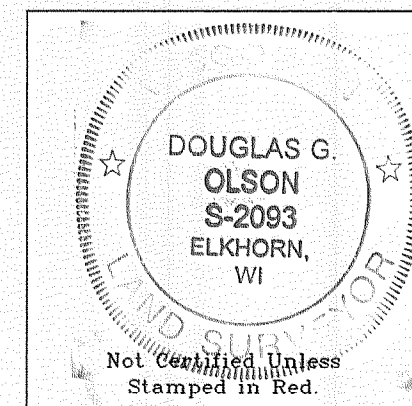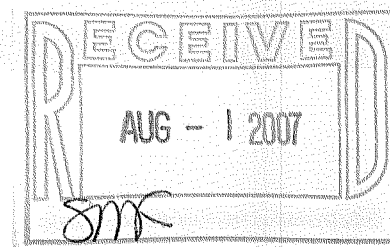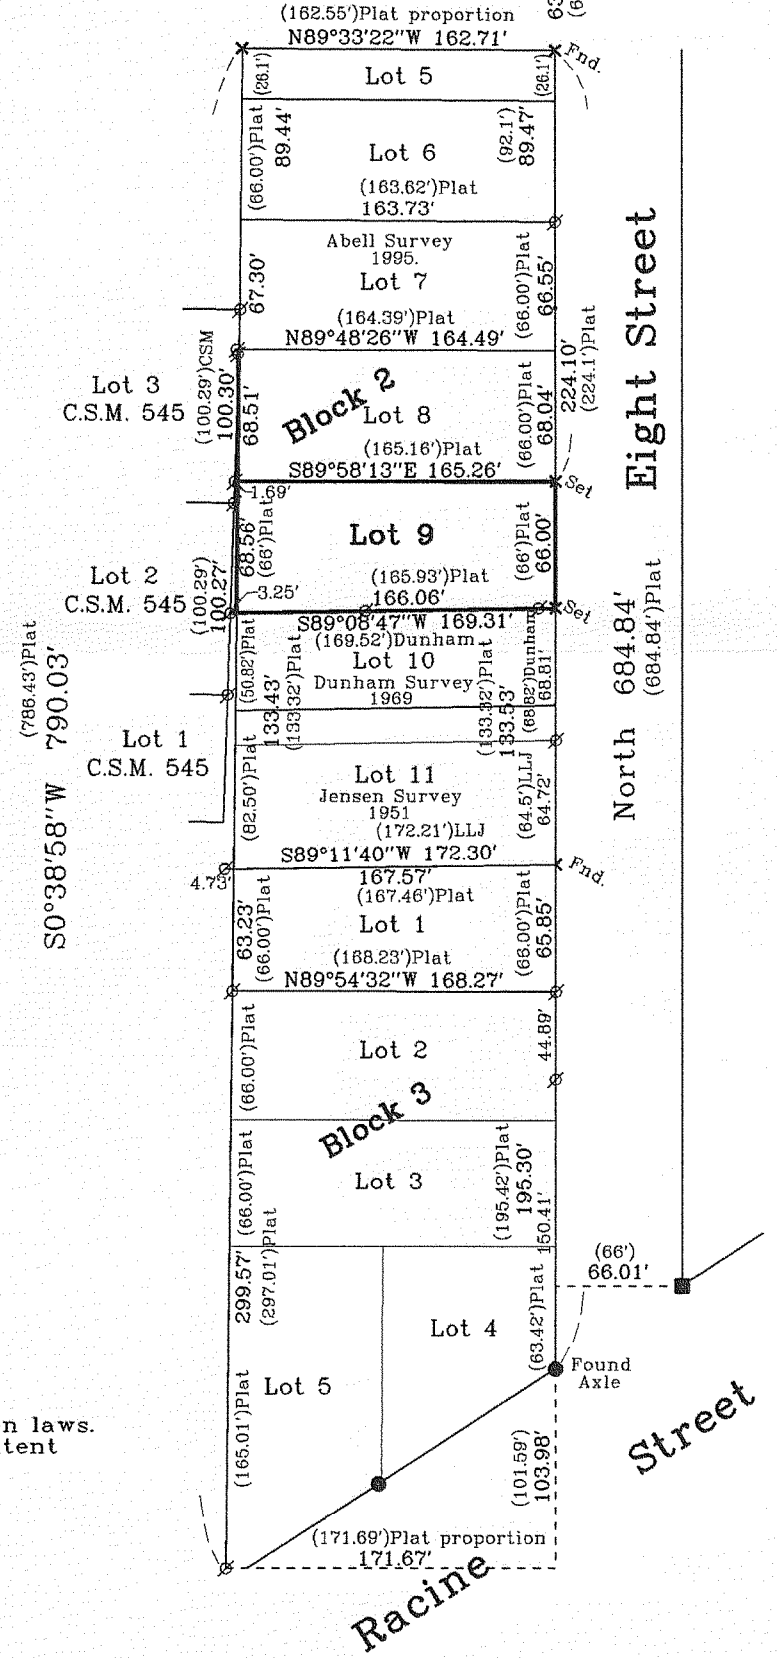

- Notes: 1) This survey plat is not certified unless signed and sealed in red ink.
- 2) This survey is subject to Wisconsin lien laws. This Plat of Survey is the notice of intent to file lien. Lien waiver required.

Copyright © 2006 by Jensen & Olson Land Surveying, LLC.

All rights reserved. No part of this survey plat may be reproduced or transmitted in any form by any means - graphic, electronic, or mechanical, including photocopying, tracing, or information storage and retrieval systems - without permission in writing from Douglas G. Olson, Jensen & Olson Land Surveying, LLC.

I, Douglas G. Olson, Wisconsin Registered Land Surveyor, do hereby certify that this survey was performed by me or under my direction in full compliance with the owner's/agent's instructions and Chapter A-E 7 of the Wisconsin Administrative Code "Minimum Standards for Property Surveys"; and that this map is an accurate representation thereof to the best of my knowledge and belief.

Douglas G. Olson
Wisconsin Registered Land Surveyor - 2093

Survey Date: August 11, 2006.
Revisions: No. 1 - Proposed House

Scale in Feet
1" = 20'
0' 10' 20' 40'

Jensen & Olson Land Surveying, LLC
45 South Wisconsin Street
Elkhorn, Wisconsin. 53121
Telephone (262) 723-3434
Facsimile (262) 723-8044

Legend

Found Concrete Monument

Found Iron Pipe

Found Iron Rod

Crossed Out

Recorded Information

Utility Pole

Asphalt Surface

Concrete

Sheet 1 of 1 Sheets

Job Reference Number

2006.095

2006.095