



LOT AREA: 16,073 SQ.FT.

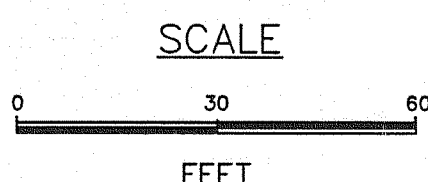

AMERICAN SURVEYING COMPANY, INC.
PETE L. BAILEY, RLS NO. 1398
RECERTIFIED this 7TH day of JUNE, 2007.



949.82
SSMH
SS MH
RIM: 949.82
INV: 939.76

- DWELLING UNDER CONSTRUCTION
- BASEMENT, INSULATION, STEEL
- TOP OF WALL: 952.59
- TOP OF FOOTING: 943.36

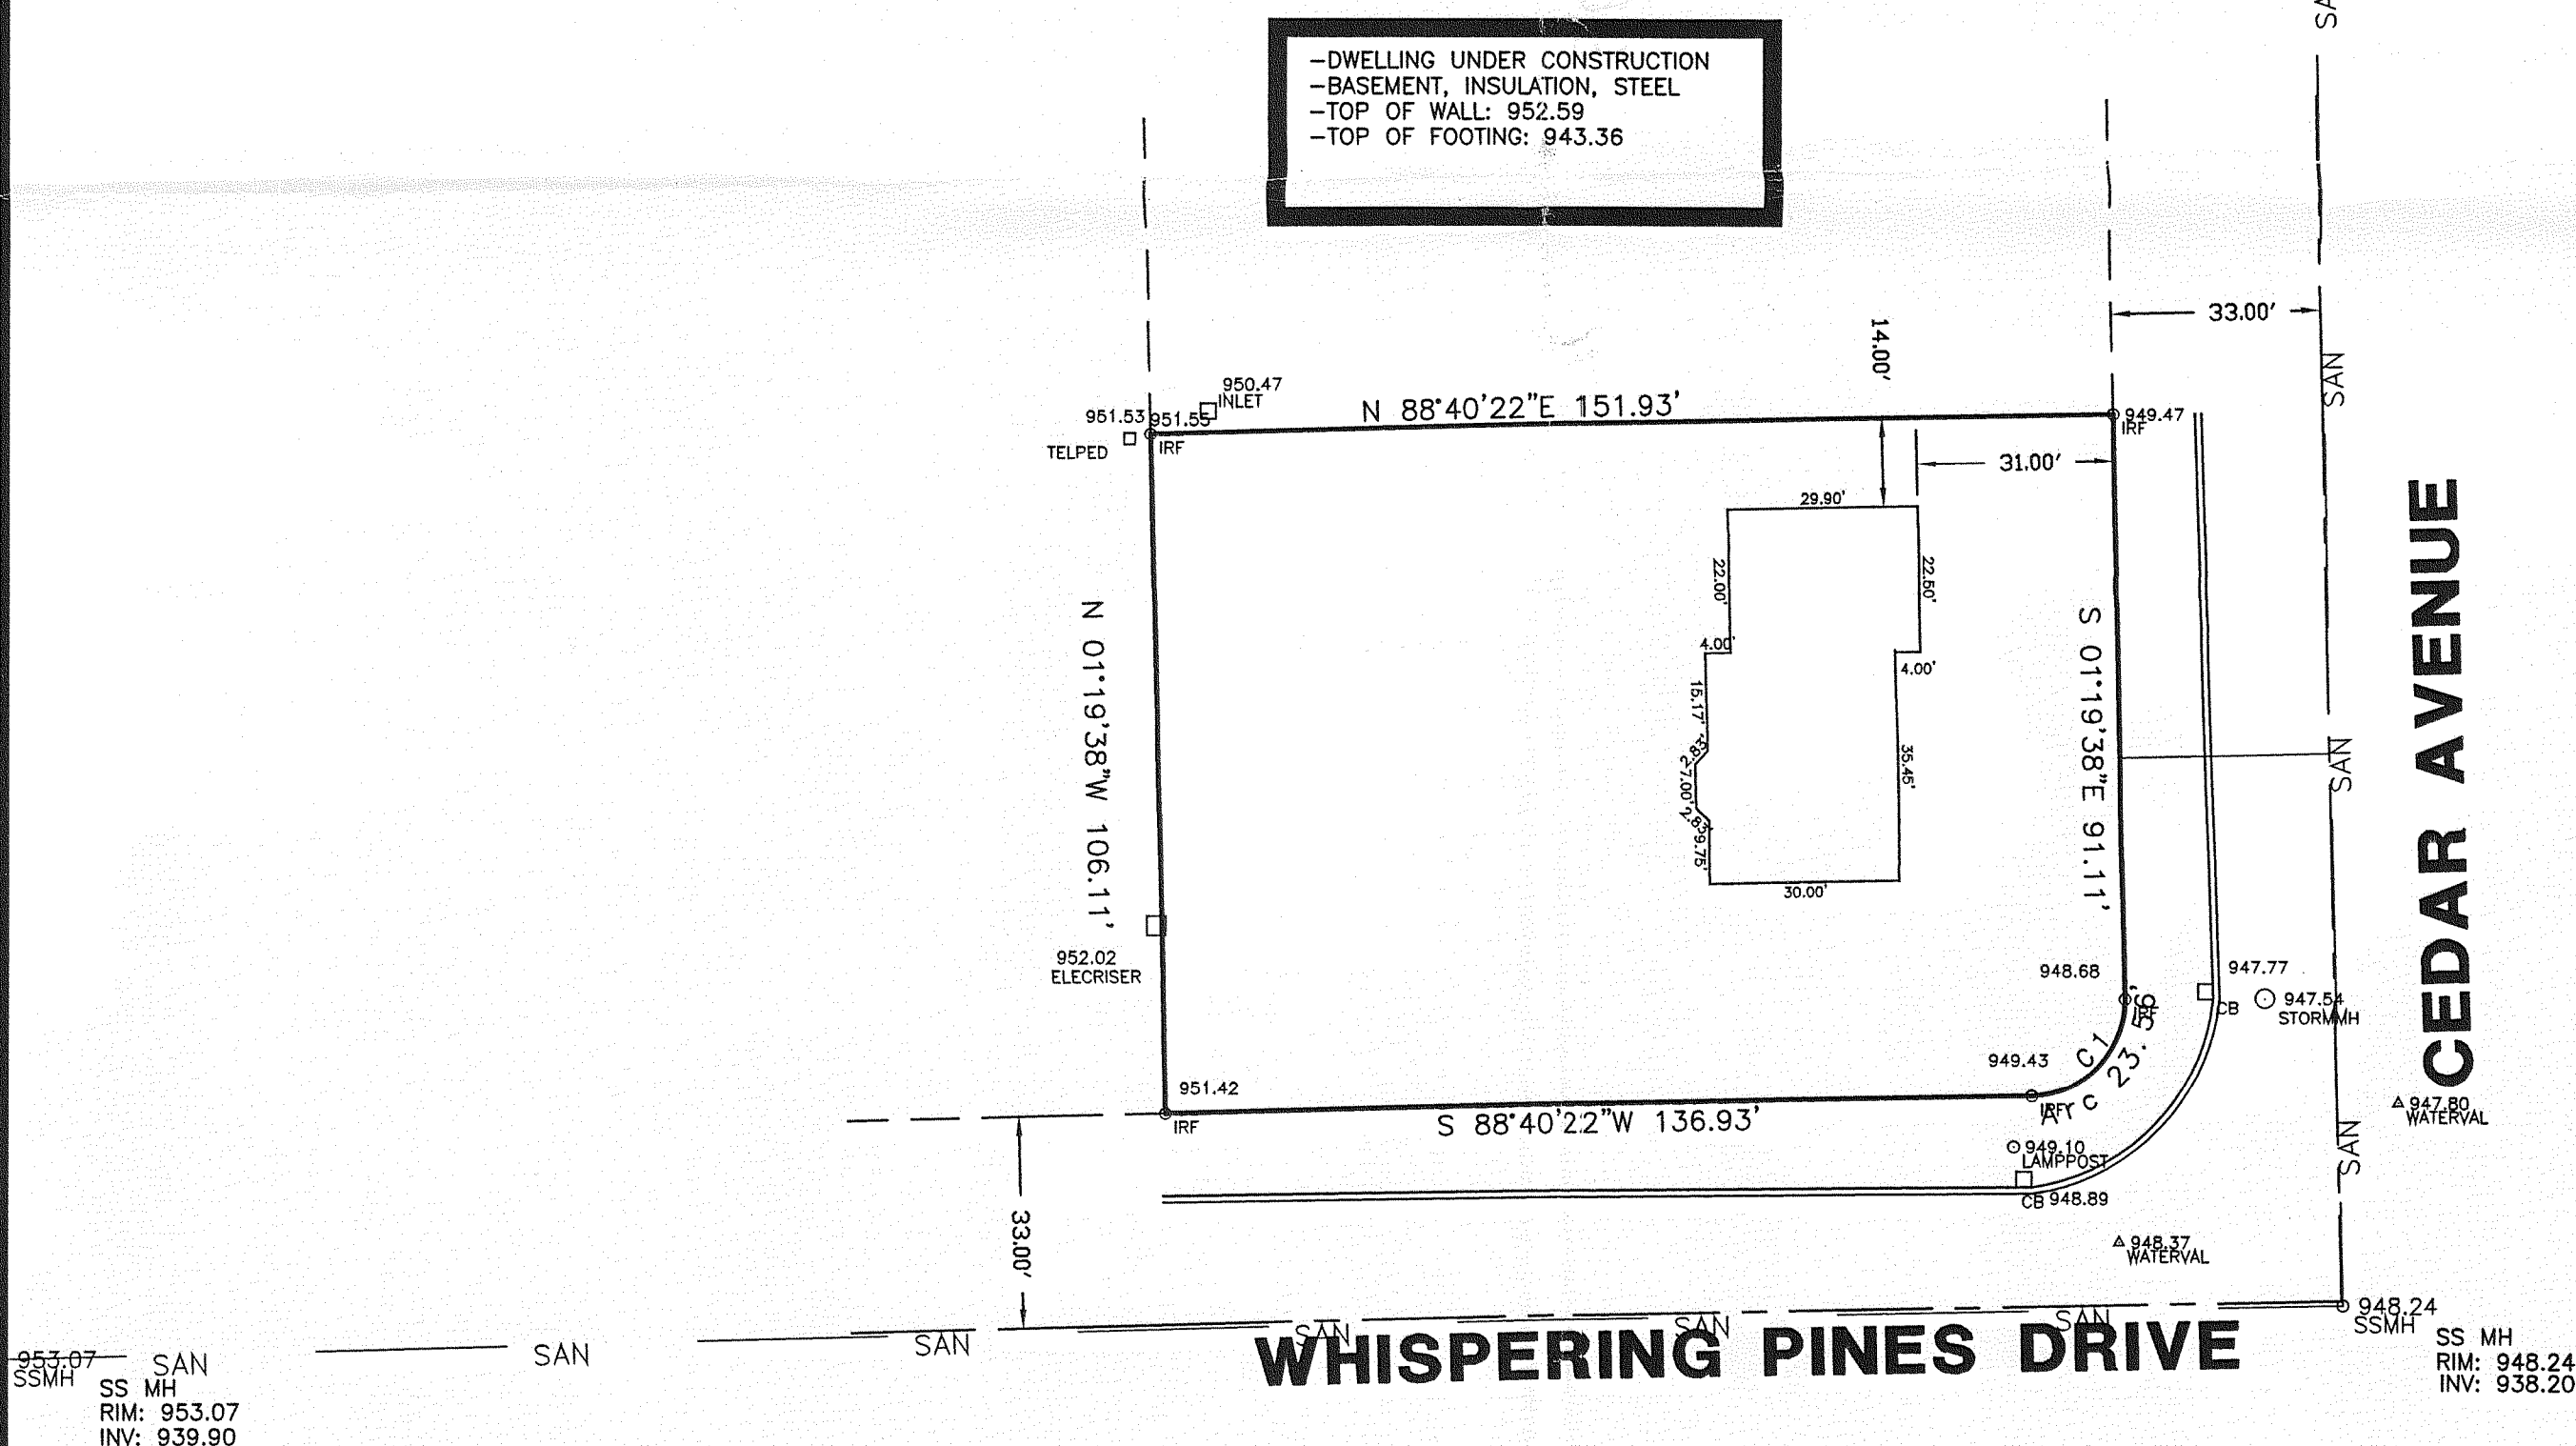

Curve	Radius	Tangent	Length	Delta	Chord	Chord Bear.
C1	15.00'	15.00'	23.56'	89°59'56"	21.21'	S 43°40'22" W

OWNERS: JASON & SUZIE LEINFELDER

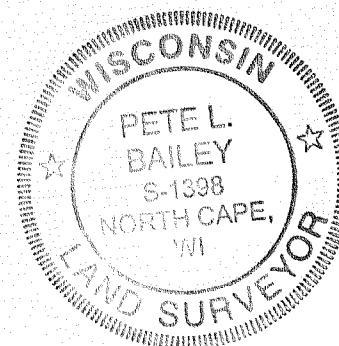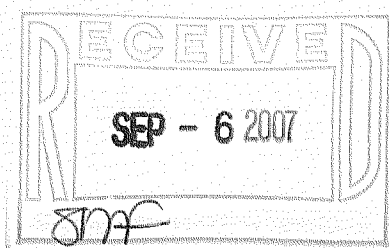

12207 C.T.H. "K" FRANKSVILLE, WISCONSIN 53126
TEL. (262) 835-4774 FAX: (262) 835-2379
beaufordbailey@hotmail.com

DRAWN BY:	PLB	REVISIONS: DATE 03/23/07: REVISED GARAGE SLAB CORRECTED CITY NAME
CHECKED BY:	PLB	
PLOT SCALE:	1 = 30	
DATE:	03/04/2007	
JOB NO.:	07.011	
DWG. FILE: JN207058R		CLIENT NO. 00010

CITY OF DELAVAN

PROJECT:

PLAT OF SURVEY/STAKE OUT SURVEY

PREPARED FOR: BADGER HOME BUILDERS, INC.

Sheet
1
of
1

XF1W-20

002-2396