PREPARED FOR EDWARD TERPSTRA 305 N. 7th ST. DELAVAN WI. 53115

PLAT OF SURVEY


-OF-

LOT 7 IN KATIE A. LATHROP'S SECOND ADDITION TO THE CITY OF DELAVAN, WALWORTH COUNTY, WISCONSIN. TOGETHER WITH THE WEST 1/2 OF THE ALLEY LYING EAST OF SAID LOT AND ABUTTING THEREON, WHICH HAS BEEN VACATED

KROTT SUR VEYING INC.

N3705 WILLOW BEND LANE
LAKE GENEVA WI. 53147
PHONE # (262)248-3697
FAX # (262)249-0639



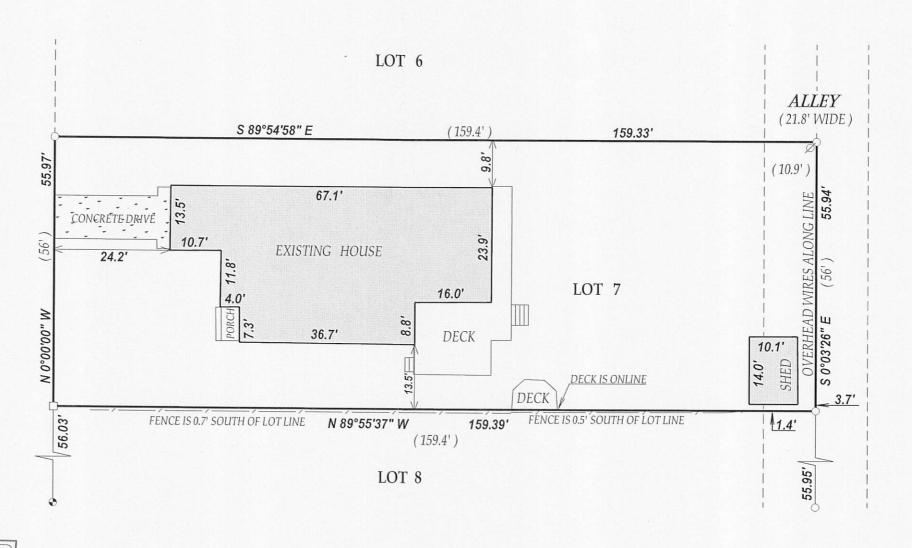

LEGEND


- O FOUND IRON PIPE
- □ FOUND IRON BAR
- FOUND CONCRETE MONUMENT

(XX) RECORDED AS

TAX D # XLA200004 JOB # 11-062 I have surveyed the above-described property and the above map is a true representation thereof and shows the size and location of the property, its exterior boundaries, the location and dimensions of all structures thereon, fences apparent easements and roadways and visible encroachments. if any.

This survey is made for the exclusive use of the present owners of the property, and also those who puchase, mortgage, or insure the title therto within one (1) year from date hereof; and as to them I warrant the accuracy of said survey map.

NOTE: BEARINGS ARE REFRENCED TO THE RECORD PLAT

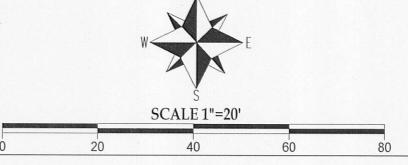



DATED THIS 10th DAY OF MAY 2011.

JOHN KROTT S - 2258
Wisconsin Registered Land Surveyor
(original if signed in red)

