


PLAT OF SURVEY  
-OF-

LOT 3 OF LAUREL HEIGHTS, A SUBDIVISION BEING LOCATED IN THE CITY OF DELAVAN,  
ACCORDING TO THE PLAT THEREOF, RECORDED IN VOLUME 12 OF PLATS ON PAGE 34,  
WALWORTH COUNTY, WISCONSIN.

SURVEY FOR: BEAR REALTY

SURVEY ADDRESS: 512 LAUREL HEIGHTS DRIVE

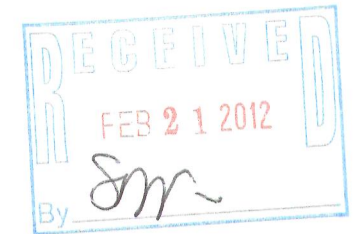


LAUREL HEIGHTS DRIVE  
(75' WIDE)

BEARINGS HEREON RELATE TO THE NORTHERLY LINE  
OF LOT 3 OF LAUREL HEIGHTS SUBDIVISION. ASSUMED  
BEARING OF SOUTH 79°26'00" EAST AS PLATTED.

"I HEREBY CERTIFY THAT I HAVE SURVEYED THE ABOVE  
DESCRIBED PROPERTY AND THAT THE ABOVE MAP IS A CORRECT  
REPRESENTATION THEREOF AND SHOWS THE SIZE AND LOCATION  
OF THE PROPERTY, ITS EXTERIOR BOUNDARIES, THE LOCATION  
OF ALL VISIBLE STRUCTURES AND DIMENSIONS OF ALL  
PRINCIPAL BUILDINGS THEREON, BOUNDARY FENCES, APPARENT  
EASEMENTS, ROADWAYS AND ENCROACHMENTS, IF ANY."

"THIS SURVEY IS MADE FOR THE USE OF THE PRESENT OWNERS  
OF THE PROPERTY, AND THOSE WHO PURCHASE, MORTGAGE, OR  
GUARANTEE THE TITLE THERETO WITHIN ONE YEAR FROM DATE  
HEREOF."

**SATTER SURVEYING, LLC**  
LAND SURVEYS, MAPPING AND PLANNING  
272 ORIGEN STREET  
BURLINGTON, WI 53105  
262-661-4239

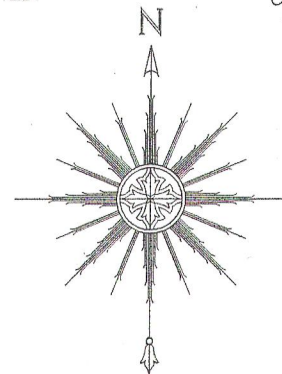

0 15' 30' 60'  
SCALE: 1" = 30'

LEGEND

- FOUND IRON PIPE
- ⊕ UTILITY POLE
- UTILITY BOX
- ( ) RECORDED AS

THIS IS NOT AN ORIGINAL PRINT  
UNLESS THIS SEAL IS RED.

*Thomas L. Satter*  
THOMAS L. SATTER S-2850

FEBRUARY 3, 2012  
DATE

011205  
JOB NUMBER



XL14-3

002-2515