


#179-65

EIGHTH STREET.

OAK

STREET.

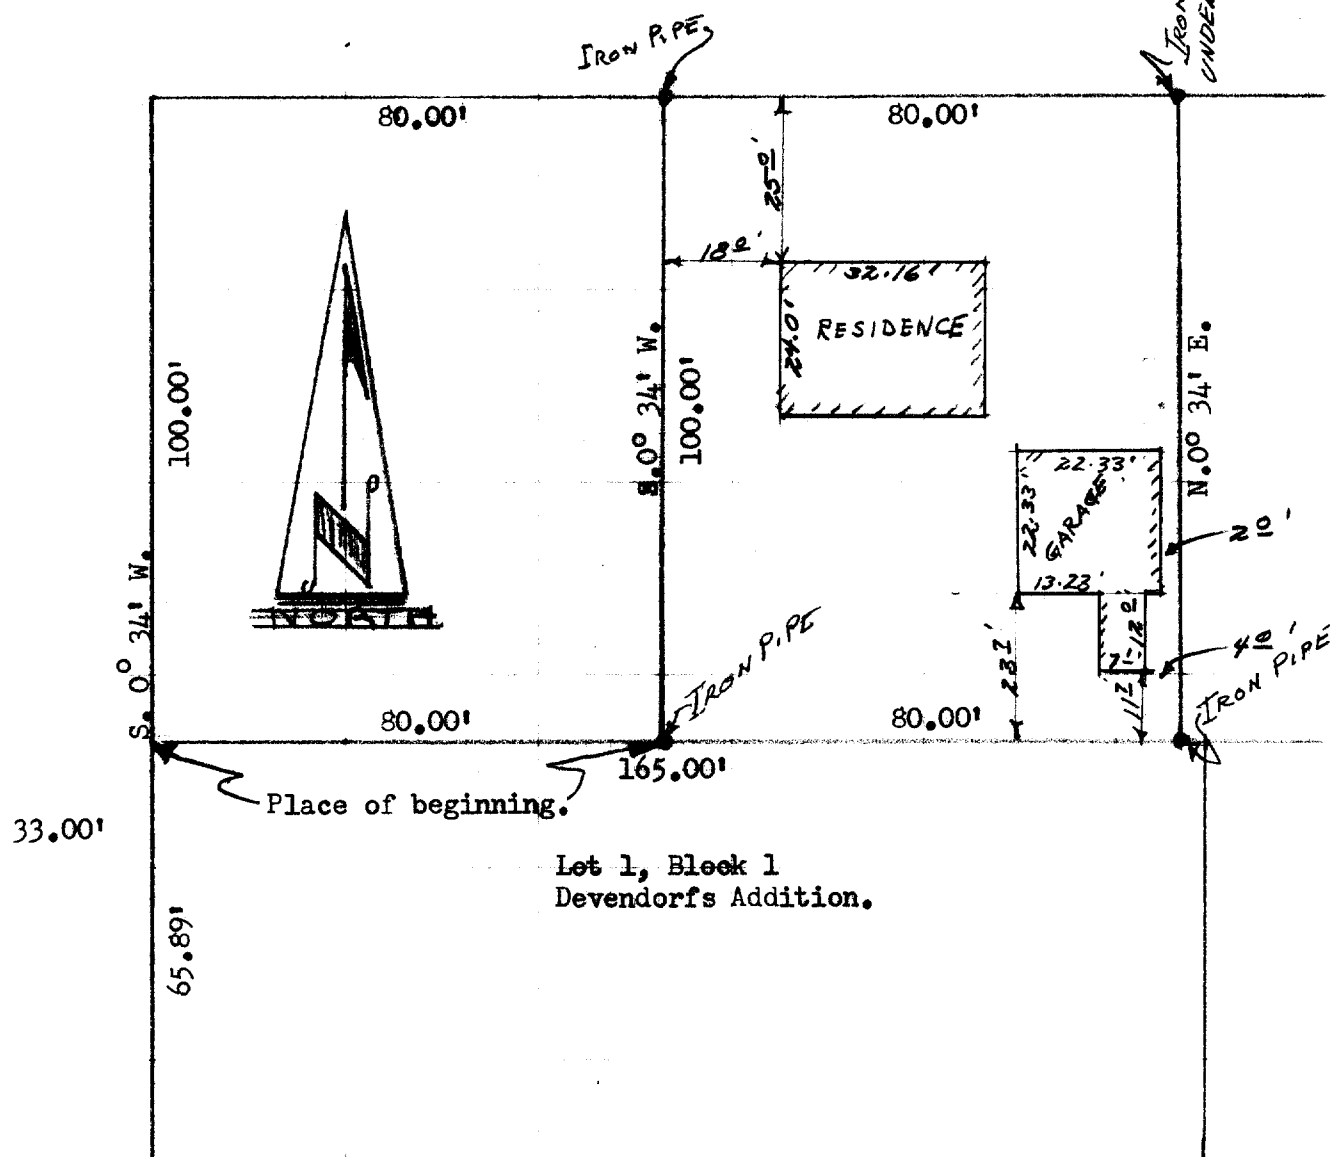

Lot 1, Block 1
Devendorfs Addition.

DESCRIPTION: A parcel of land in the N.W. $\frac{1}{4}$ of Section 17 Town 2 north, Range 16 east City of Delavan Walworth County, Wisconsin, described as follows to-wit: Commencing at the Northwest corner of Lot 1, Block 1 Devendorfs Addition to the City of Delavan, Walworth County, Wisconsin, thence Easterly along the north line of said Lot 1, 80.00 feet to the place of beginning, thence continue Easterly along the North line of said Lot 1, 80.00 feet to a point, thence N. $0^{\circ} 34'$ E., parallel to the East line of Eighth Street 100.00 feet to the South line of Oak Street, thence Westerly along the South line of Oak Street 80.00 feet to a point, thence S. $0^{\circ} 34'$ W. parallel to the East line of Eighth Street 100.00 feet to the place of beginning.

CERTIFICATE: I, James F. Biagi, Surveyor, do hereby certify that I have surveyed the property hereon described and that the location of the improvements are as shown.

James F. Biagi. RLS 272
Elkhorn, Wisconsin.

Dated: June 11th 1965.

X UP-42B
" 42E

2-31B