


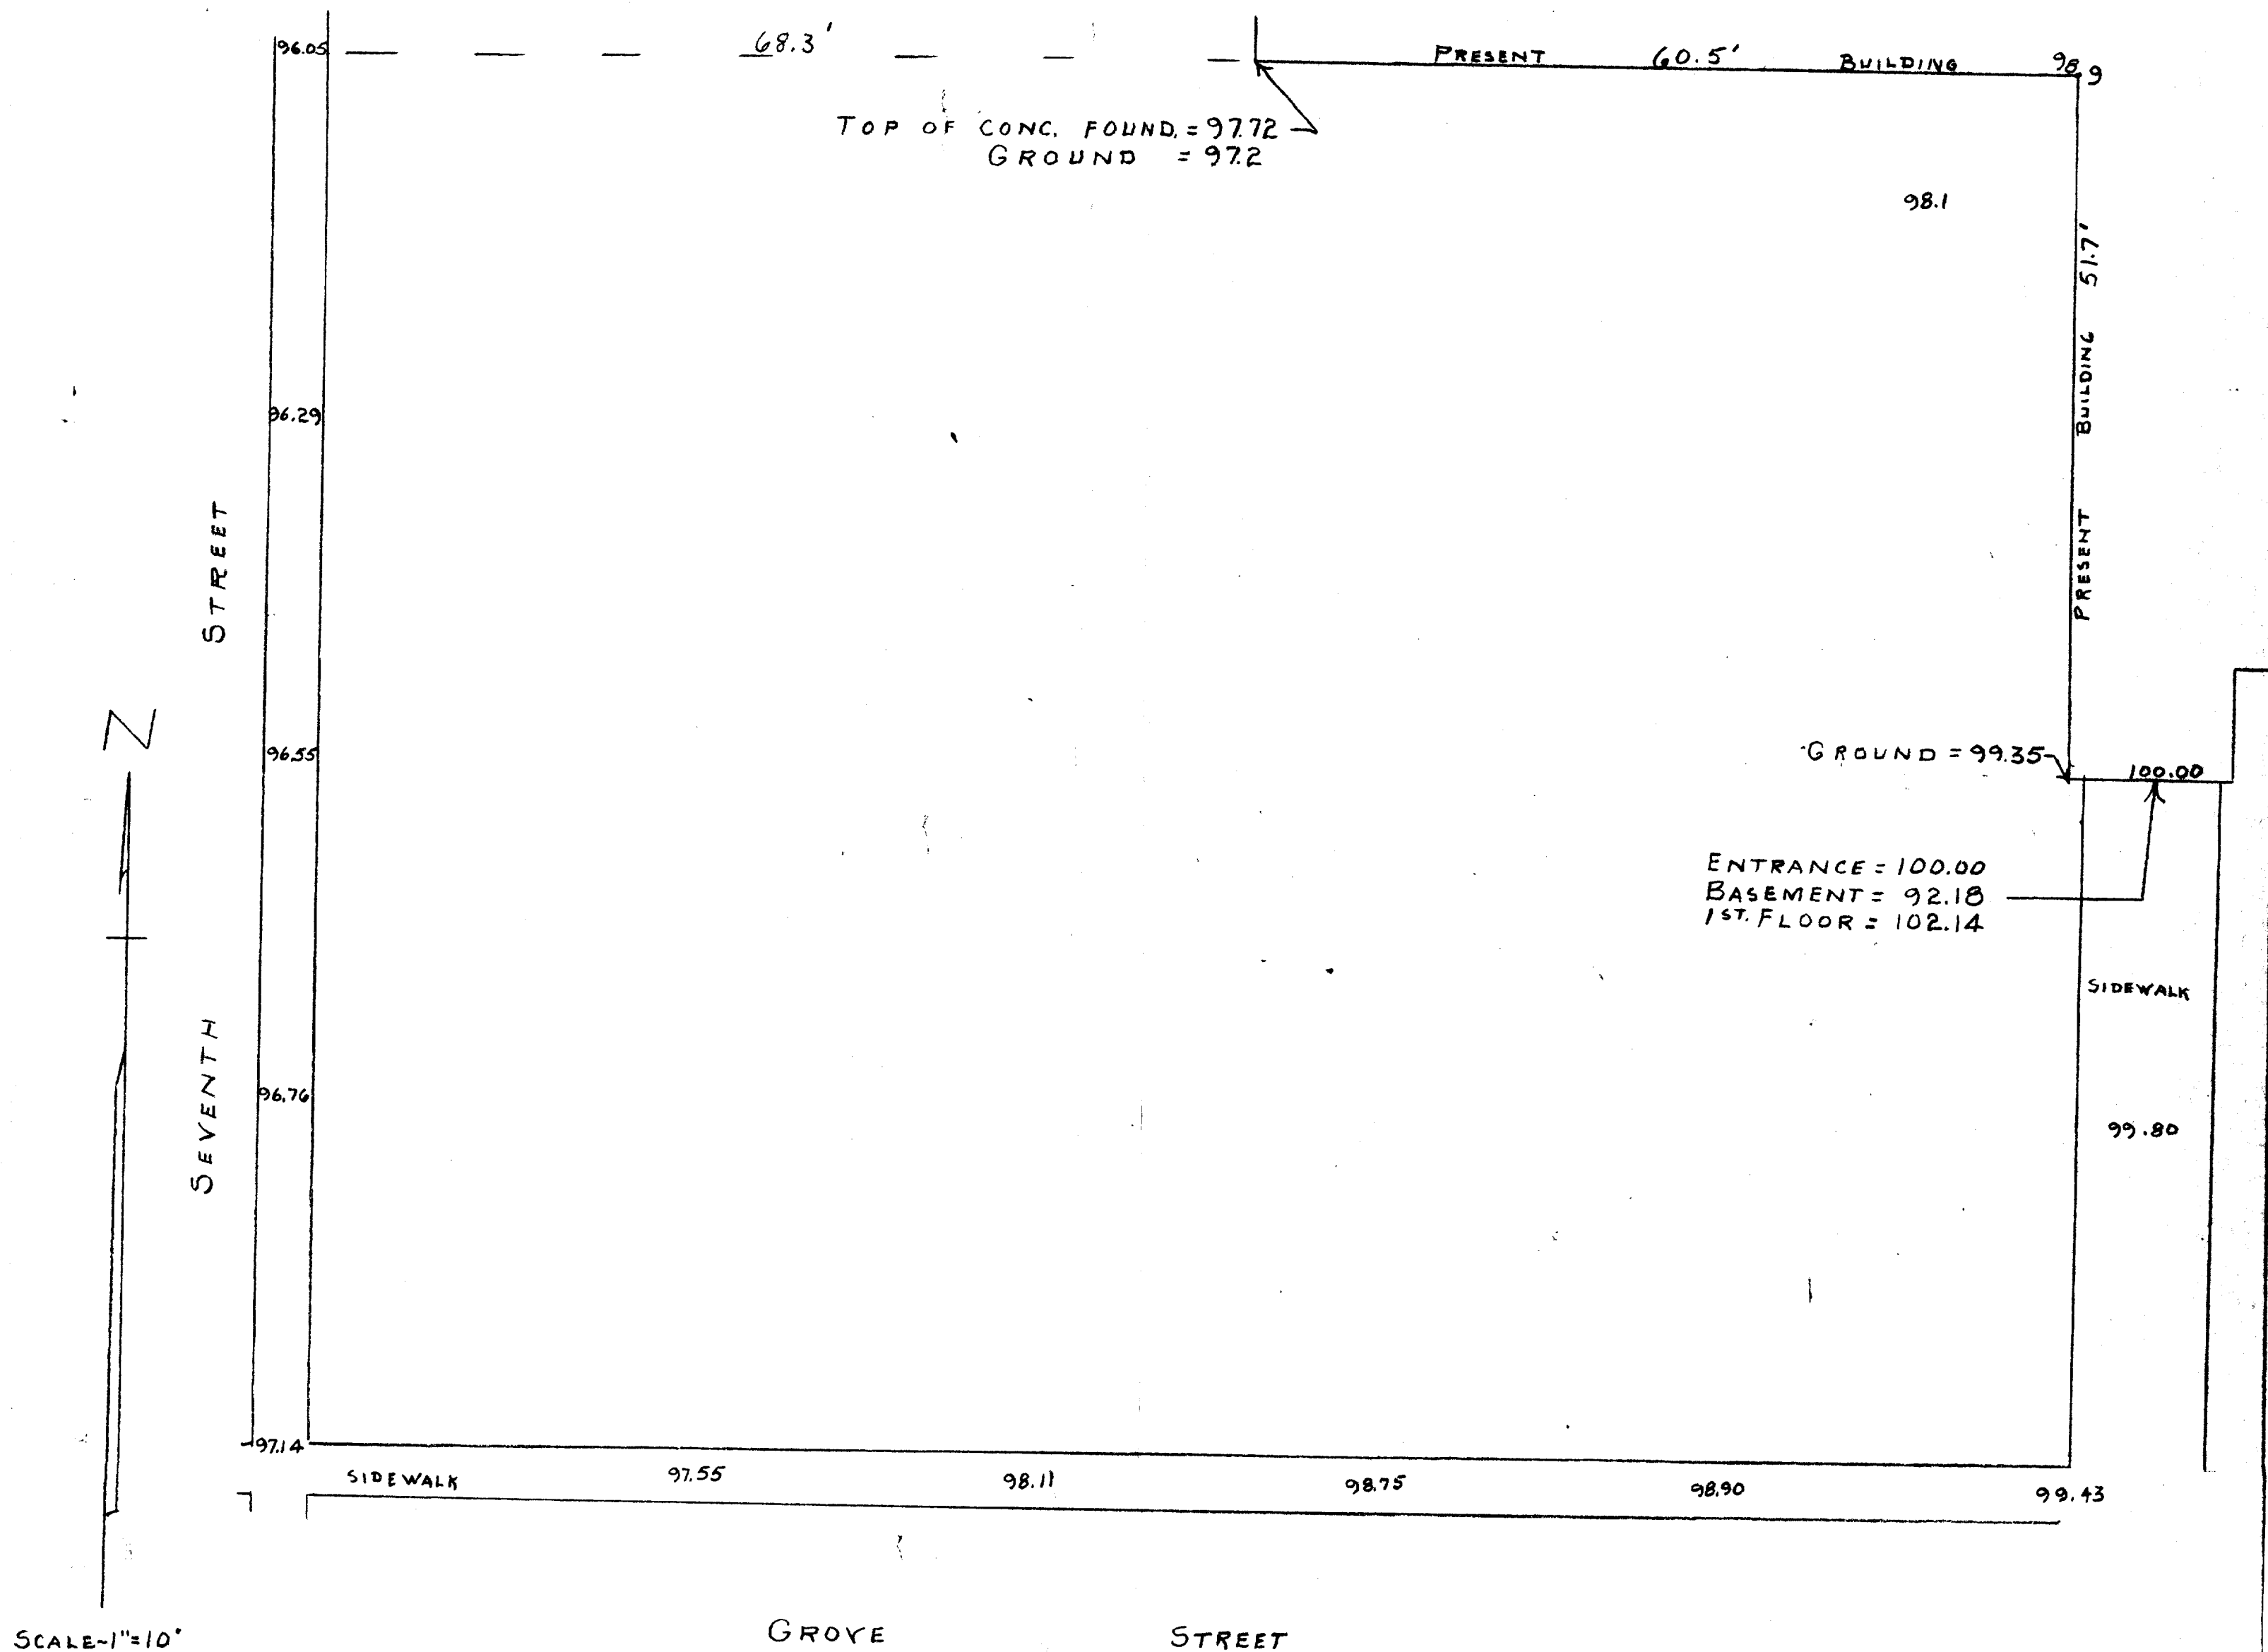

SIDEWALK AND GROUND ELEVATIONS ON LAND AT THE
CORNER OF SEVENTH AND GROVE STREETS, CITY OF
DELAVER, WISCONSIN
FEB. 17, 1956

XPA-5 - (elevation for sidewalk)

George T. Dunham
GEORGE T. DUNHAM, SURVEYOR

2-34