


N

⑥ = Iron Pipe

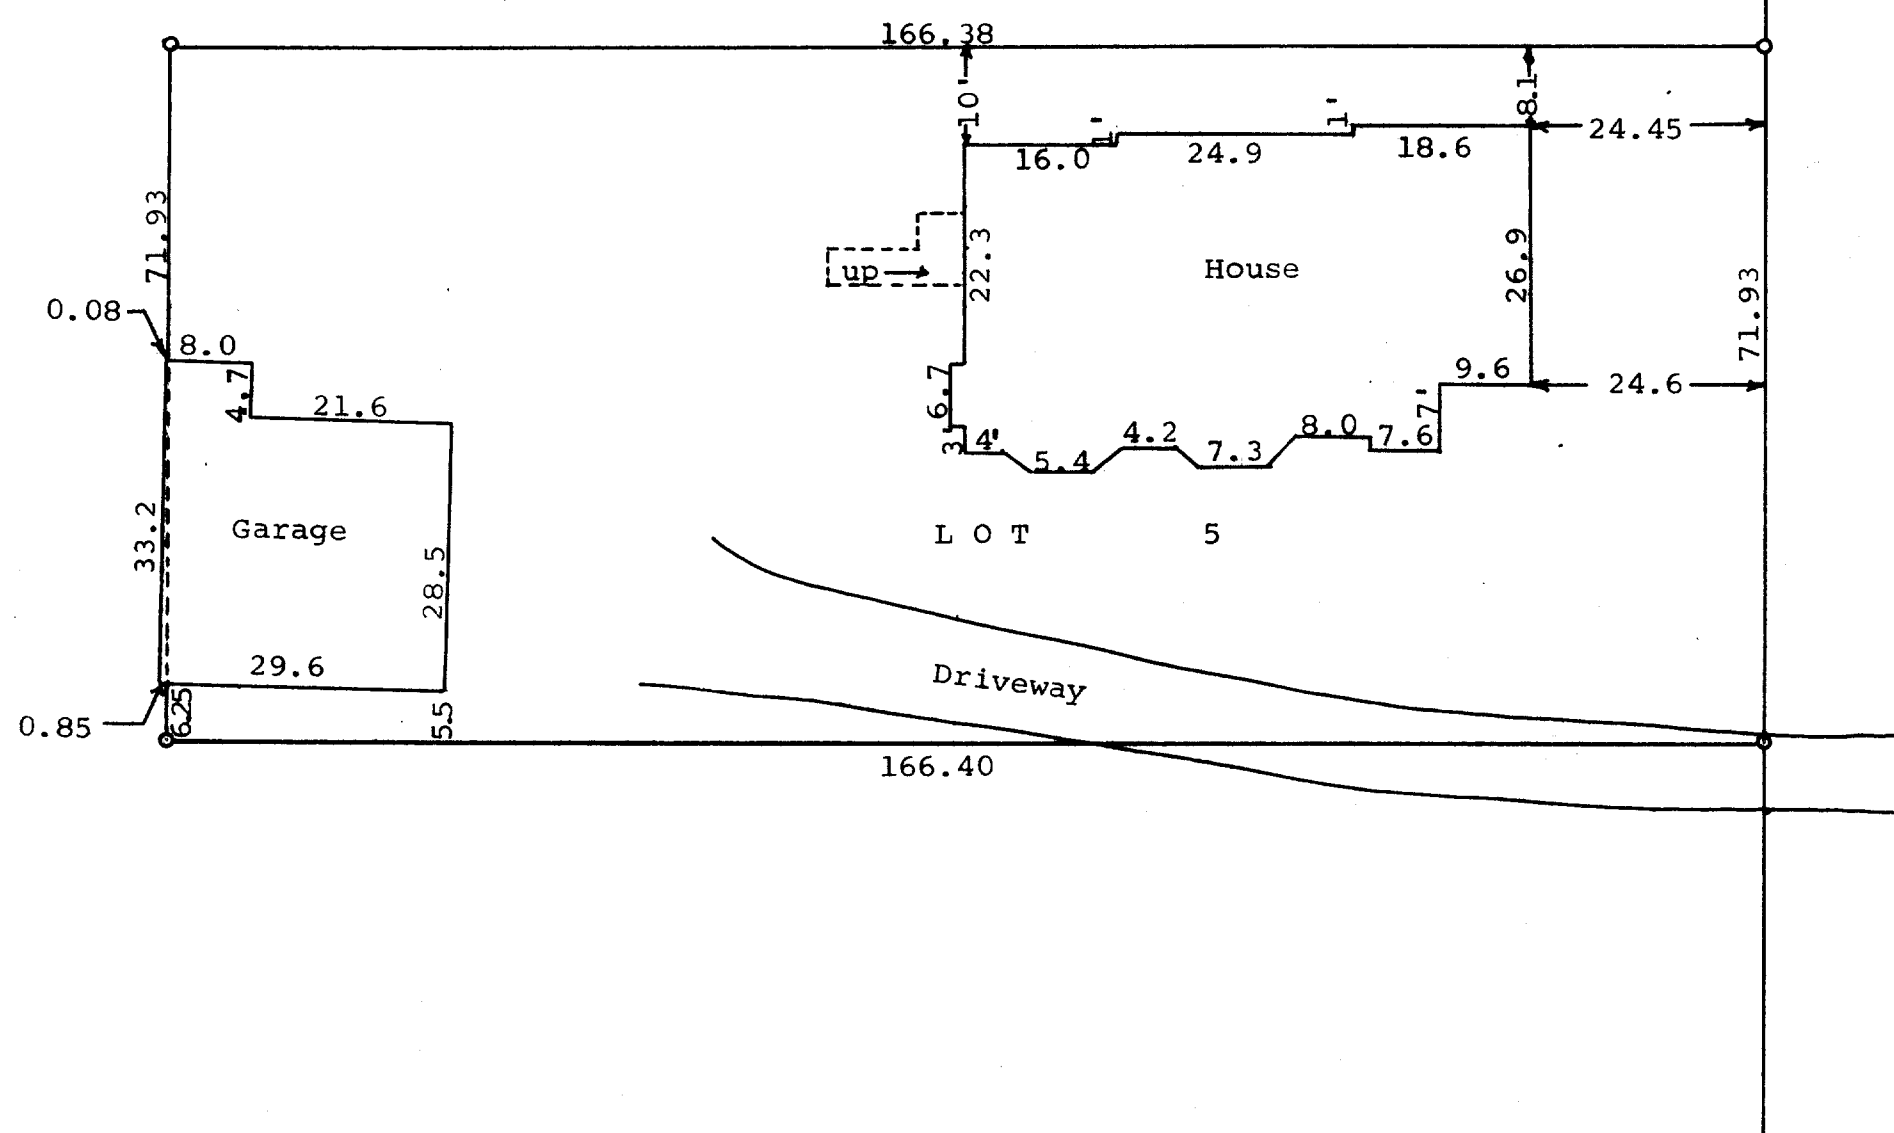

July 14, 1967

George T. Dunham
George T. Dunham, Surveyor