


GEORGE T. DUNHAM
SURVEYING & SUBDIVIDING
DELAVER, WISCONSIN

N

MCDOWELL

STREET

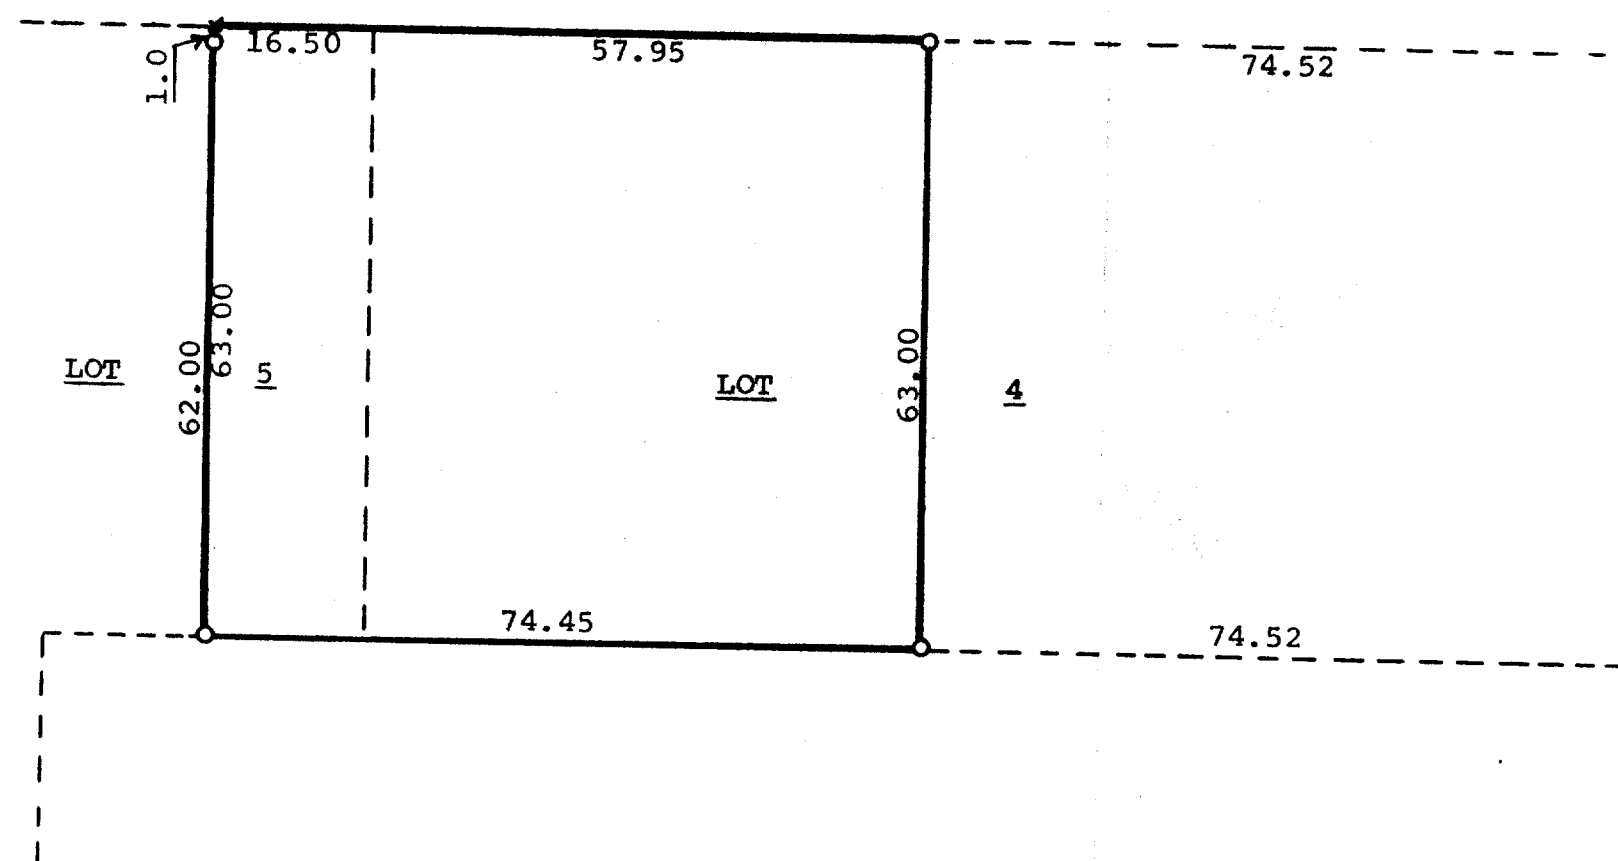

STREET

SEVENTH

Plat of survey of Lot 4 and part of Lot 5 of Bell's
Subdivision, City of Delavan, Walworth County, Wisconsin.
November 11, 1970

George T. Dunham
George T. Dunham, Surveyor