


GEORGE T. DUNHAM
SURVEYING & ENGINEERING
DELAVER, WISCONSIN

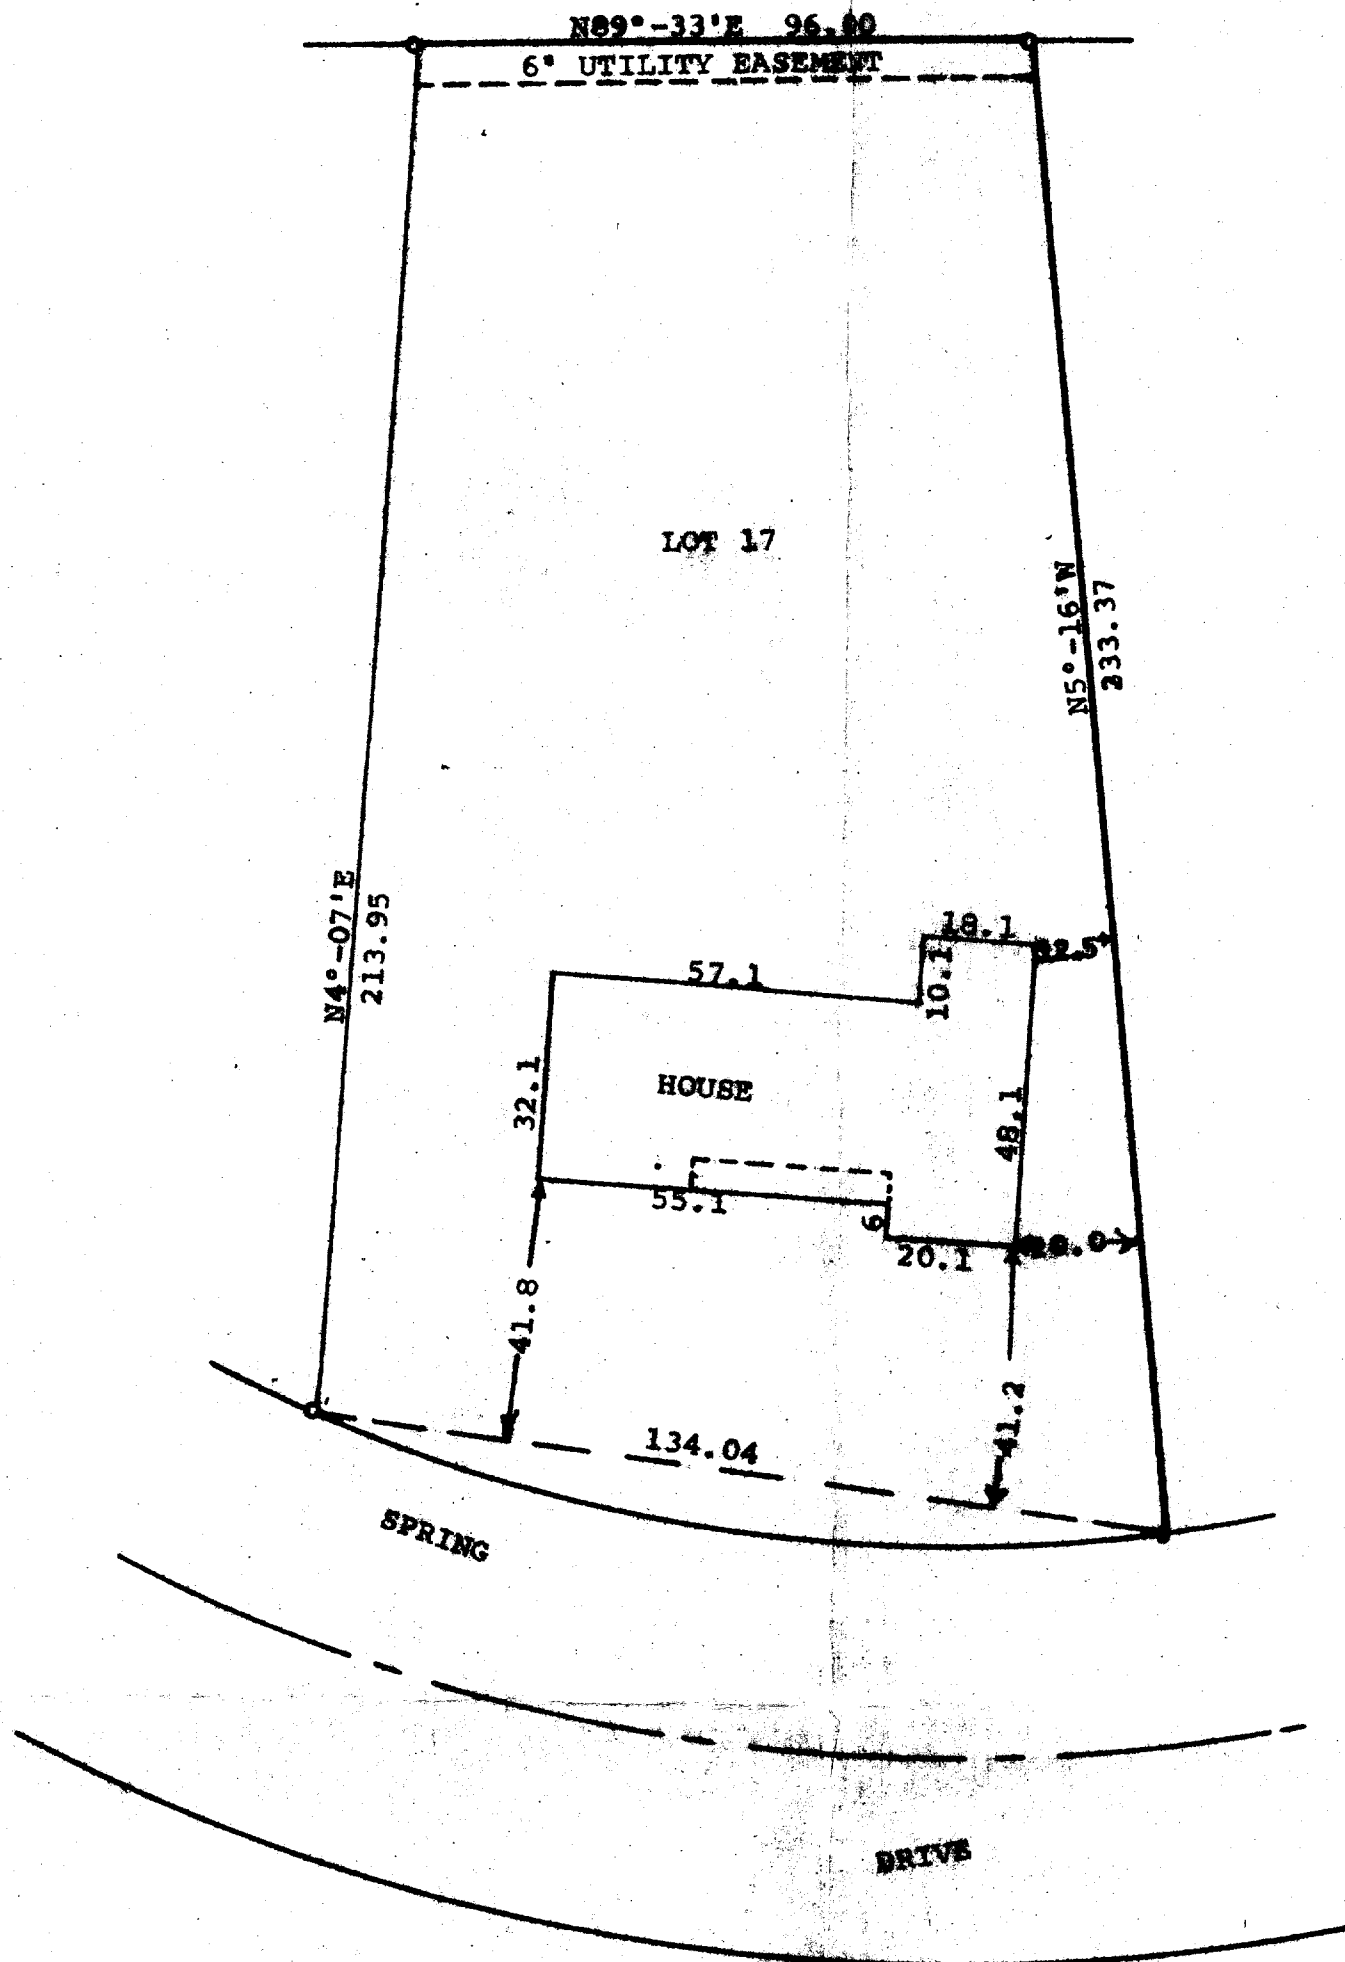

Scale- 1" = 30'
● = Iron Pipe

STATE OF WISCONSIN) ss
COUNTY OF WALWORTH) ss
I, George T. Dunham, Surveyor, certify that I have surveyed the property described as follows:
Lot 17, Block 5 of Spring Lake Subdivision Addition No. 2 located in the City of Delavan, Walworth County, Wisconsin,
and that the plat shown above is an accurate survey and a true representation thereof and correctly shows the exterior boundary lines and location of the building on said property and the correct measurements thereof and that there are no encroachments along any of the property lines.
May 19, 1972

George T. Dunham
George T. Dunham, Surveyor

