


854-2

42-9

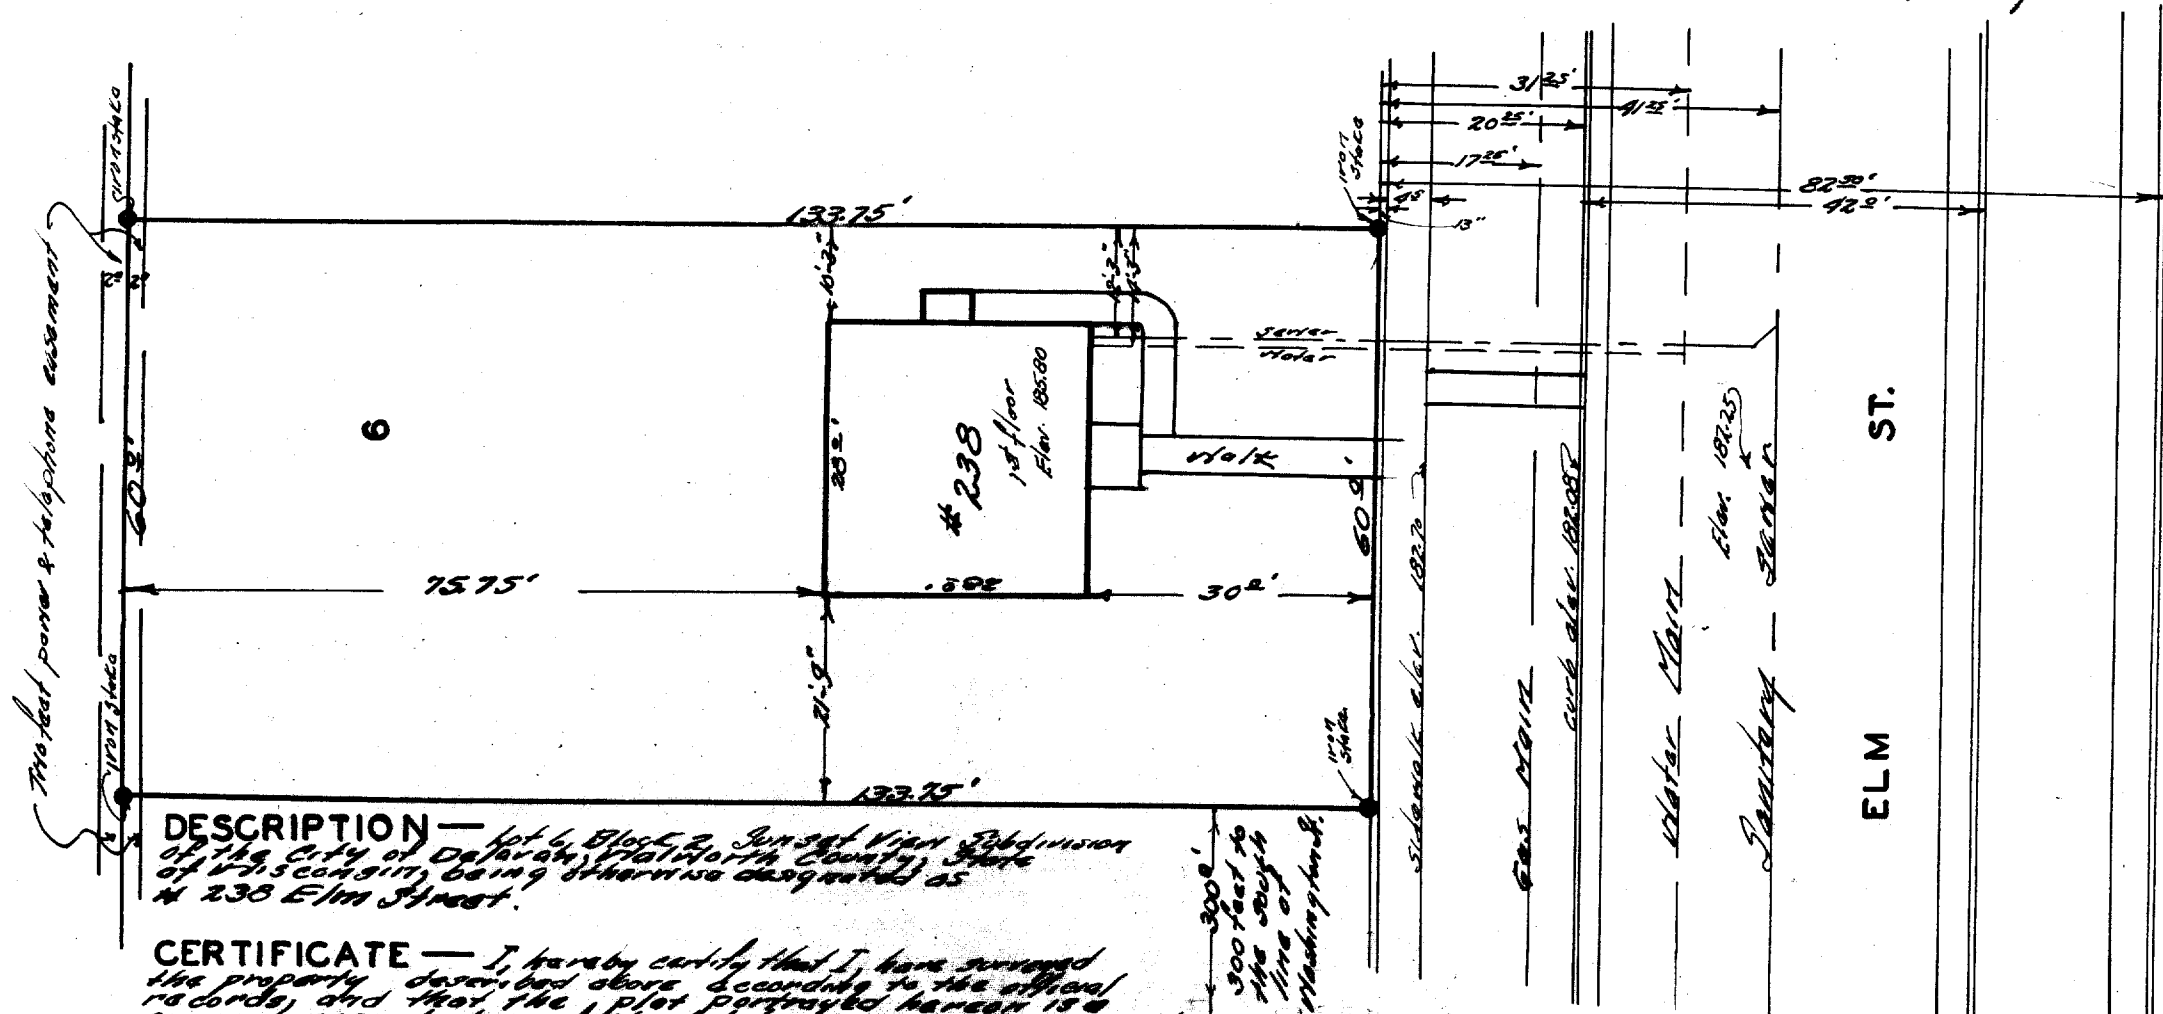

DESCRIPTION — Lot 6, Block 2, Sunset View Subdivision of the City of Delavan, Walworth County, State of Wisconsin, being otherwise designated as # 238 Elm Street.

CERTIFICATE — I, hereby certify that I have surveyed the property described above according to the official records, and that the plat portrayed hereon is a correct reproduction of the lot lines and measurements and the principal lines and measurements of all buildings and other structures.

Signed this 28th day of May 1943

Joseph M. Bisi
Joseph M. Bisi
Delavan Wis.

PLAT OF SURVEY
OF
LOT 6 BLOCK 2
SUNSET VIEW SUBDIVISION
DELAVER WIS.

2-47B

XSV-12A