



North line of Lot 11-Block 1 of
J.B. Derendorf's Addition

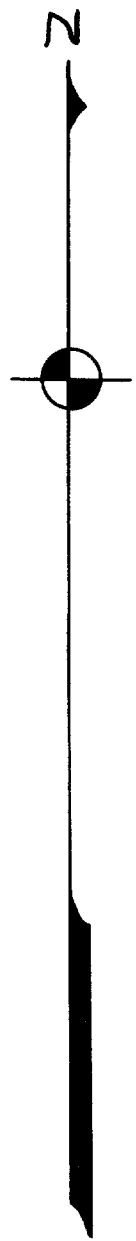

8th STREET

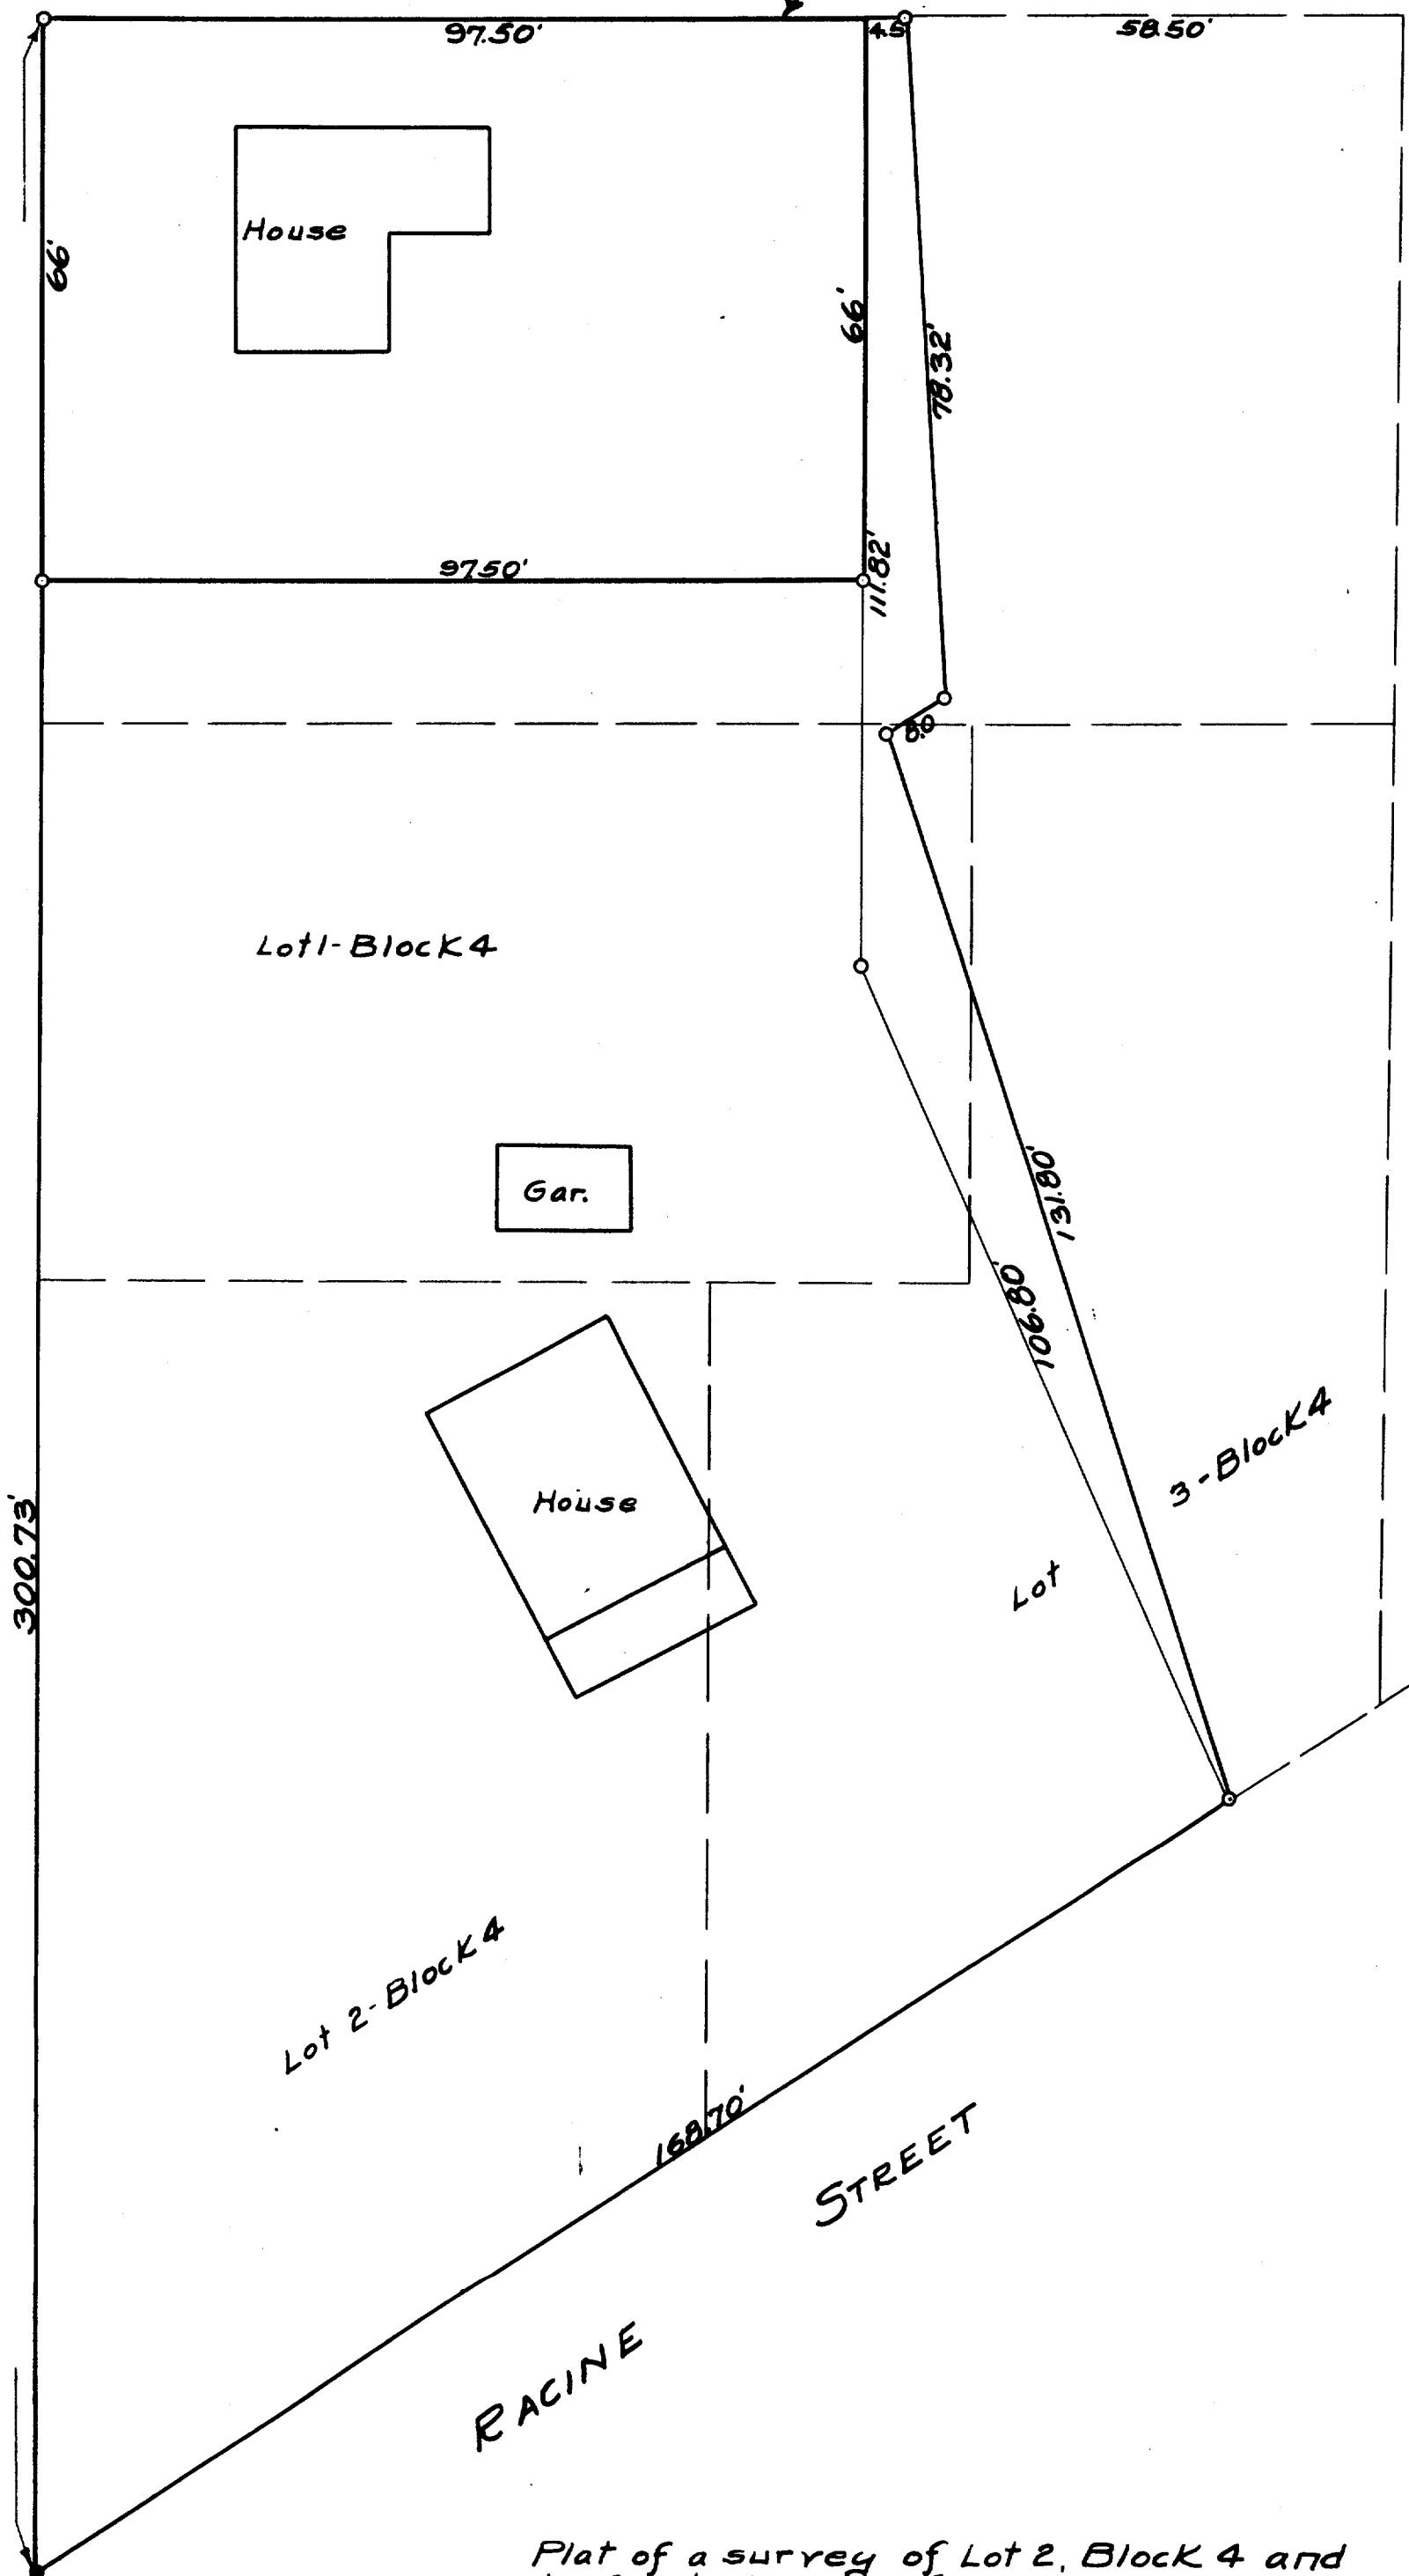

Plat of a survey of Lot 2, Block 4 and
part of Lots 1 and 3 of Block 4, and part
of Lot 11, Block 1 all of J.B. Derendorf's
Addition to the City of Delavan, Wis.
Scale 1" = 20 feet
July 1935

• - Conc. Monu.
o - Iron pipe

Lloyd P. Jensen
County Surveyor 2-45