


GEORGE T. DUNHAM  
SURVEYING & SUBDIVISIONS  
DELAVER, WISCONSIN

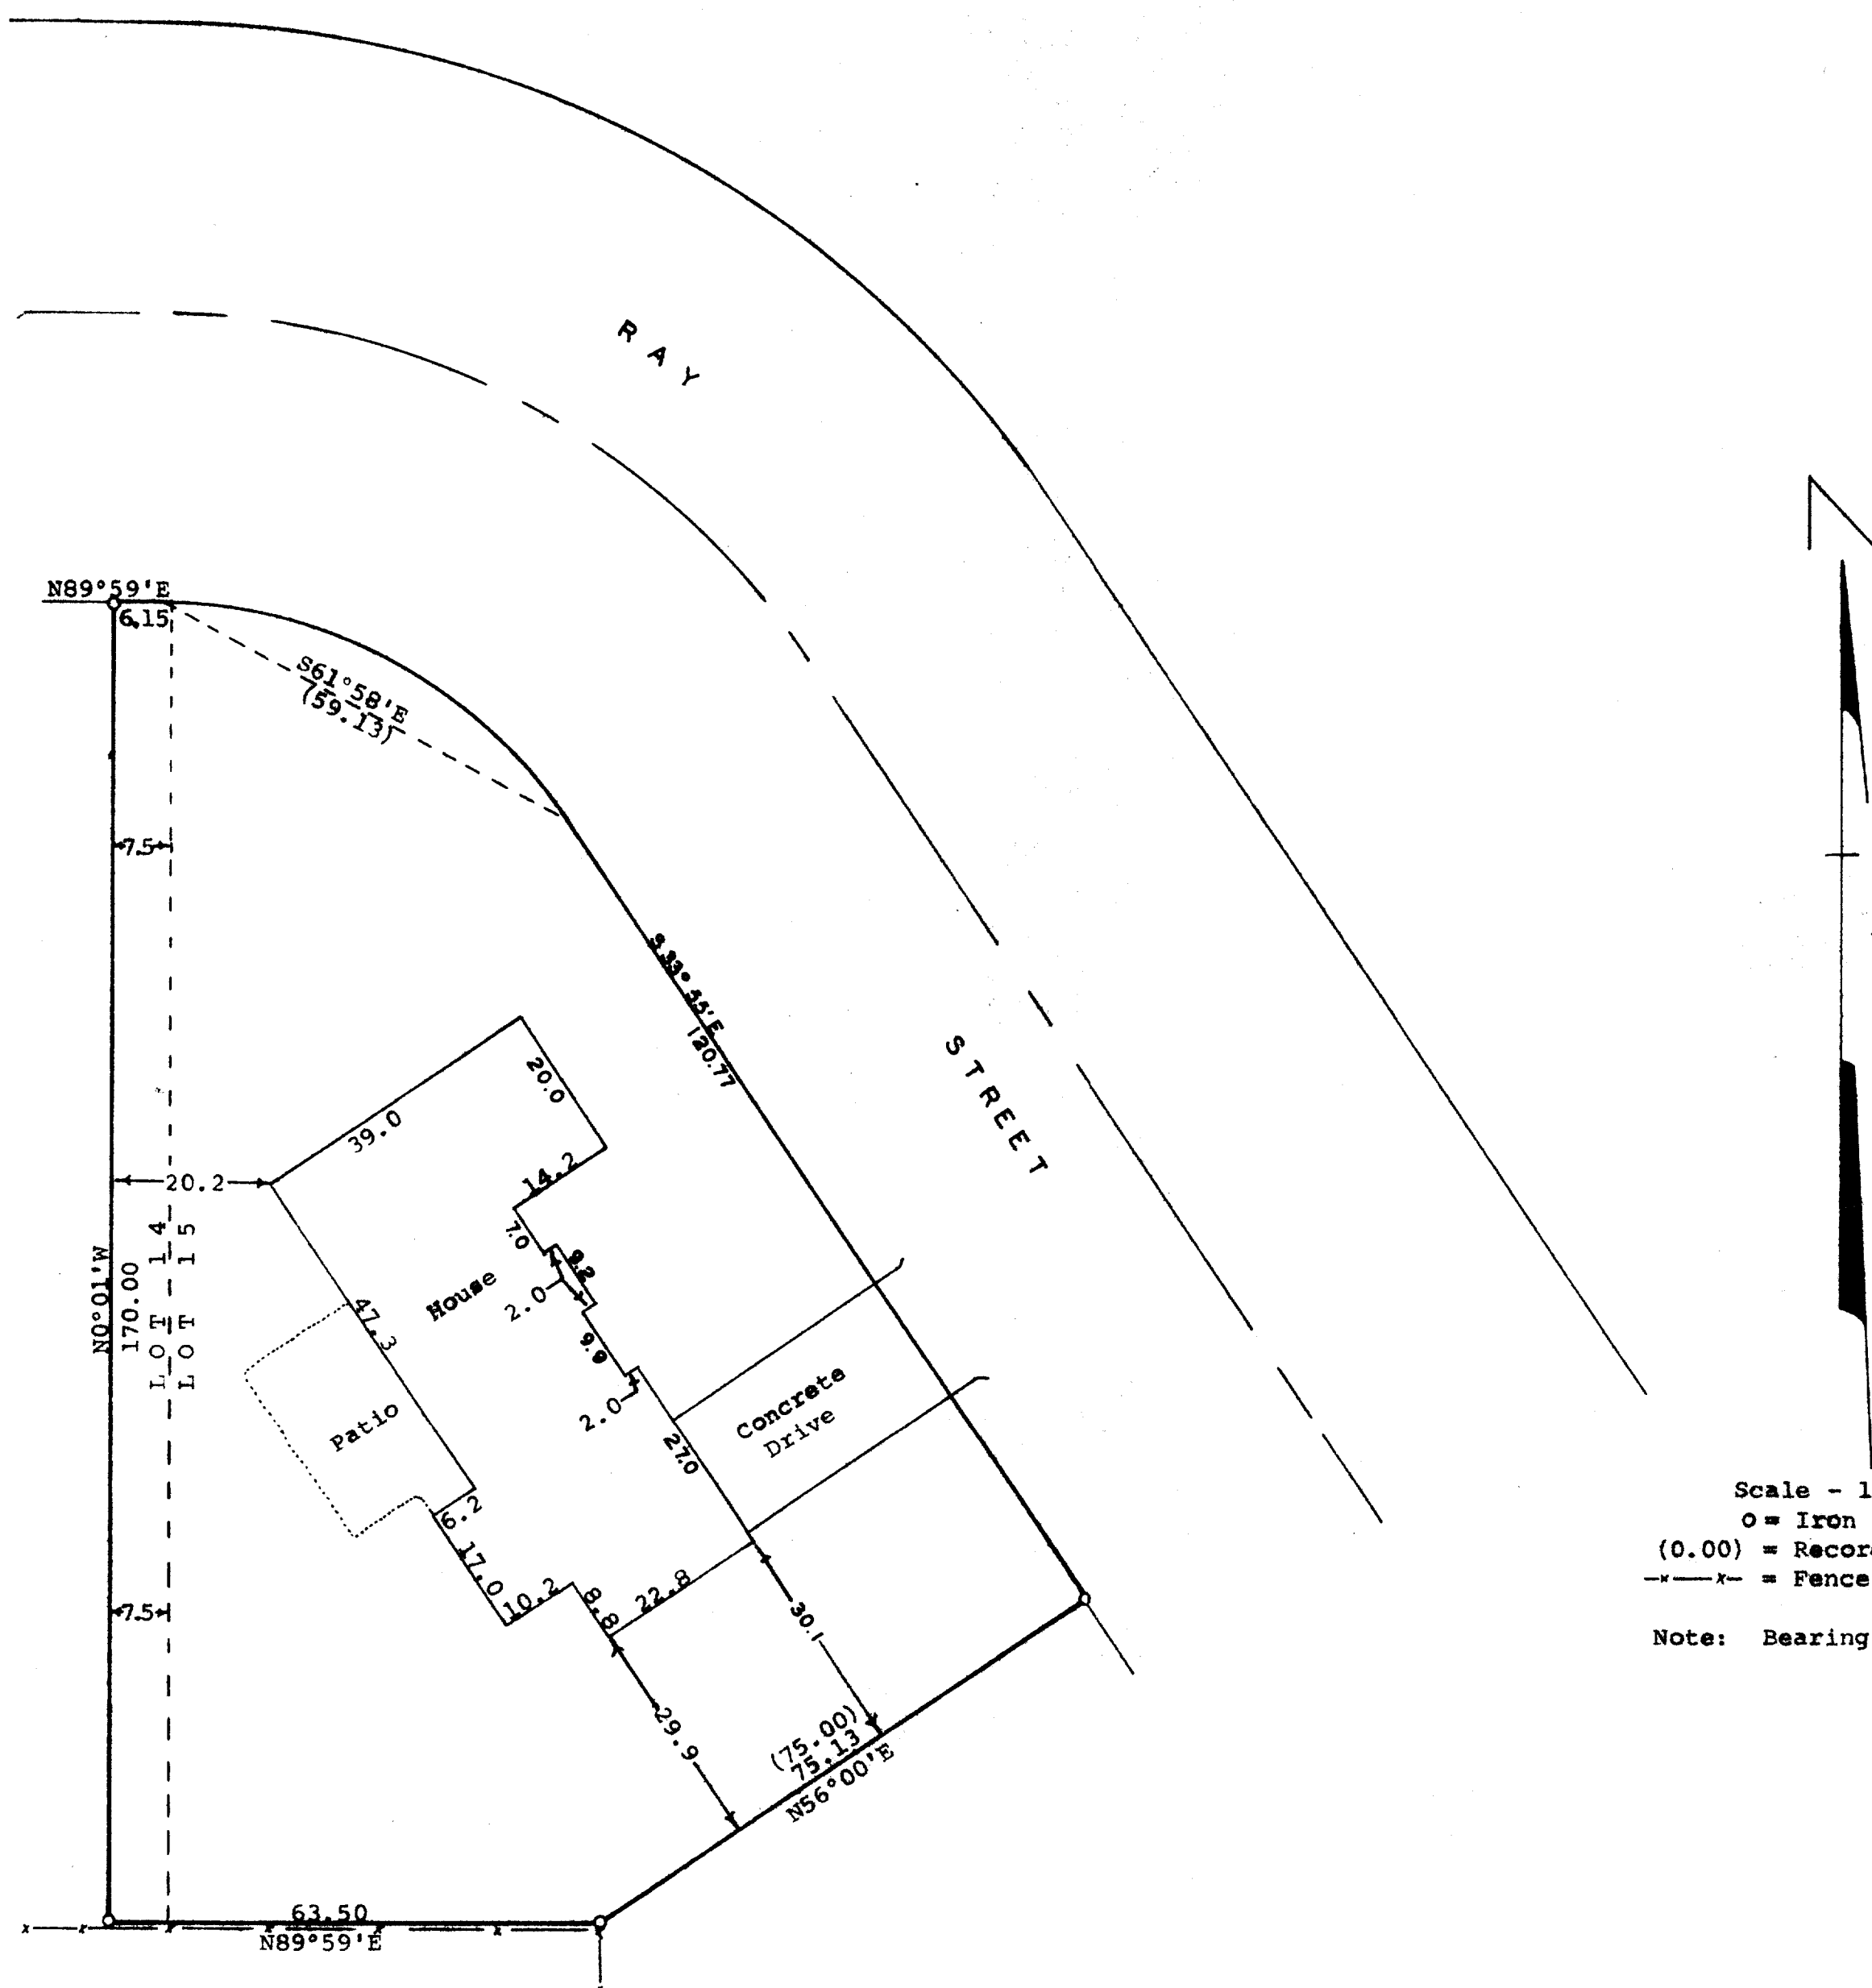

Scale - 1" = 20'  
O = Iron Pipe Found  
(0.00) = Recorded Distance  
--- = Fence Line

Note: Bearings taken from recorded plat.

STATE OF WISCONSIN)  
COUNTY OF WALWORTH) SS

I, George T. Dunham, Surveyor, certify that I have surveyed the property described as follows,

Lot 15 and a strip of land 7.50 feet in width off the Easterly side of Lot 14, all in Laurel Heights, a subdivision located in the Northeast  $\frac{1}{4}$  of the Northwest  $\frac{1}{4}$  of Section 17, T2N, R16E, City of Delavan, Walworth County, Wisconsin.

and that the above map is a true representation thereof and shows the size and location of the property, its exterior boundaries, the location and dimensions of all structures thereon, fences, apparent easements and roadways and visible encroachments, if any.

This survey is made for the exclusive use of the present owners of the property, and also those who purchase, mortgage, or guarantee the title thereto within one (1) year from date hereof; and as to them I warrant the accuracy of said survey and map.

July 22, 1976

*George T. Dunham*  
George T. Dunham, Surveyor

