


LUDWIG ST.

66.0'

ST.

BARNES

66.0'

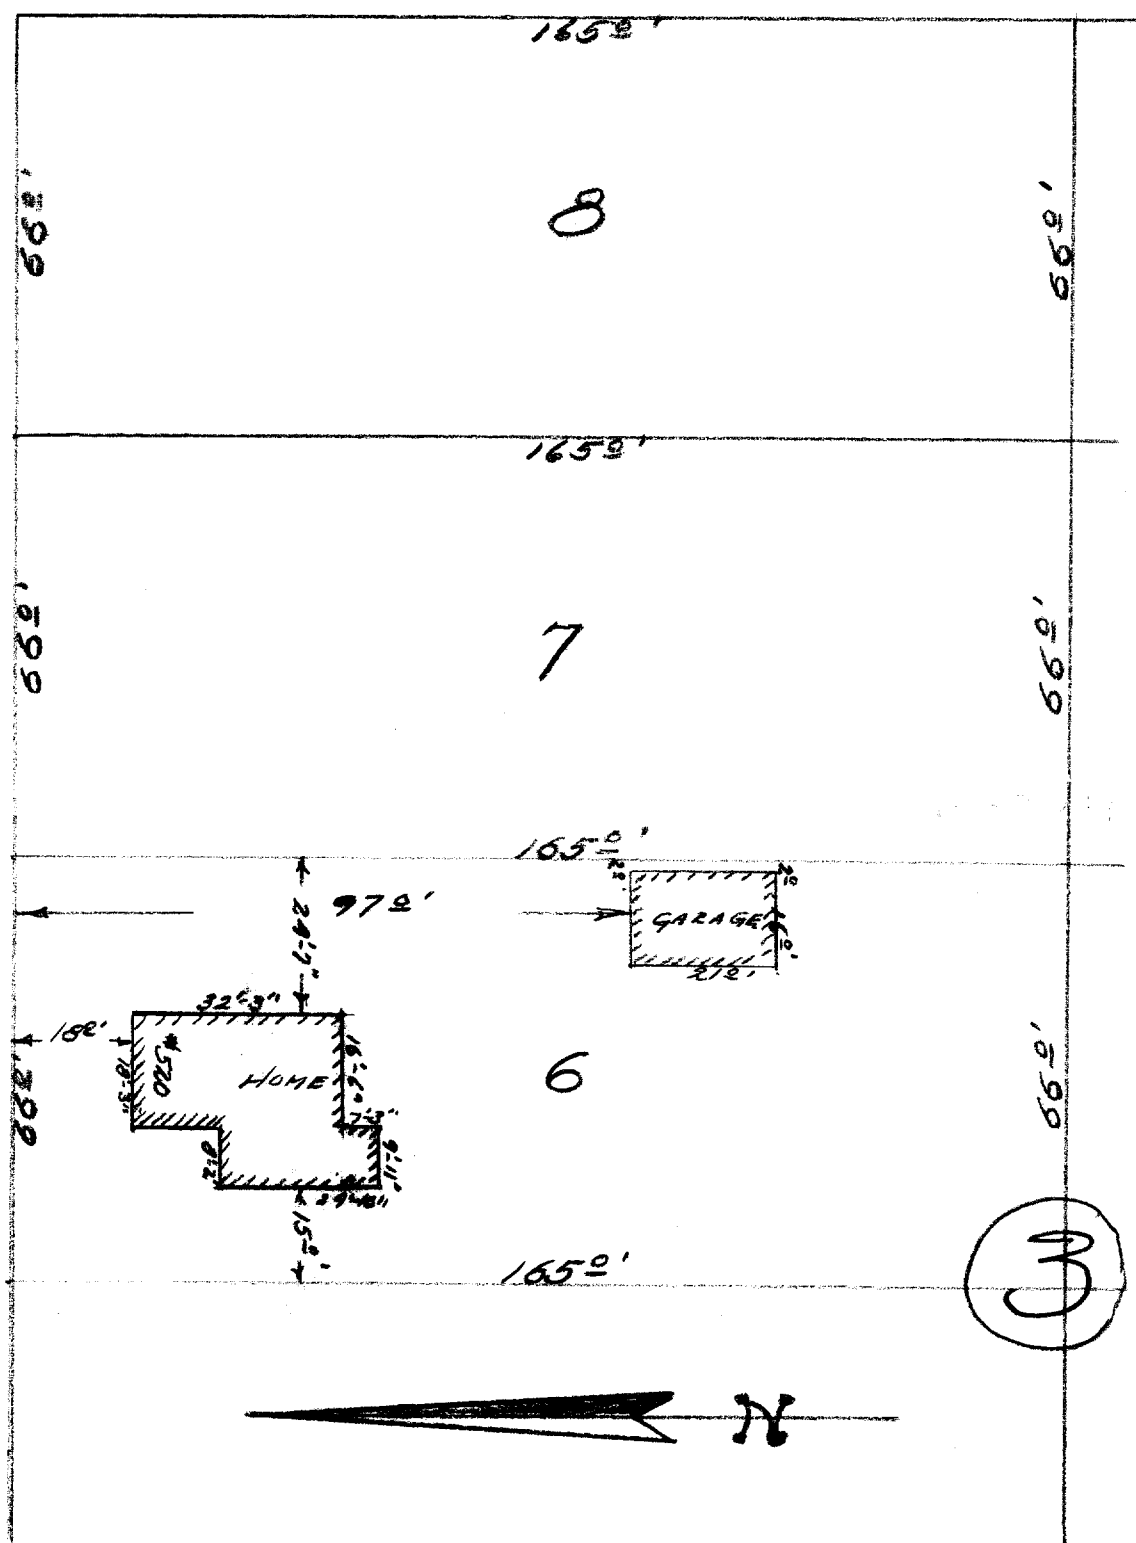

DESCRIPTION:

Lot 6 Block 3, Elmhurst Addition to the City of Delavan, Walworth County Wisconsin

CERTIFICATE:

I, hereby certify that I have on this the 5th day of February 1951, surveyed the above described property according to the official records on file in the office of the Recorder of Deeds in and for Walworth County, Wisconsin, and find that the measurements and bearings of the boundary lines of said property as taken at the site on this day, substantially agree with those in said official record and that no encroachments exist, and that the house and garage constructed upon this lot as of this date are wholly within the confines of said boundaries and that the house number 520 Barnes Street is the number allocated to said property by an ordinance of the City of Delavan.

SIGNED AND SEALED ON THIS THE 6TH DAY OF FEBRUARY 1951.

Joseph M. Biagi, Professional Engineer
Elkhorn Wisconsin.