


LEGEND

- - Iron Pipe Found
- () - Recorded As

MORTGAGE INSPECTION SURVEY

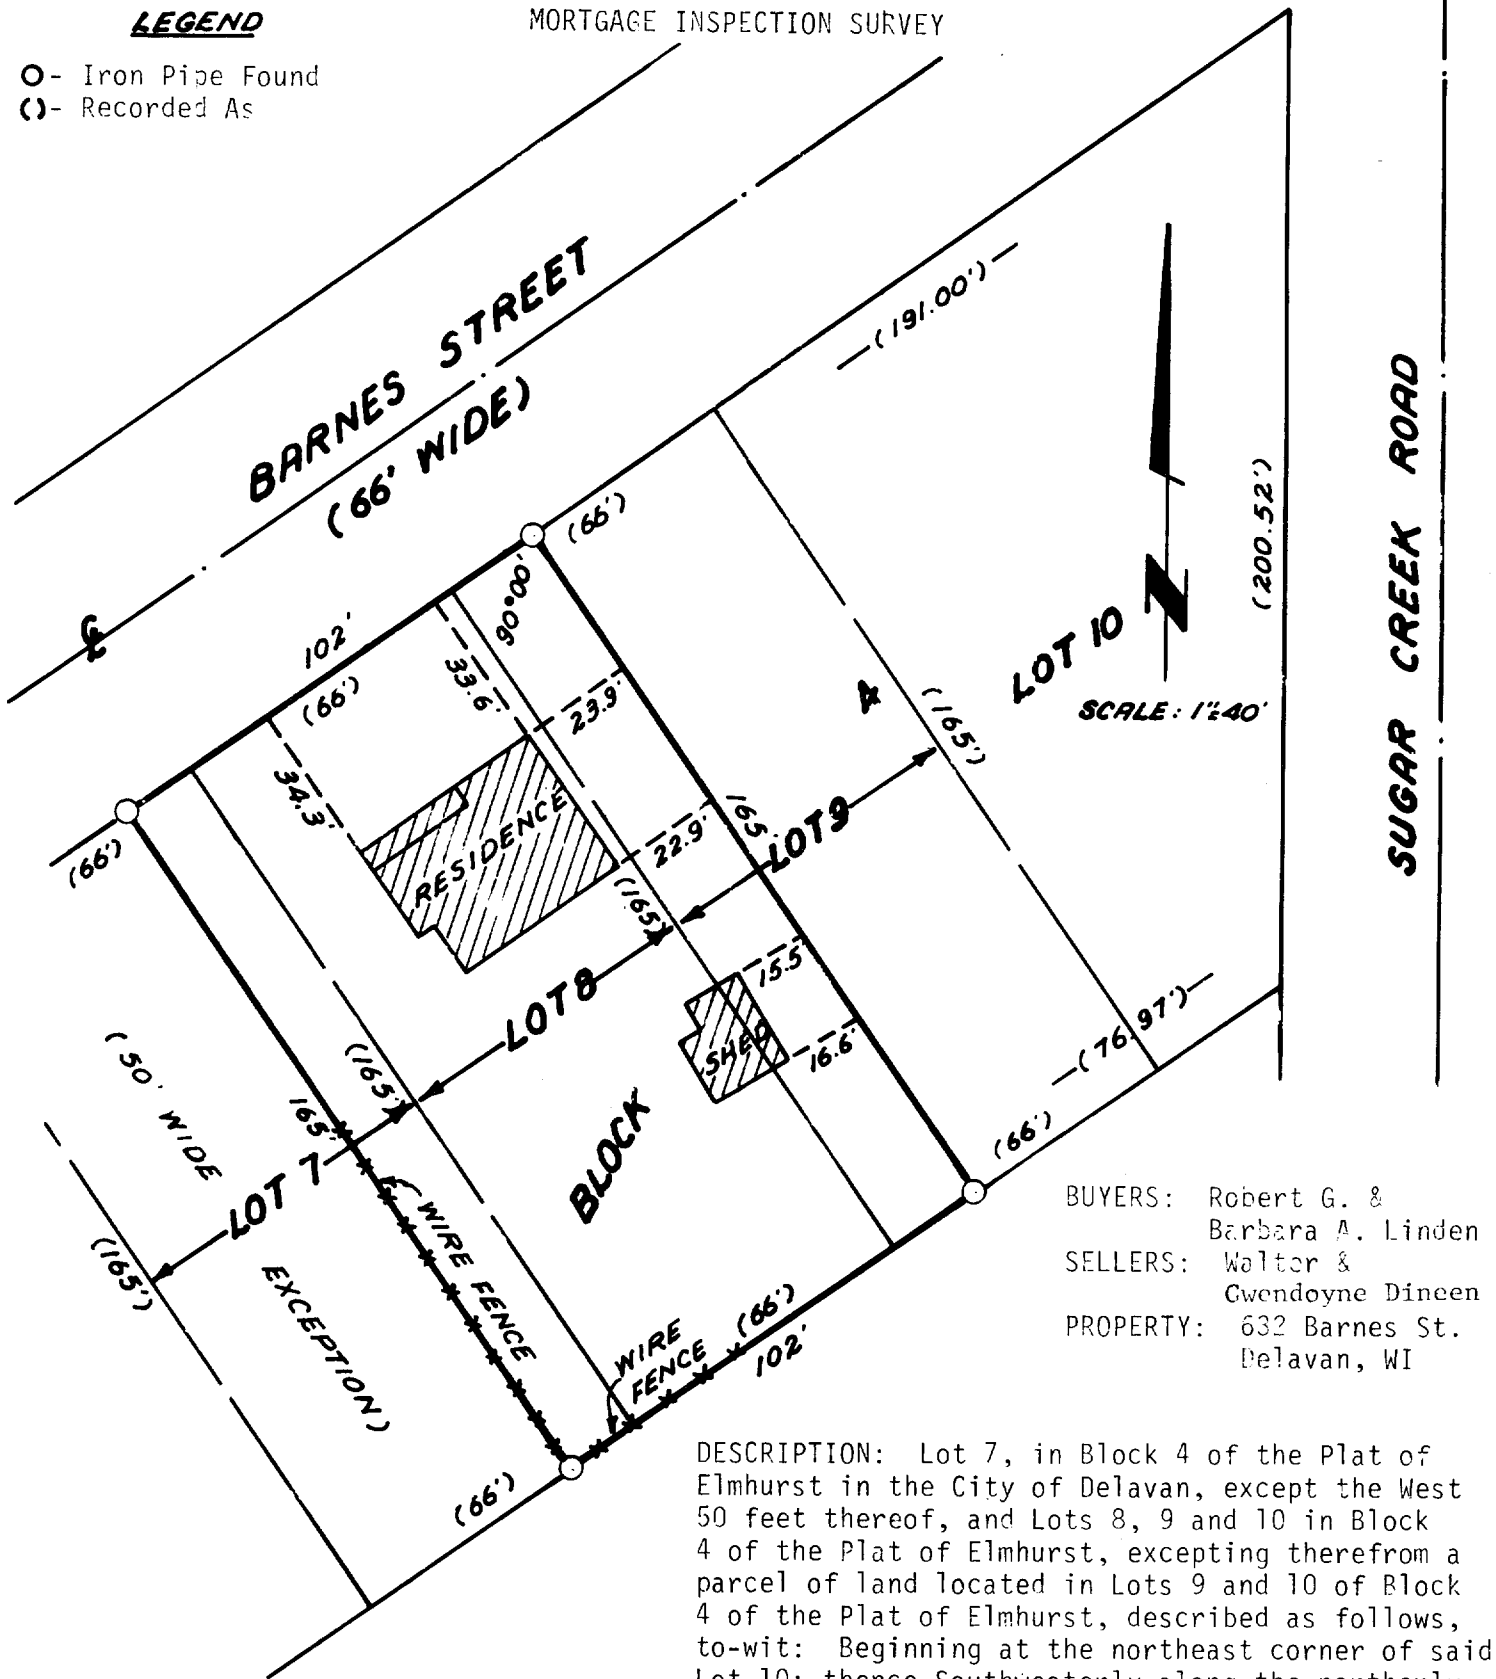

BUYERS: Robert G. &
Barbara A. Linden
SELLERS: Walter &
Gwendoyne Dineen
PROPERTY: 632 Barnes St.
Delavan, WI

DESCRIPTION: Lot 7, in Block 4 of the Plat of Elmhurst in the City of Delavan, except the West 50 feet thereof, and Lots 8, 9 and 10 in Block 4 of the Plat of Elmhurst, excepting therefrom a parcel of land located in Lots 9 and 10 of Block 4 of the Plat of Elmhurst, described as follows, to-wit: Beginning at the northeast corner of said Lot 10; thence Southwesterly along the northerly line of said Lots 9 and 10, 191.00 feet; thence southeasterly at right angles to the northerly line of said Lots 9 and 10, 165.00 feet; thence Northeasterly along the southeasterly line of said Lots 9 and 10, 76.97 feet to the southeasterly corner of said Lot 10; thence North along the east line of said Lot 10, 200.52 feet to the place of beginning.

ORDERED WORK: WAUKESHA SAVINGS & LOAN ASSOC.

NOTE: THIS IS NOT A "PROPERTY SURVEY" AS DEFINED IN SEC. AE 5.01 OF THE WISCONSIN ADMINISTRATIVE CODE.

I HEREBY CERTIFY that this map is a true representation of the Lot Lines and the buildings located hereon to the best of my knowledge and belief.

Dated This 18th Day of August, 1978.

Robert A. Farris

Robert A. Farris, RLS

Drawing No. 1383