


DUNHAM SURVEYING, S.C.
SURVEYING & SUBDIVIDING
DELAVAN, WISCONSIN 53115

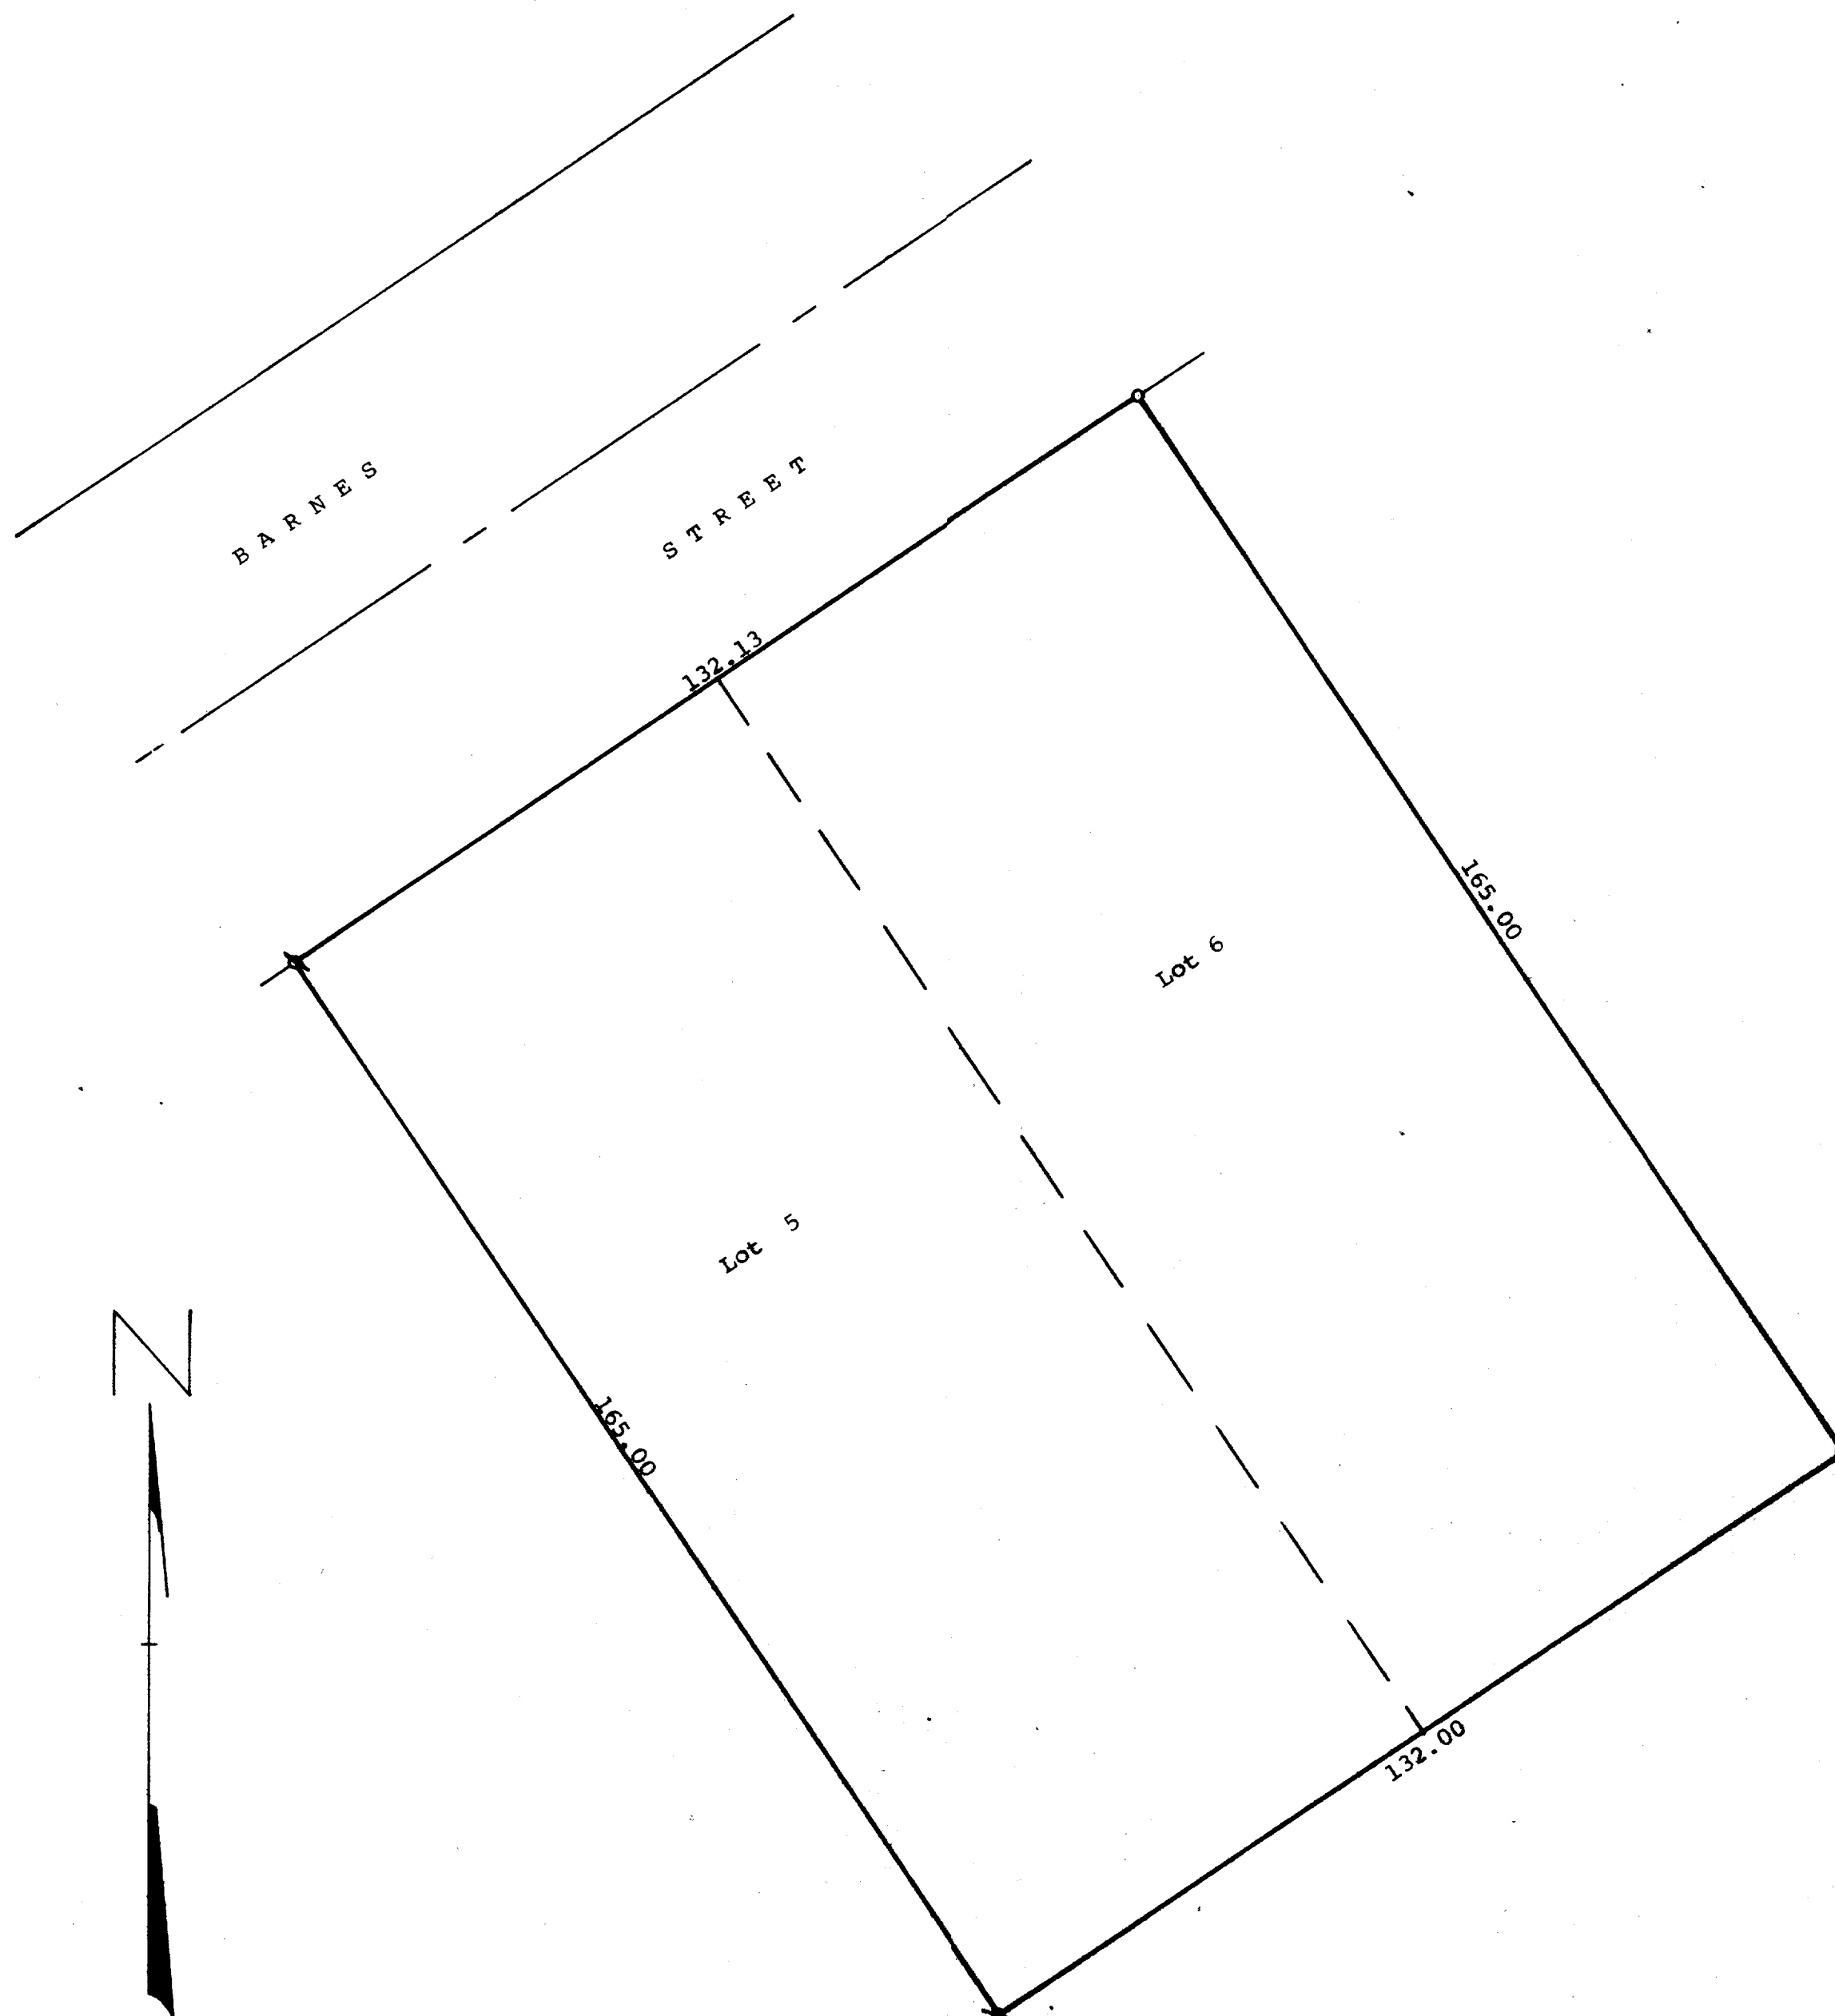

Scale - 1" = 20'
■ = Iron Pipe Found
○ = Iron Pipe Set

Plat of survey of:
Lots 5 and 6, Block 4 of Elmhurst Addition to the
Village (now City) of Delavan, Walworth County,
Wisconsin.
April 27, 1978

James M. Dunham
James M. Dunham, Surveyor

