
DUNHAM SURVEYING, S.C. SURVEYING & SUBDIVIDING DELAYAN, WISCONSIN 53115

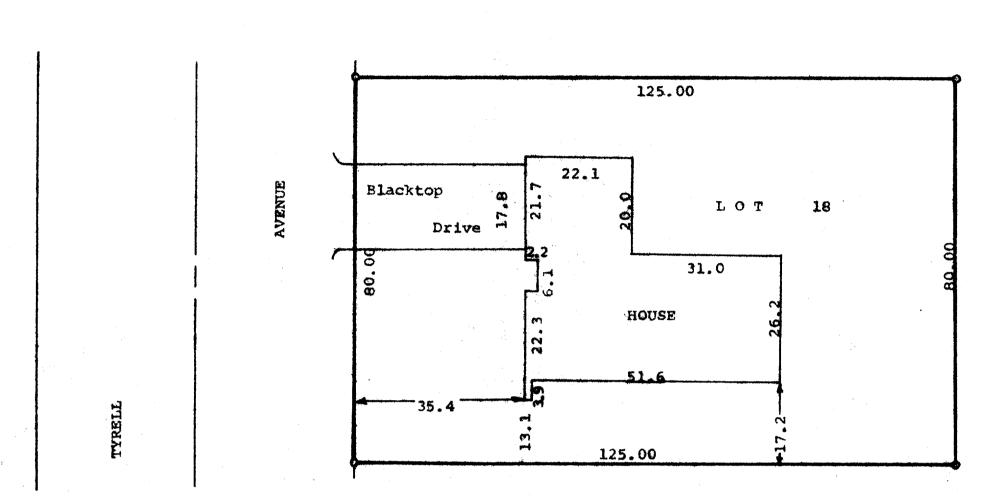

Scale -1" = 20"0 = Iron Pipe Found

STATE OF WISCONSIN) SS COUNTY OF WALMORTH) SS

I, George T. Dunham, Surveyor, certify that I have surveyed the property described as follows,

Lot 18, Block 3 of Allynhurst Subdivision, located in the City of Delavan, Walworth County, Wisconsin,

and that the above map is a true representation thereof and shows the size and location of the property, its exterior boundaries, the location of all visible structures and dimensions of all principal buildings thereon, boundary fences, apparent easements, roadways and visible encroachments, if any.

This survey is made for the use of the present owners of the property, and also those who purchase, mortgage, or guarantee the title thereto within one (1) year from date hereof. July 16, 1979.

George To Dunham, Surveyor

