


DUNHAM SURVEYING, S. C.
SURVEYING & SUBDIVIDING
DELAVER, WISCONSIN 53115

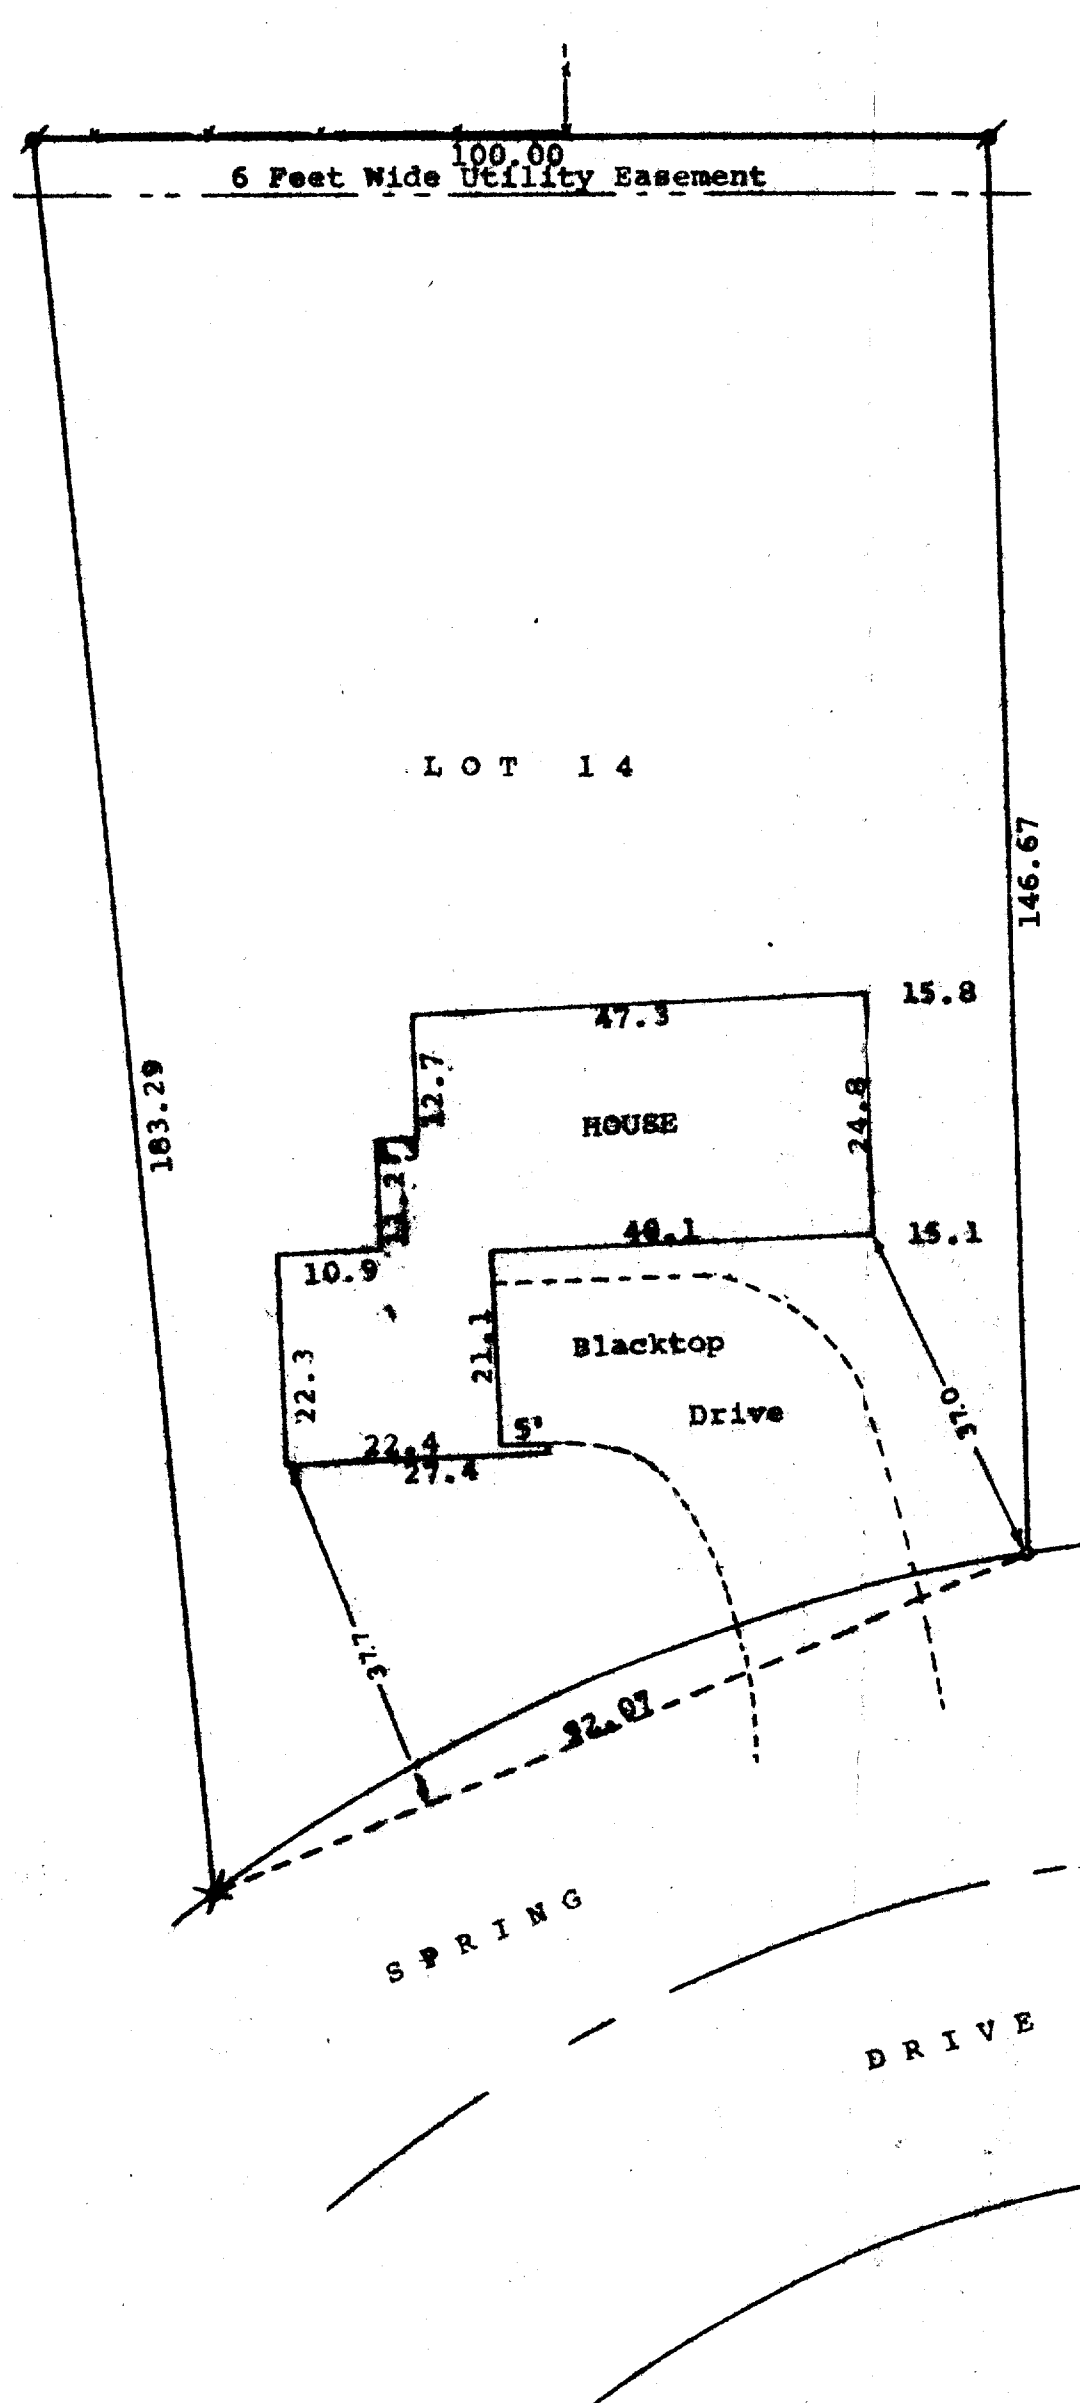

N

Scale - 1" = 20'
 * = Iron Pipe Found
 o = Iron Pipe Set
 * = Iron Pipe Found
 Bent and Reset
 --- = Fence Line

STATE OF WISCONSIN)
COUNTY OF WALWORTH) SS
 I, George T. Dunham, Surveyor, certify that I have surveyed the property described as follows,
 Lot 14, Block 6 of Springs Park Subdivision Addition No. 2, located in the City of Delavan, Walworth County, Wisconsin, and that the above map is a true representation thereof and shows the size and location of the property, its exterior boundaries, the location of all visible structures and dimensions of all principal buildings thereon, boundary fences, apparent easements, roadways and visible encroachments, if any.
 This survey is made for the use of the present owners of the property, and also those who purchase, mortgage, or guarantee the title thereto within one (1) year from date hereof.
 October 2, 1980

George T. Dunham
George T. Dunham, Surveyor

