


DUNHAM SURVEYING, S.C.
SURVEYING & SUBDIVIDING
DELAVAN, WISCONSIN 53115

PHOENIX

STREET

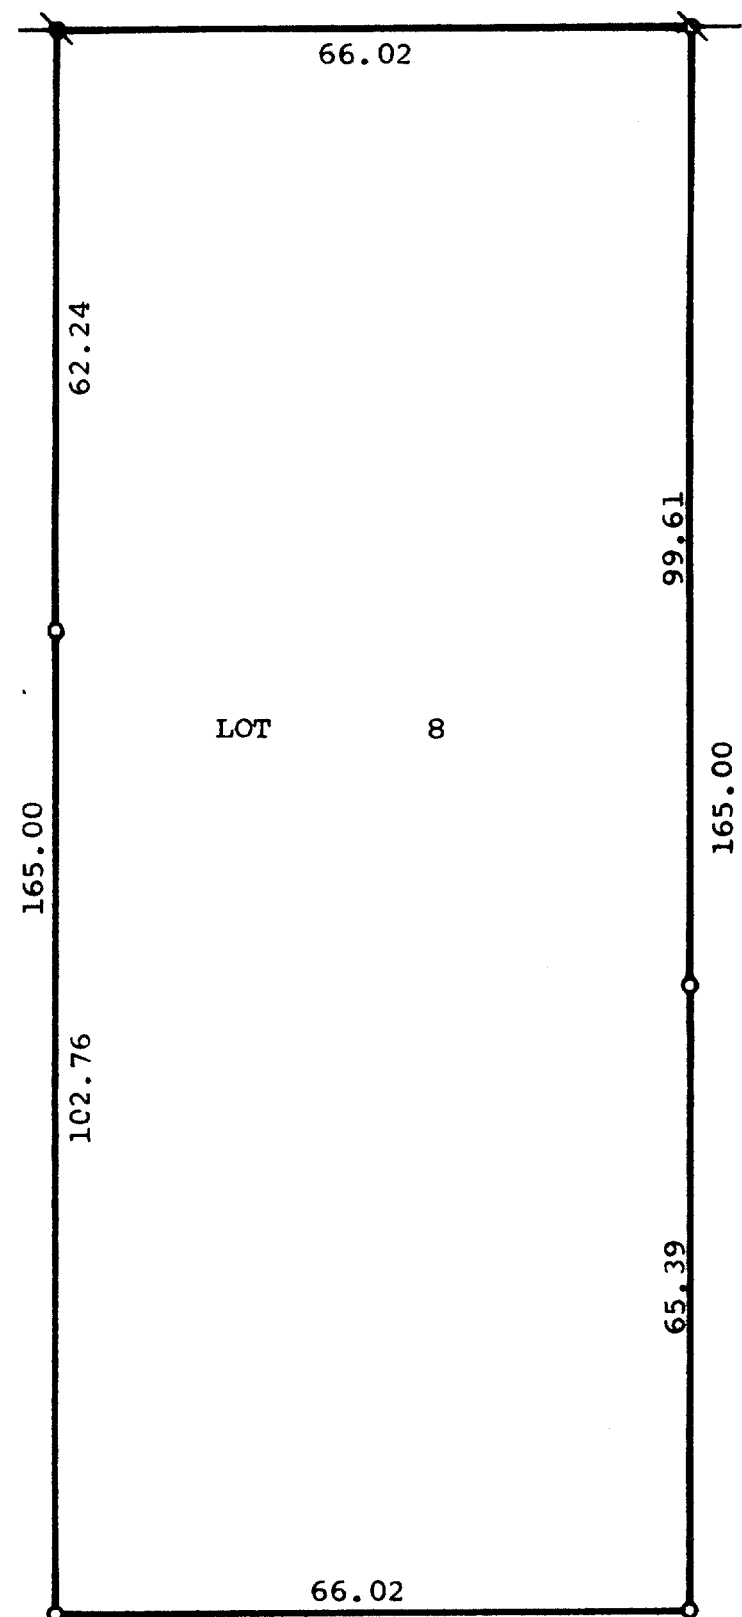

Scale - 1" = 20'

■ = Iron Pipe Found 10"
Down and Reset Iron Pipe

■ = Iron Bar Found 1'
Down and Reset Iron Pipe

○ = Iron Pipe Set

Plat of a survey of:
Lot 8, Block 3 of Sarah A. Phoenix Addition to
the City of Delavan, Walworth County, Wisconsin.
August 17, 1981.

George T. Dunham
George T. Dunham, Surveyor

