


DUNHAM SURVEYING, S.C.
SURVEYING & SUBDIVIDING
DELAVER, WISCONSIN 53115

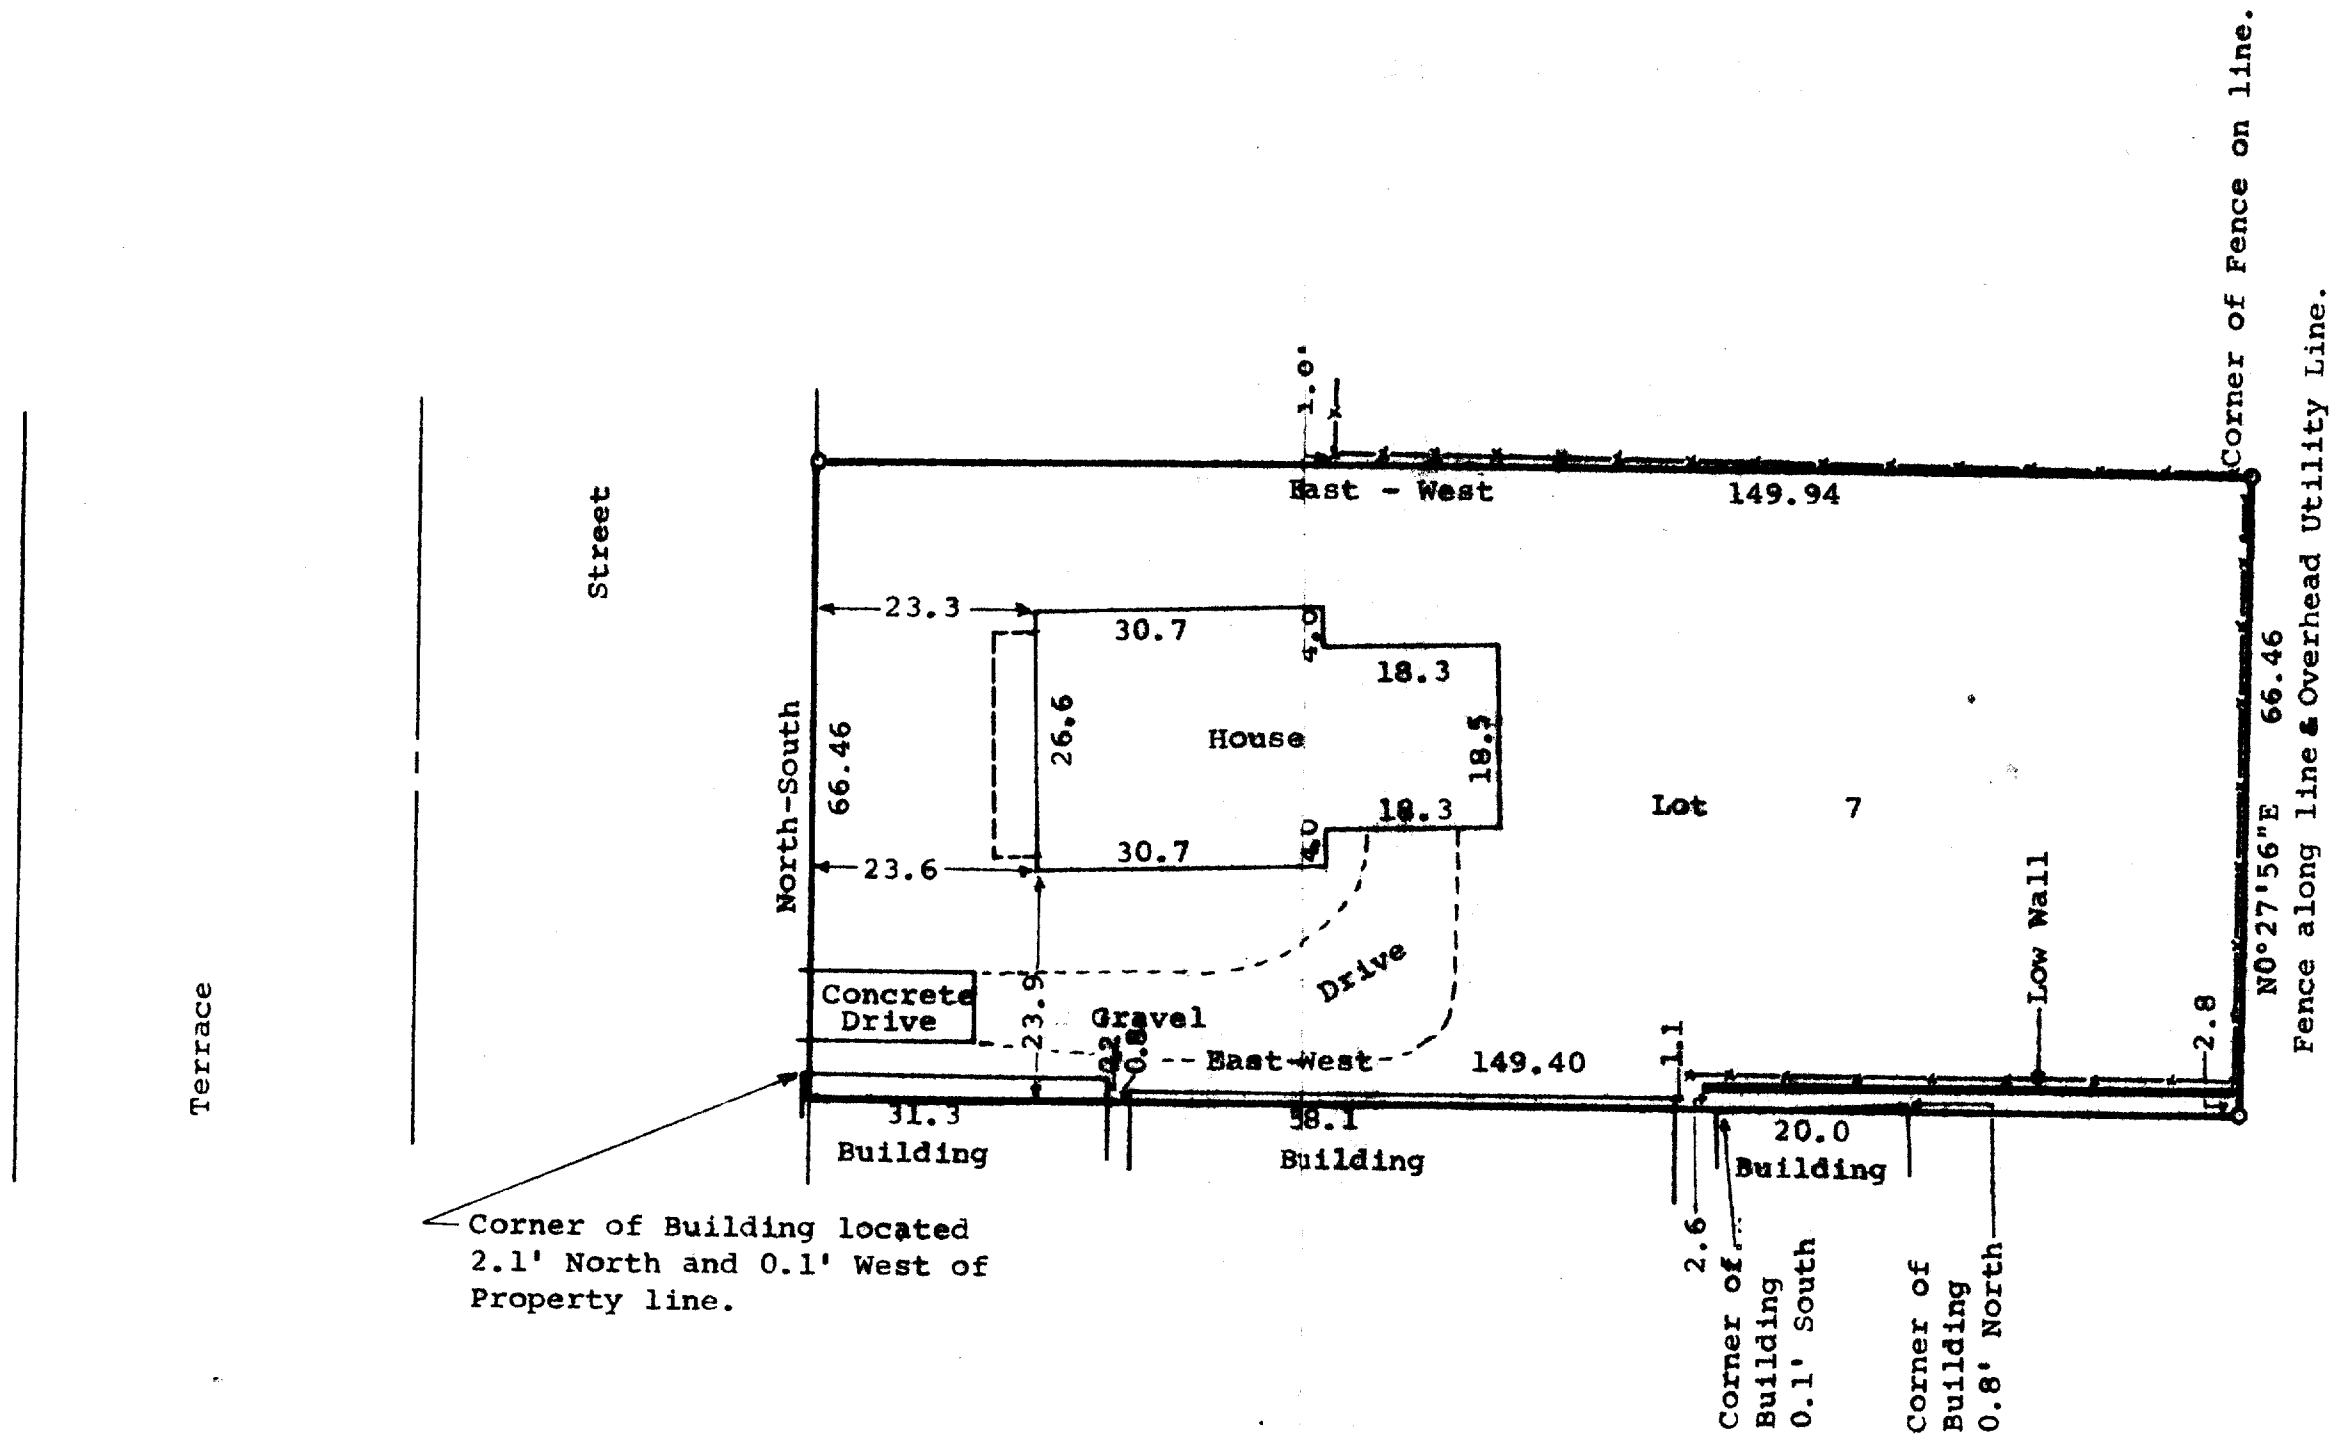


STATE OF WISCONSIN)
COUNTY OF WALWORTH)

I, George T. Dunham, Surveyor, certify that I have surveyed the property described as follows,

Lot 7, Block 7 of the Original Plat of the Village (now City) of Delavan, Walworth County, Wisconsin, and that the above map is a true representation thereof and shows the size and location of the property, its exterior boundaries, the location of all visible structures and dimensions of all principal buildings thereon, boundary fences, apparent easements, roadways and visible encroachments, if any.

This survey is made for the use of the present owners of the property, and also those who purchase, mortgage, or guarantee the title thereto within one (1) year from date hereof.
December 15, 1981.

George T. Dunham
George T. Dunham, Surveyor

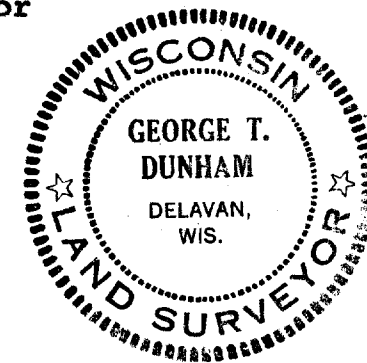

Scale - 1" = 20'
o = Iron Pipe Found
--- = Fence line.

Bearings referenced to the East line of Terrace Street assumed North-South.

Survey Ordered By: The Rauland Agency
Delavan, Wisconsin 53115