


PLAT OF SURVEY


LOTS 2,3,4 & 5 OF BLOCK 2 EXCEPT THE NORTH 61.80' OF LOT 5
AND EXCEPT THE NORTH 44.50' OF LOT 2 OF THE ORIGINAL
PLAT OF THE VILLAGE (NOW CITY) OF DELAVAN WISCONSIN
LOCATED IN THE NORTHEAST 1/4 OF SECTION 18, CITY OF DELAVAN
T.2N., R.16E., WALWORTH COUNTY, WISCONSIN

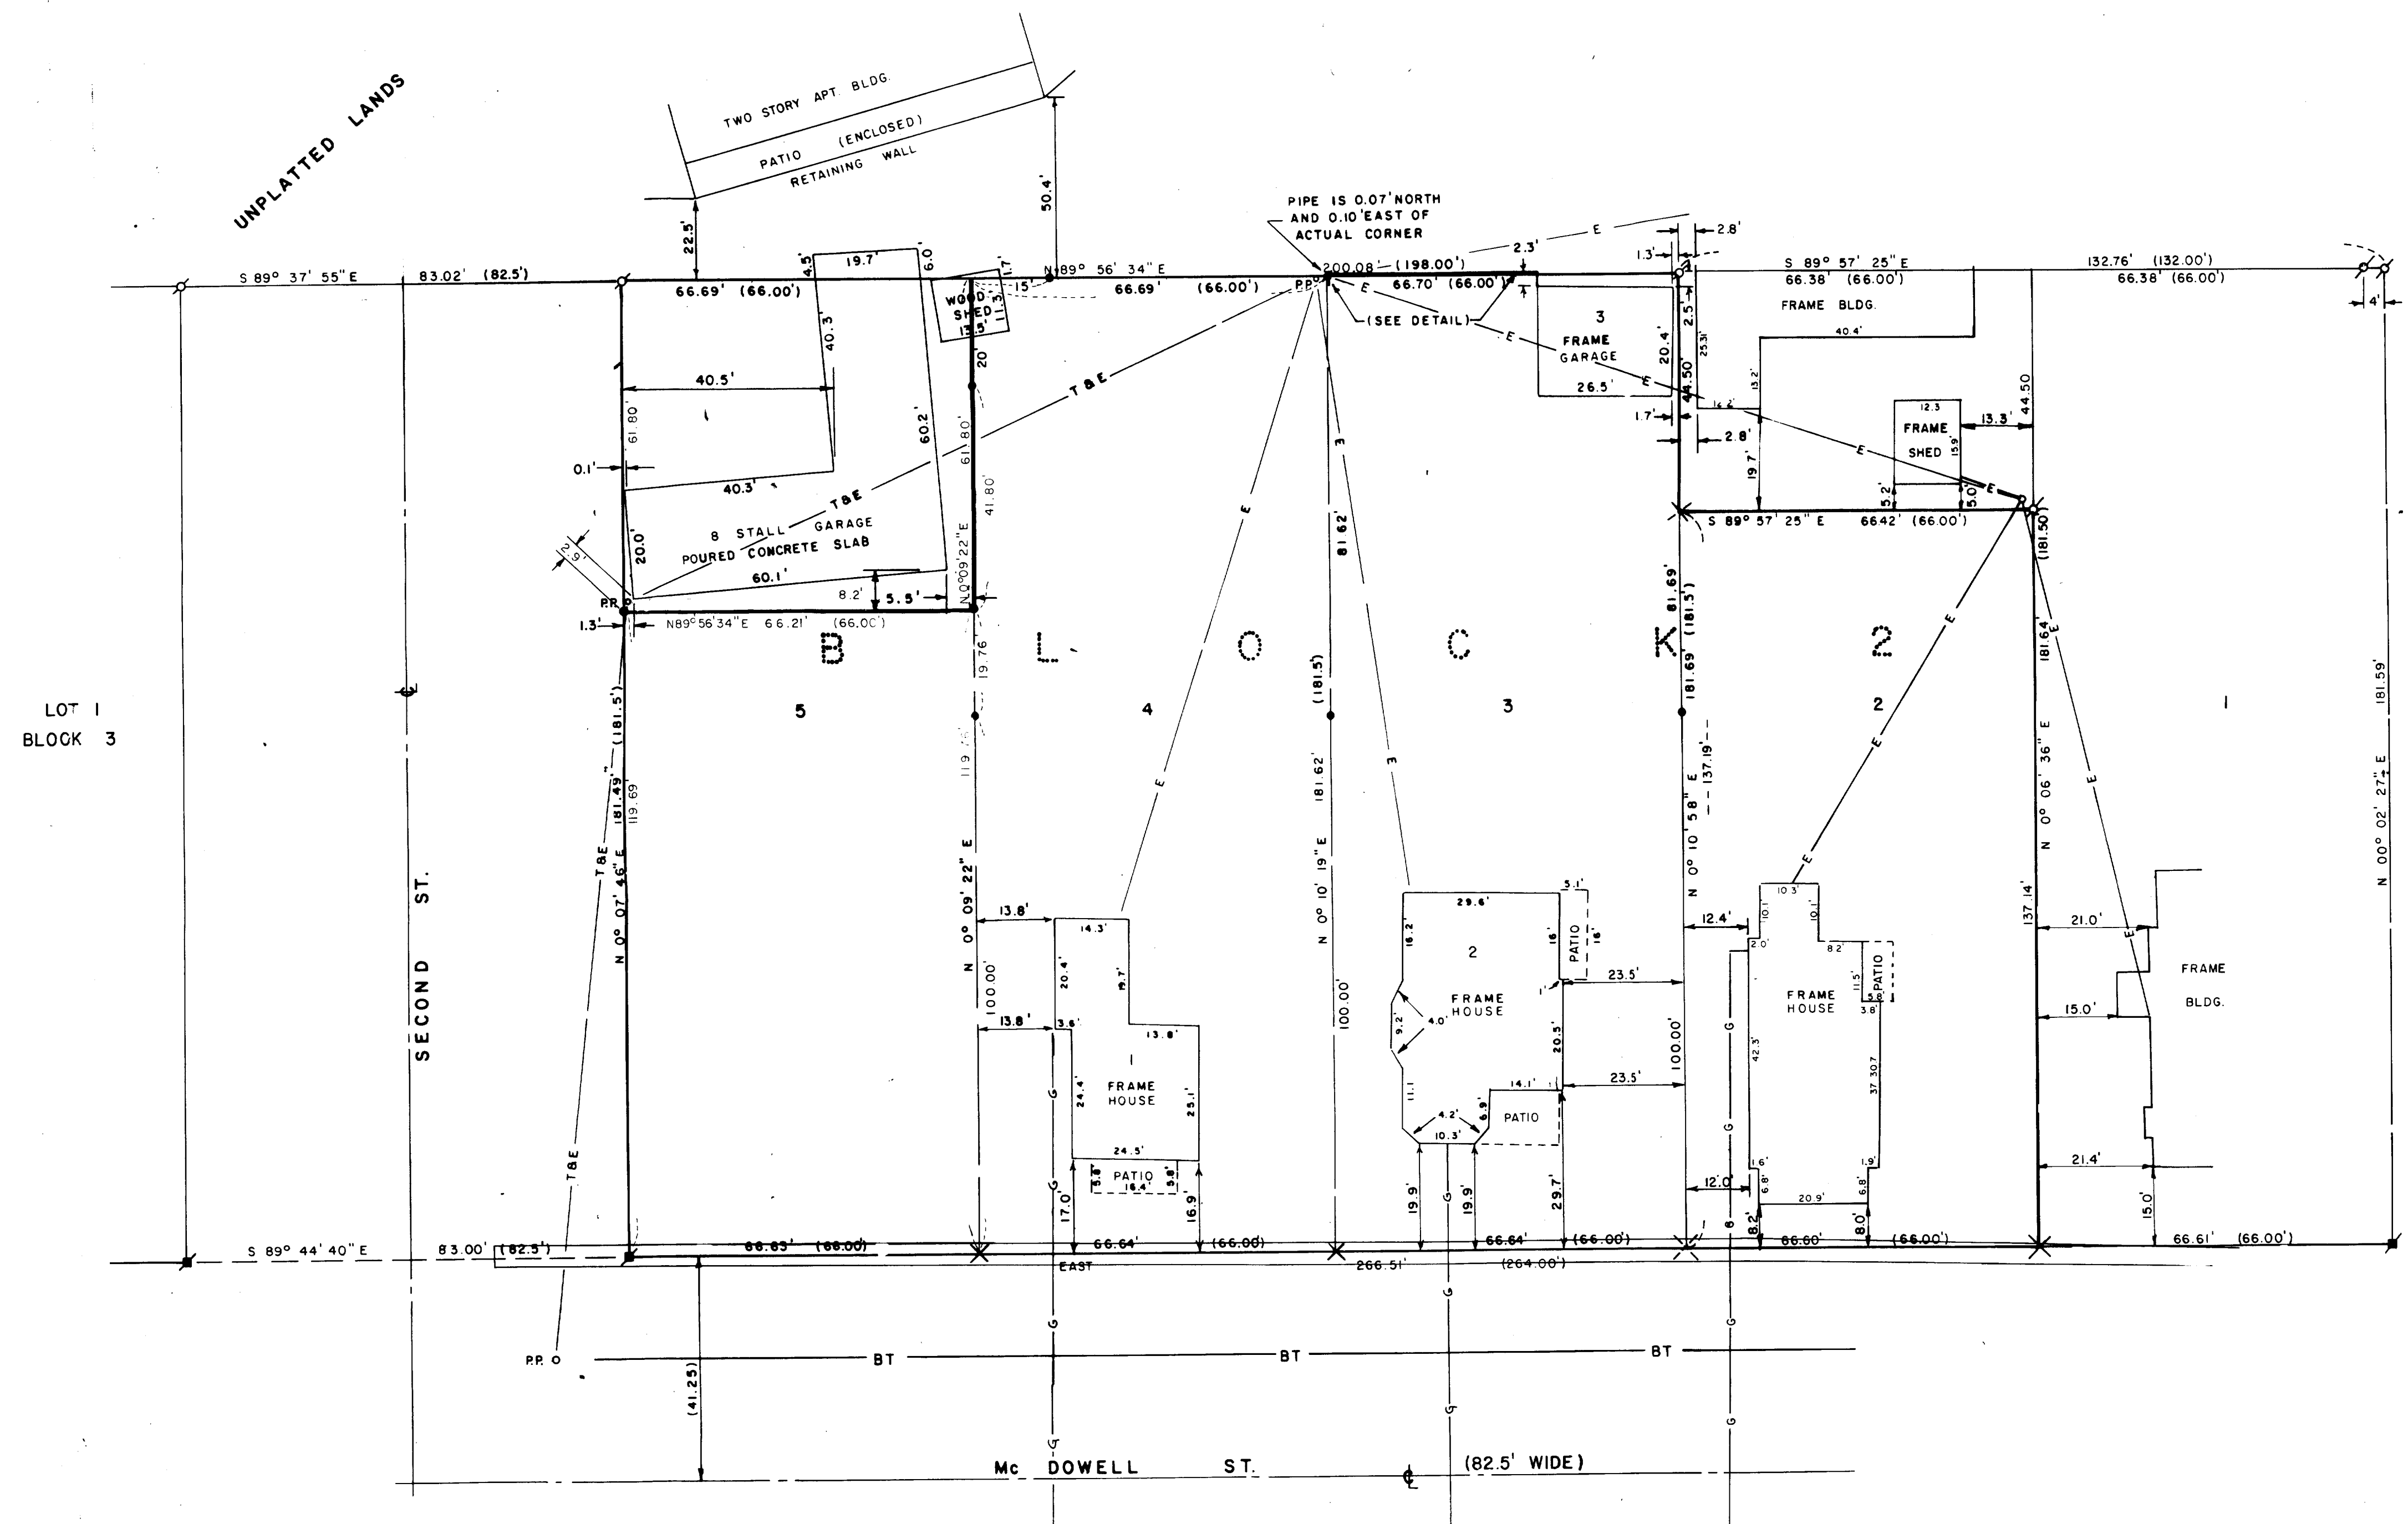

BEARINGS ARE REFERENCED TO
THE SOUTH LINE OF BLOCK 2,
ASSUMED EAST.

SCALE 1" = 20'

DETAIL
(NOT TO SCALE)

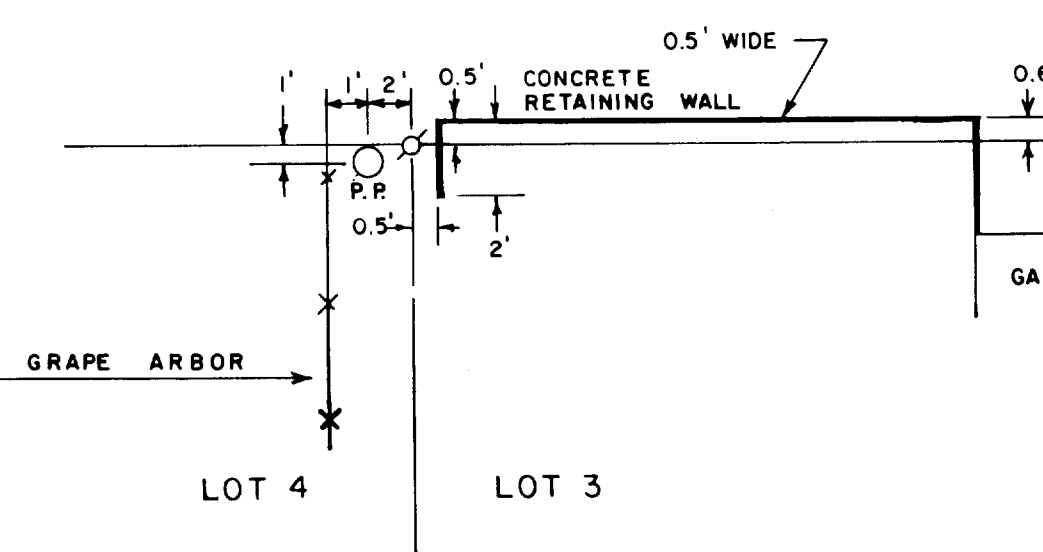

LEGEND

- FOUND PIPE
- ⊕ FOUND AXLE IN CONC.
- ⊗ FOUND CUT CROSS
- ⊙ SET CUT CROSS
- SET 1 1/2" X 36" IRON PIPE
- () RECORDED BEARINGS OR DISTANCES
- E- OVERHEAD ELECTRIC
- T- OVERHEAD TELEPHONE
- G- BURIED GAS MAIN
- BT- POSSIBLE BURIED TELEPHONE

NOTE: HOUSES ON LOTS 3 & 4 ARE SERVICED BY
BURIED TELEPHONE FROM THE SOUTH


SURVEYORS CERTIFICATE

"I HEREBY CERTIFY THAT I HAVE SURVEYED THE ABOVE DESCRIBED PROPERTY AND THAT THE ABOVE MAP IS A TRUE REPRESENTATION THEREOF AND SHOWS THE SIZE AND LOCATION OF THE PROPERTY, ITS EXTERIOR BOUNDARIES, THE LOCATION OF ALL VISIBLE STRUCTURES AND DIMENSIONS OF ALL PRINCIPAL BUILDINGS THEREON, BOUNDARY FENCES, APPARENT EASEMENTS, ROADWAYS AND VISIBLE ENCROACHMENTS, IF ANY.
"THIS SURVEY IS MADE FOR THE USE OF THE PRESENT OWNERS OF THE PROPERTY, AND ALSO THOSE WHO PURCHASE, MORTGAGE, OR GUARANTEE THE TITLE THERETO WITHIN ONE YEAR FROM DATE HEREOF."

MAY 18, 1981

Robert Scott Johnson

donohue & associates inc.
CONSULTING ENGINEERS

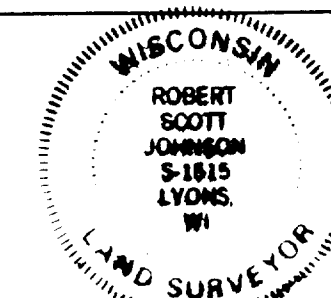

DATE NOVEMBER 17, 1980
REVISED MAY 18, 1981

DRAWN BY D. GEYE

CHECKED BY D. ZENZ

SCALE 0' 5' 10' 20' 40'
1" = 20'

SURVEY FOR
MUNZ INVESTMENT REAL ESTATE, INC.

PROJECT NO.
11164.000

FILE NO.
ES 777