

KOLB LAND CONSULTING, INC.
LAND SURVEYING • SUBDIVIDING • LAND PLANNING

LAKE GENEVA, WISCONSIN 53147

POINT DESCRIBED AS BEING N 56°06'E 6 CHAINS 38 LINKS
FROM INTERSECTION OF NORTH-SOUTH 1/8 LINE OF THE
NORTHWEST 1/4 OF SEC. 17-2-16, CITY OF DELAVAN

RACINE STREET

PLAT OF SURVEY OF

A PARCEL OF LAND LOCATED IN THE
NORTHWEST 1/4 OF SECTION 17, T2N,
R16E, CITY OF DELAVAN, WALWORTH
COUNTY, WISCONSIN.


ORDERED BY: SECURITY SAVINGS
P.O. BOX 15401
MILWAUKEE, WI 53215

OWNER: JAMES & SHERRY SCHEURELL
926 RACINE ST.
DELAVAN, WI 53115

LEGEND

- ⊙ - IRON PIPE FOUND
- - IRON PIPE SET
- ⊙ - IRON ROD FOUND
- ⊙ - IRON BOLT FOUND
- - OVERHEAD UTILITY LINES
- Δ - UTILITY POLE
- () - RECORDED AS
- × - SPIKE FOUND

BLACKTOP DRIVE ENCROACHES

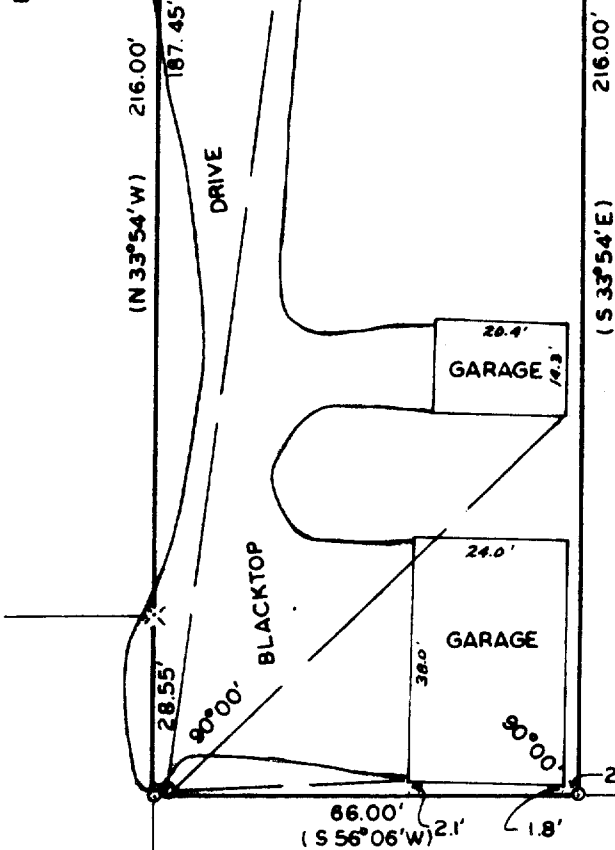

I HEREBY CERTIFY THAT I HAVE SURVEYED
THE ABOVE DESCRIBED PROPERTY AND THAT
THE ABOVE MAP IS A TRUE REPRESENTATION
THEREOF AND SHOWS THE SIZE AND LOCATION
OF THE PROPERTY, ITS EXTERIOR BOUNDARIES, THE
LOCATION OF ALL VISIBLE STRUCTURES AND
DIMENSIONS OF ALL PRINCIPAL BUILDINGS THEREON,
BOUNDARY FENCES, APPARENT EASEMENTS, ROADWAYS
AND VISIBLE ENCROACHMENTS, IF ANY.

THIS SURVEY IS MADE FOR THE USE OF THE PRESENT
OWNERS OF THE PROPERTY, AND ALSO THOSE WHO
PURCHASE, MORTGAGE, OR GUARANTEE THE TITLE
THERE TO WITHIN ONE (1) YEAR FROM DATE HEREOF.

SCALE - 1" = 60'

Harold H. Kolb

HAROLD H. KOLB
WISCONSIN REGISTERED LAND SURVEYOR, S-187
DATE NOVEMBER 9, 1983

XWUP-28

2-665-K