

KOLB LAND CONSULTING, INC.
LAND SURVEYING • SUBDIVIDING • LAND PLANNING

LAKE GENEVA, WISCONSIN 53147

PHOENIX


SEVENTH STREET

TAX NUMBER: 2-51-13

LOT 2

NOTE: COMPLIANCE WITH A-E 3, 5(F), 6(A), (B), (C), (D) AND 7 HAS BEEN WAITED BY THE CLIENT IN AGREEMENT WITH THE SURVEYOR AS PERMITTED IN A-E5.01(B).

NOTE: BEARINGS ARE AS SHOWN ON EXISTING SURVEYS.

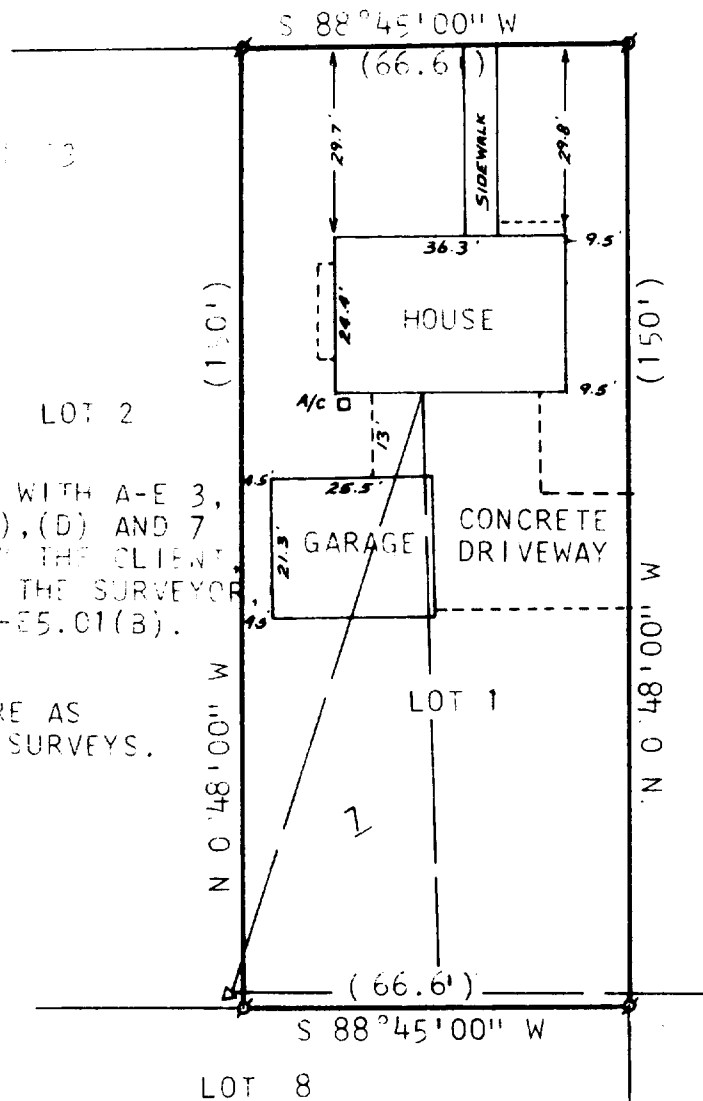

SEVENTH STREET

SEVENTH STREET

BLOCK 7

MORTGAGE INSPECTION OF

LOT 1, BLOCK 7, FAIRVIEW HEIGHTS, A SUBDIVISION
LOCATED IN THE CITY OF DELAVAN, WALWORTH COUNTY,
WISCONSIN.



SCALE - 1"=30'

LEGEND

- - IRON PIPE FOUND
- ▲ - UTILITY POLE
- - OVERHEAD UTILITY LINES
- () - RECORDED AS

ORDERED BY: ANCHOR SAVINGS & LOAN ASSOCIATION
500 E. WALWORTH AVE.
DELAVAN, WI 53115

OWNER: JAMES DADY, JR.
670 PHOENIX
DELAVAN, WI 53115

Harold H. Kolb

HAROLD H. KOLB
WISCONSIN REGISTERED LAND SURVEYOR, S-187
DATE FEBRUARY 28, 1984

XFH-53

2-670-K

D-FH-53