


COOPER SURVEYING SERVICES

Rural - Residential - Commercial

Route 3, Box 255 :: Elkhorn, Wisconsin 53121

Phone (414) 723-6265


PLAT OF SURVEY OF LOT 19 BLOCK 4 OF
PASSAGE ARAM & DOWNIE ADD TO THE
CITY OF DELAVAN WALWORTH COUNTY WIS

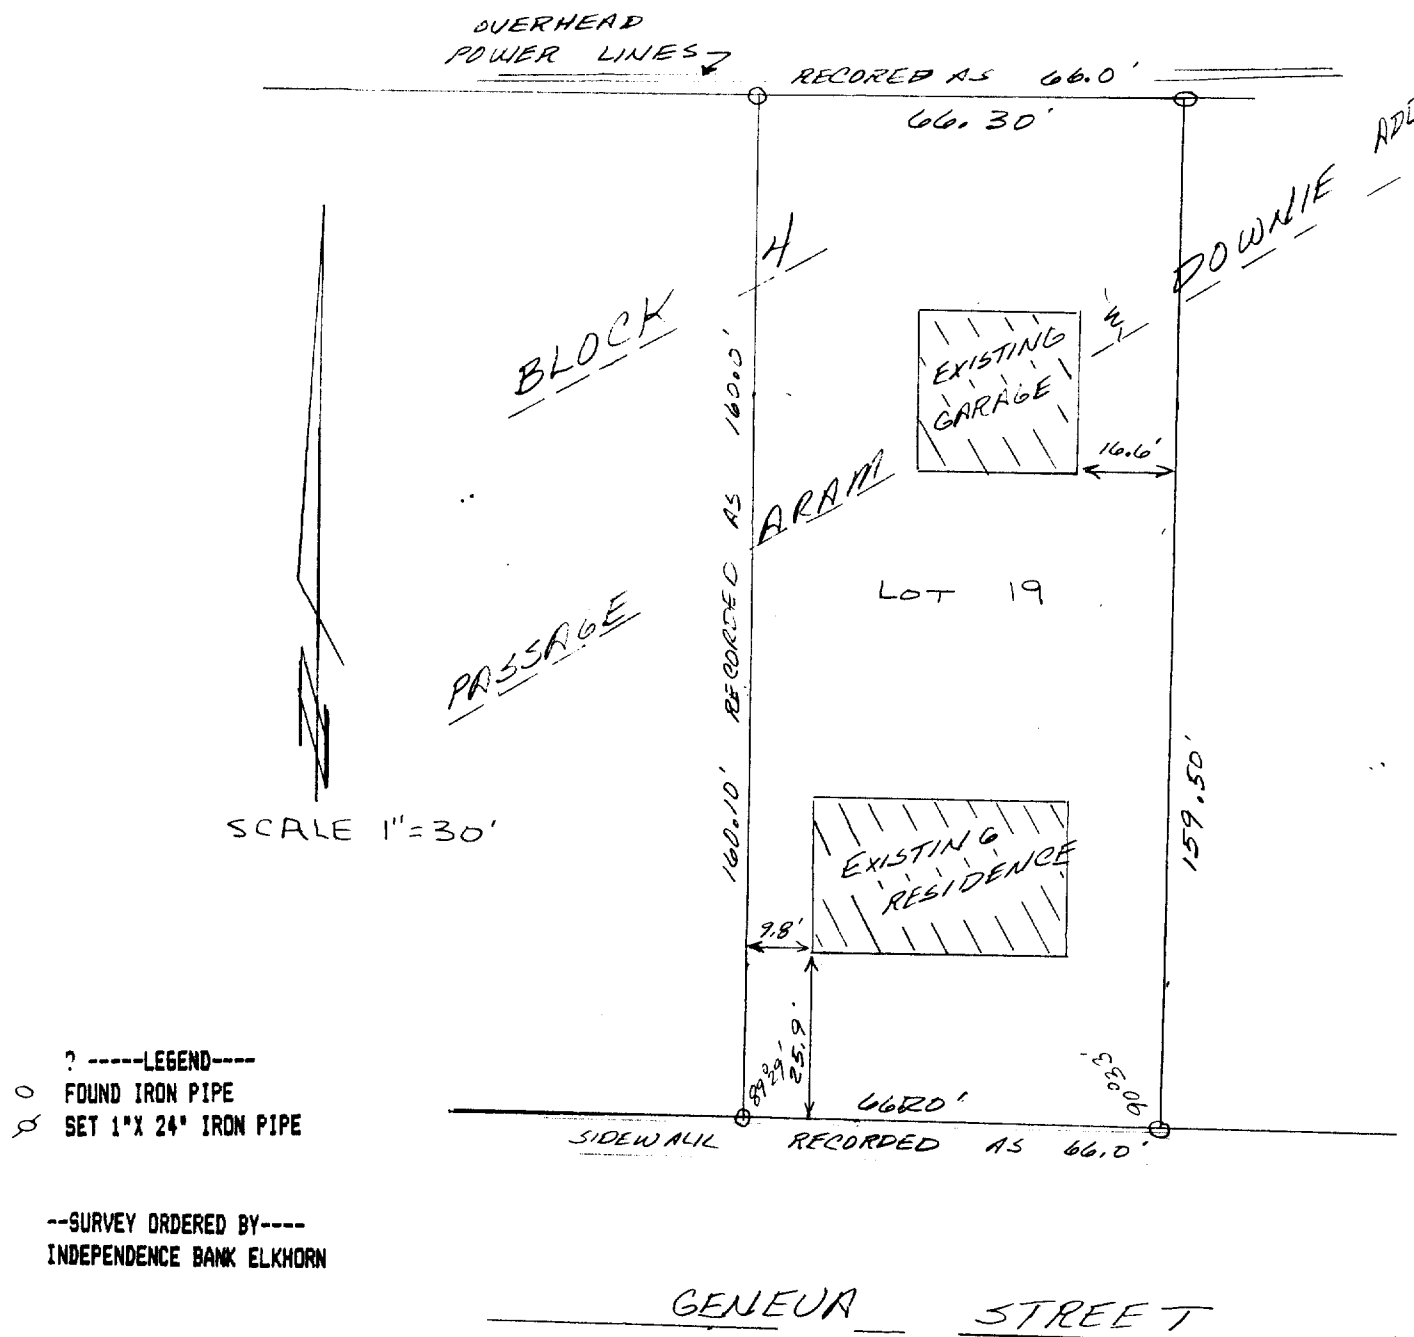

I, DANIEL D. COOPER, REGISTERED SURVEYOR, DO HEREBY CERTIFY THAT
I HAVE SURVEYED THE PROPERTY DESCRIBED HEREON AND THAT THE MAP
SHOWN HEREON IS A TRUE AND ACCURATE REPRESENTATION THEREOF TO THE
BEST OF MY PROFESSIONAL KNOWLEDGE AND BELIEF.

DATED THIS 15 DAY OF MAR, 1984

DANIEL D. COOPER, RLS NO. 8-1464

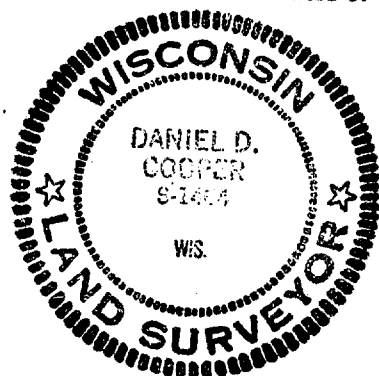

SURVEYING & PLANNING
SUBDIVISIONS • LOT SURVEYS
CONSTRUCTION STAKING • MAPPING

XP 65

2-674-C
DRAWING NO. 1899