

COOPER SURVEYING SERVICES

Rural - Residential - Commercial


DANIEL D. COOPER
Registered Land Surveyor

Route 3, Box 255 :: Elkhorn, Wisconsin 53121

Phone (414) 723-6265

SURVEYING & PLANNING
SUBDIVISIONS - LOT SURVEYS
CONSTRUCTION STAKING - MAPPING

PLAT OF SURVEY OF LOT 48 OF TURTLE
CREEK SUBDIVISION BEING LOCATED IN
THE CITY OF DELAVAN
WALWORTH COUNTY WISCONSIN

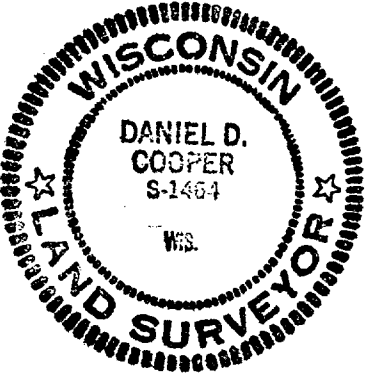


I, DANIEL D. COOPER, REGISTERED SURVEYOR, DO HEREBY CERTIFY THAT
I HAVE SURVEYED THE PROPERTY DESCRIBED HEREON AND THAT THE MAP
SHOWN HEREON IS A TRUE AND ACCURATE REPRESENTATION THEROF TO THE
BEST OF MY PROFESSIONAL KNOWLEDGE AND BELIEF.

DATED THIS 8 DAY OF MAR. 1984 *Daniel D Cooper*
DANIEL D. COOPER, RLS NO. 9-1464

-----LEGEND-----
○ FOUND IRON PIPE

WORK DONE FOR - INDEPENDENCE BANK ELKHORN

SCALE 1" = 30'

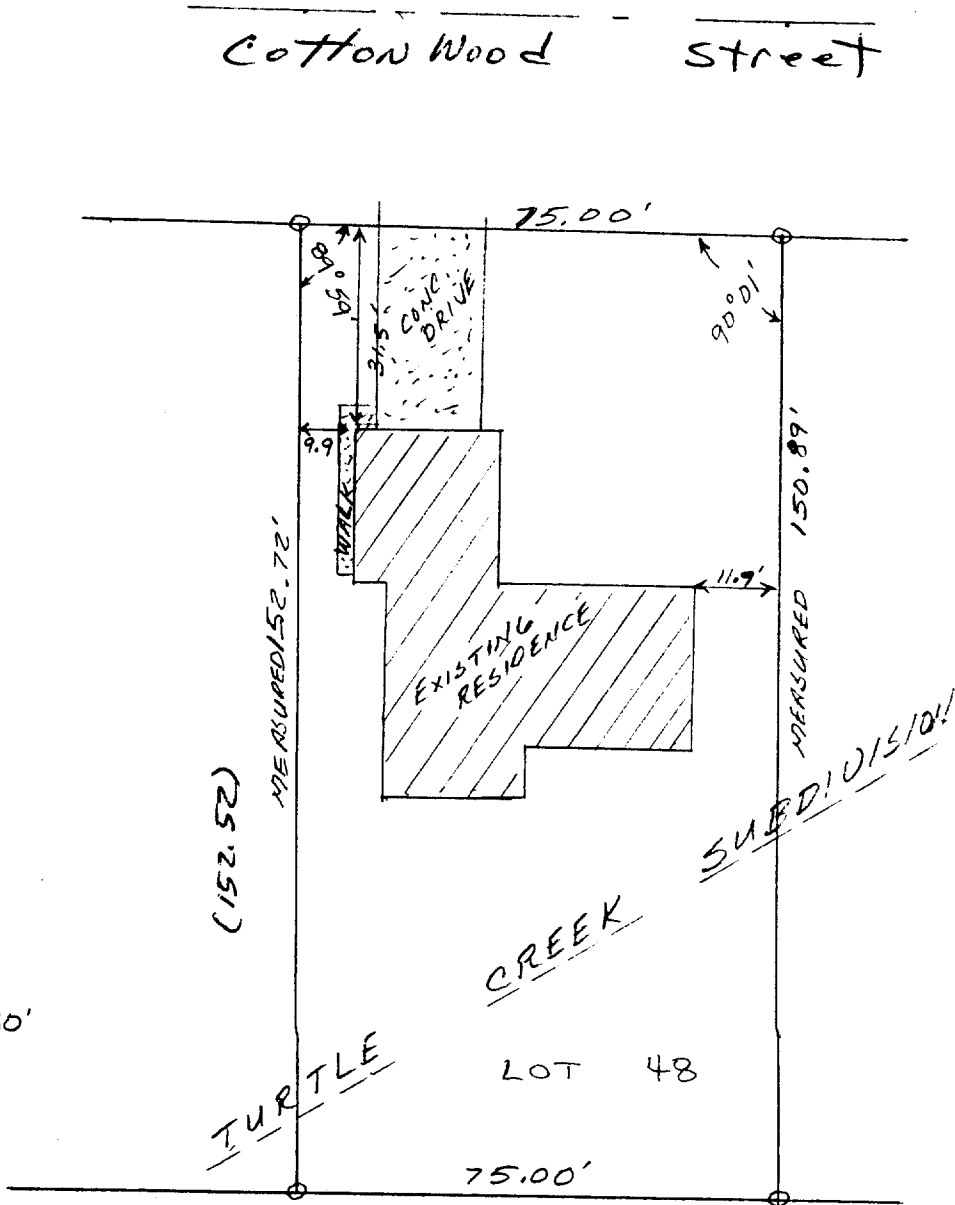

DRAWING No. 1900

2-675-C