

DUNHAM SURVEYING, S.C. SURVEYING & SUBDIVIDING DELAVAN, WISCONSIN 53115

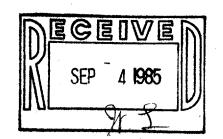

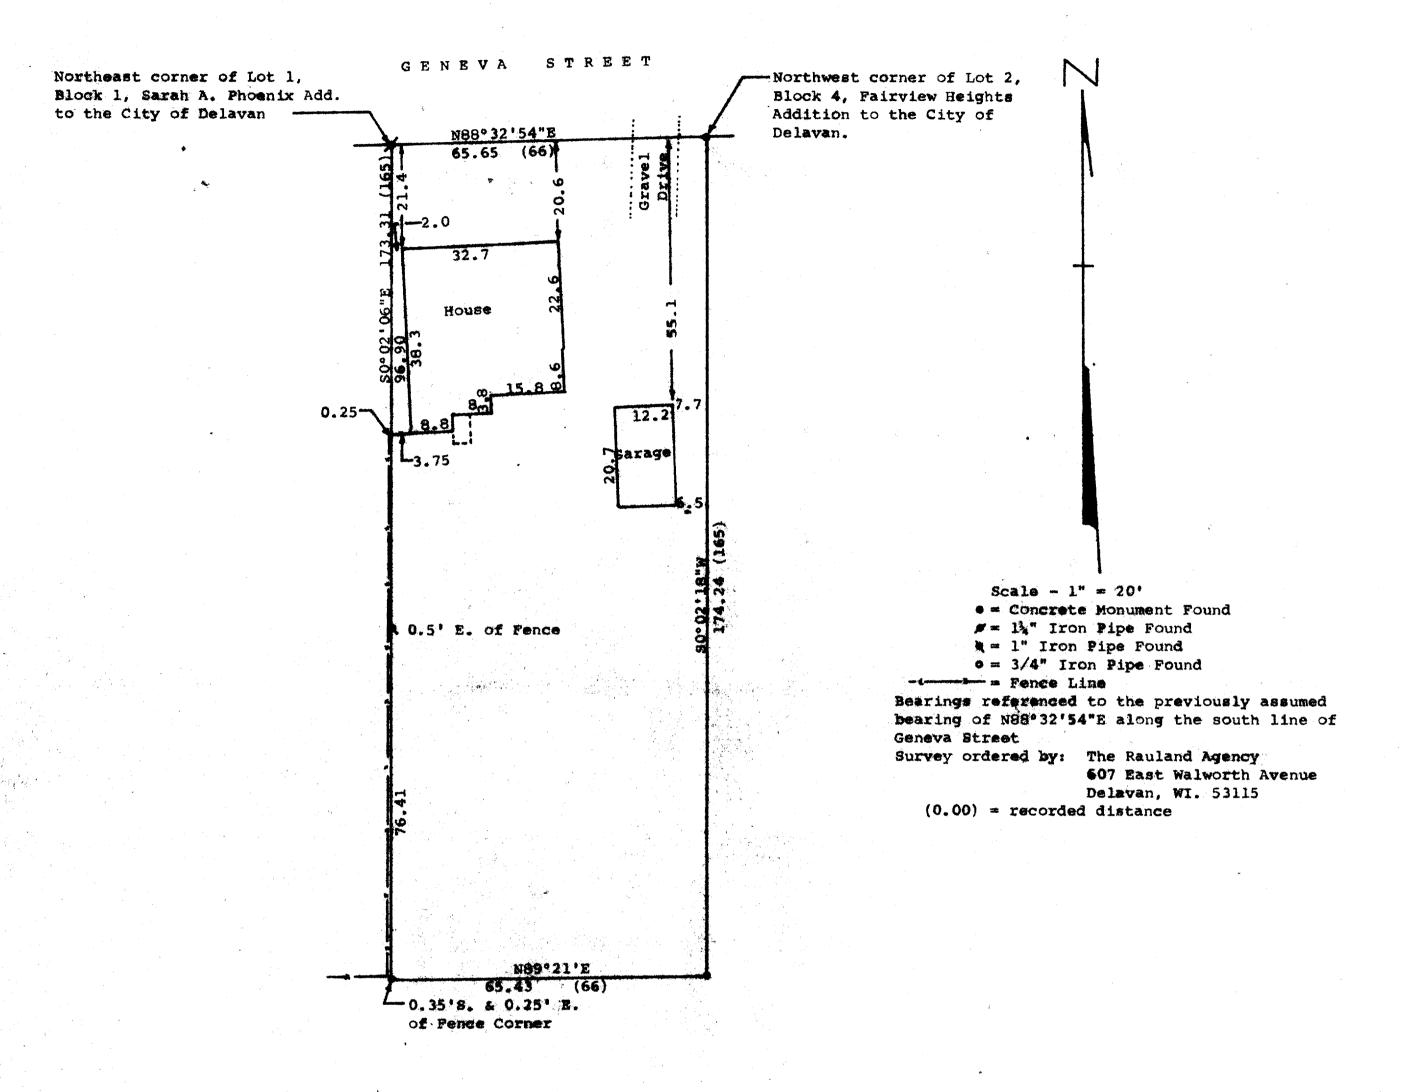

STATE OF WISCONSIN) BS COUNTY OF WALMORTH)

I, George T. Dunham, Surveyor, certify that I have surveyed the property described as follows:

A parcel of land located in the Southeast & of Section 18, T 2 N, R 16 E, City of Delavan, Walworth County, Wisconsin, described as follows: Beginning on the south line of Geneva Street, at the northeast corner of Lot 1, Block 1, Sarah A. Phoenix Addition to the Village (now City) of Delavan; thence 50°02'06"E along the east line of said Lot 1, 173.31 feet (described as 165 feet) to the southeast corner of said Lot 1; thence N89°21'E 65.43 feet (described as 66 feet) to the west line of Block 4, Fairview Heights Addition; thence NO°02'18"E 174.24 feet (described as 165 feet) to the northwest corner of Lot 2, block 4, Fairview Heights Addition; thence S88°32'54"W along the south line of Geneva Street 65.65 feet (described as 66 feet) to the place of beginning.

and that the map shown above is a true representation thereof and shows the size and location of the property, its exterior boundaries, the location of all visible structures and dimensions of all principal buildings thereon, boundary fences, apparent easements, roadways and visible engroachments, if any, and that I have surveyed the property hereon described according to the official records, to the best of my knowledge and belief. July 27, 1985

