


RECEIVED  
AUG 19 1986  
W. L.

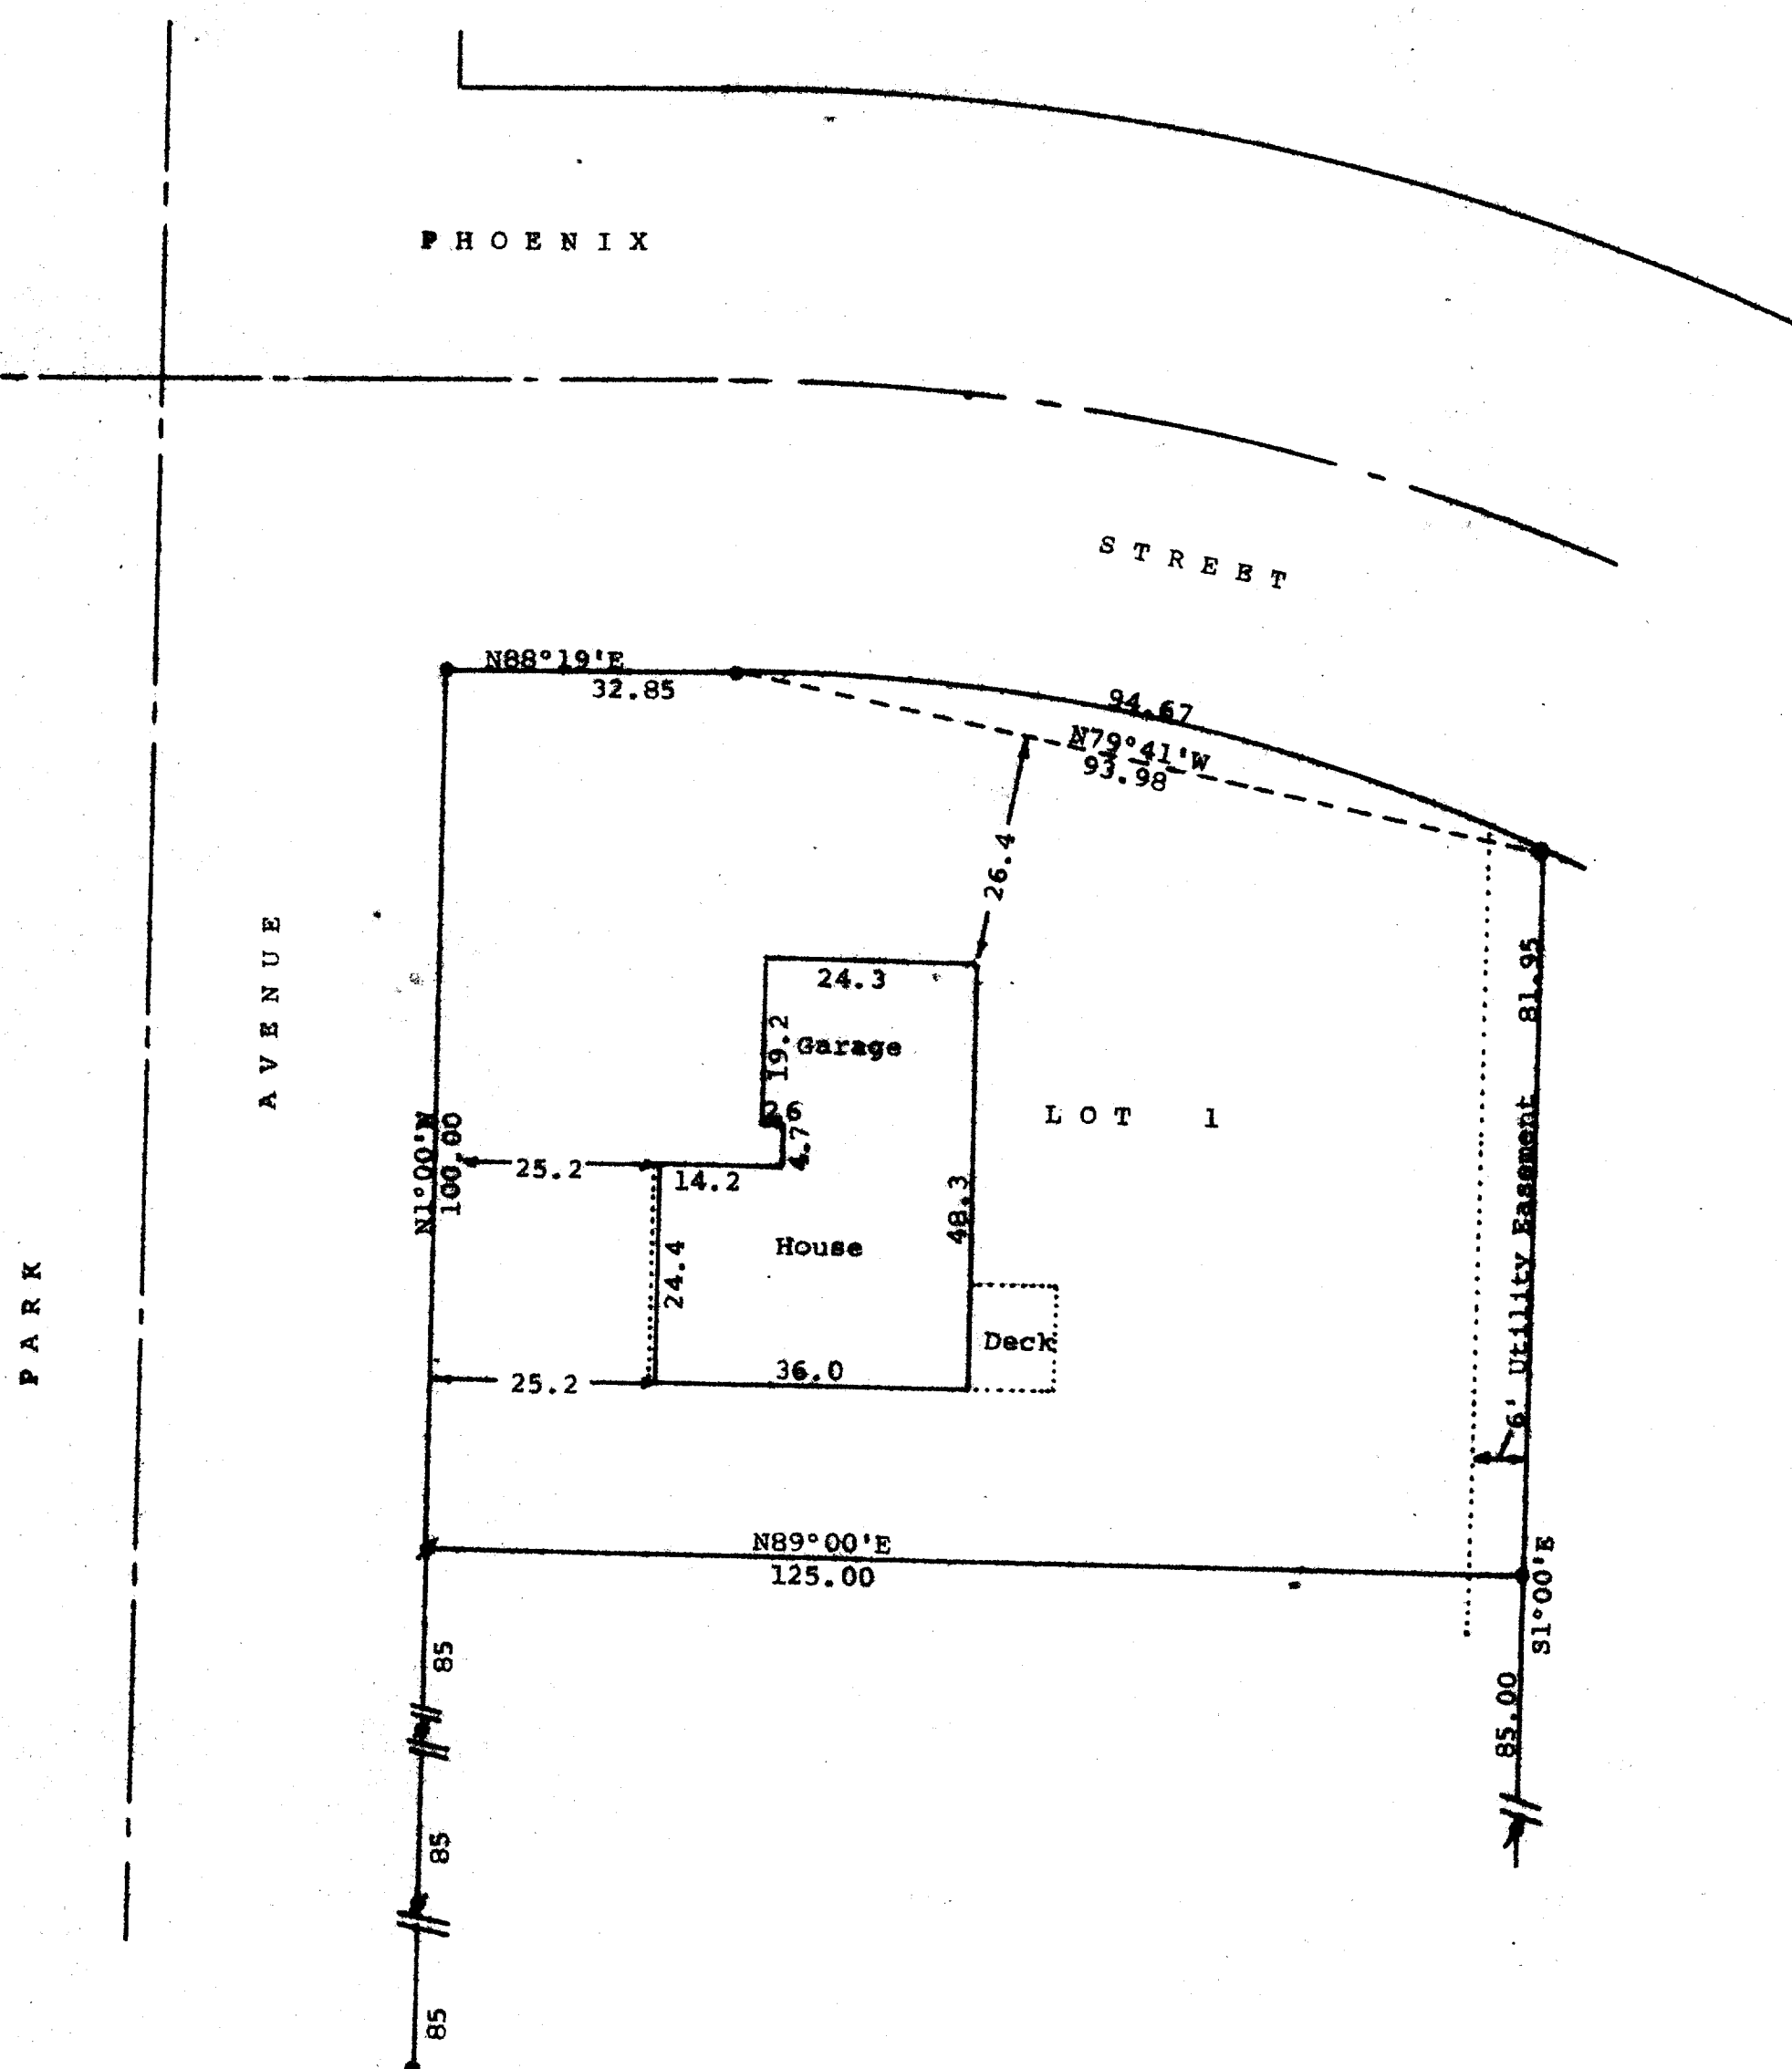

Better Homes & Gardens  
301 E. Walworth Avenue  
Delavan, WI 53115