



DUNHAM SURVEYING, S.C.
SURVEYING & SUBDIVIDING
DELAVAN, WISCONSIN 53115

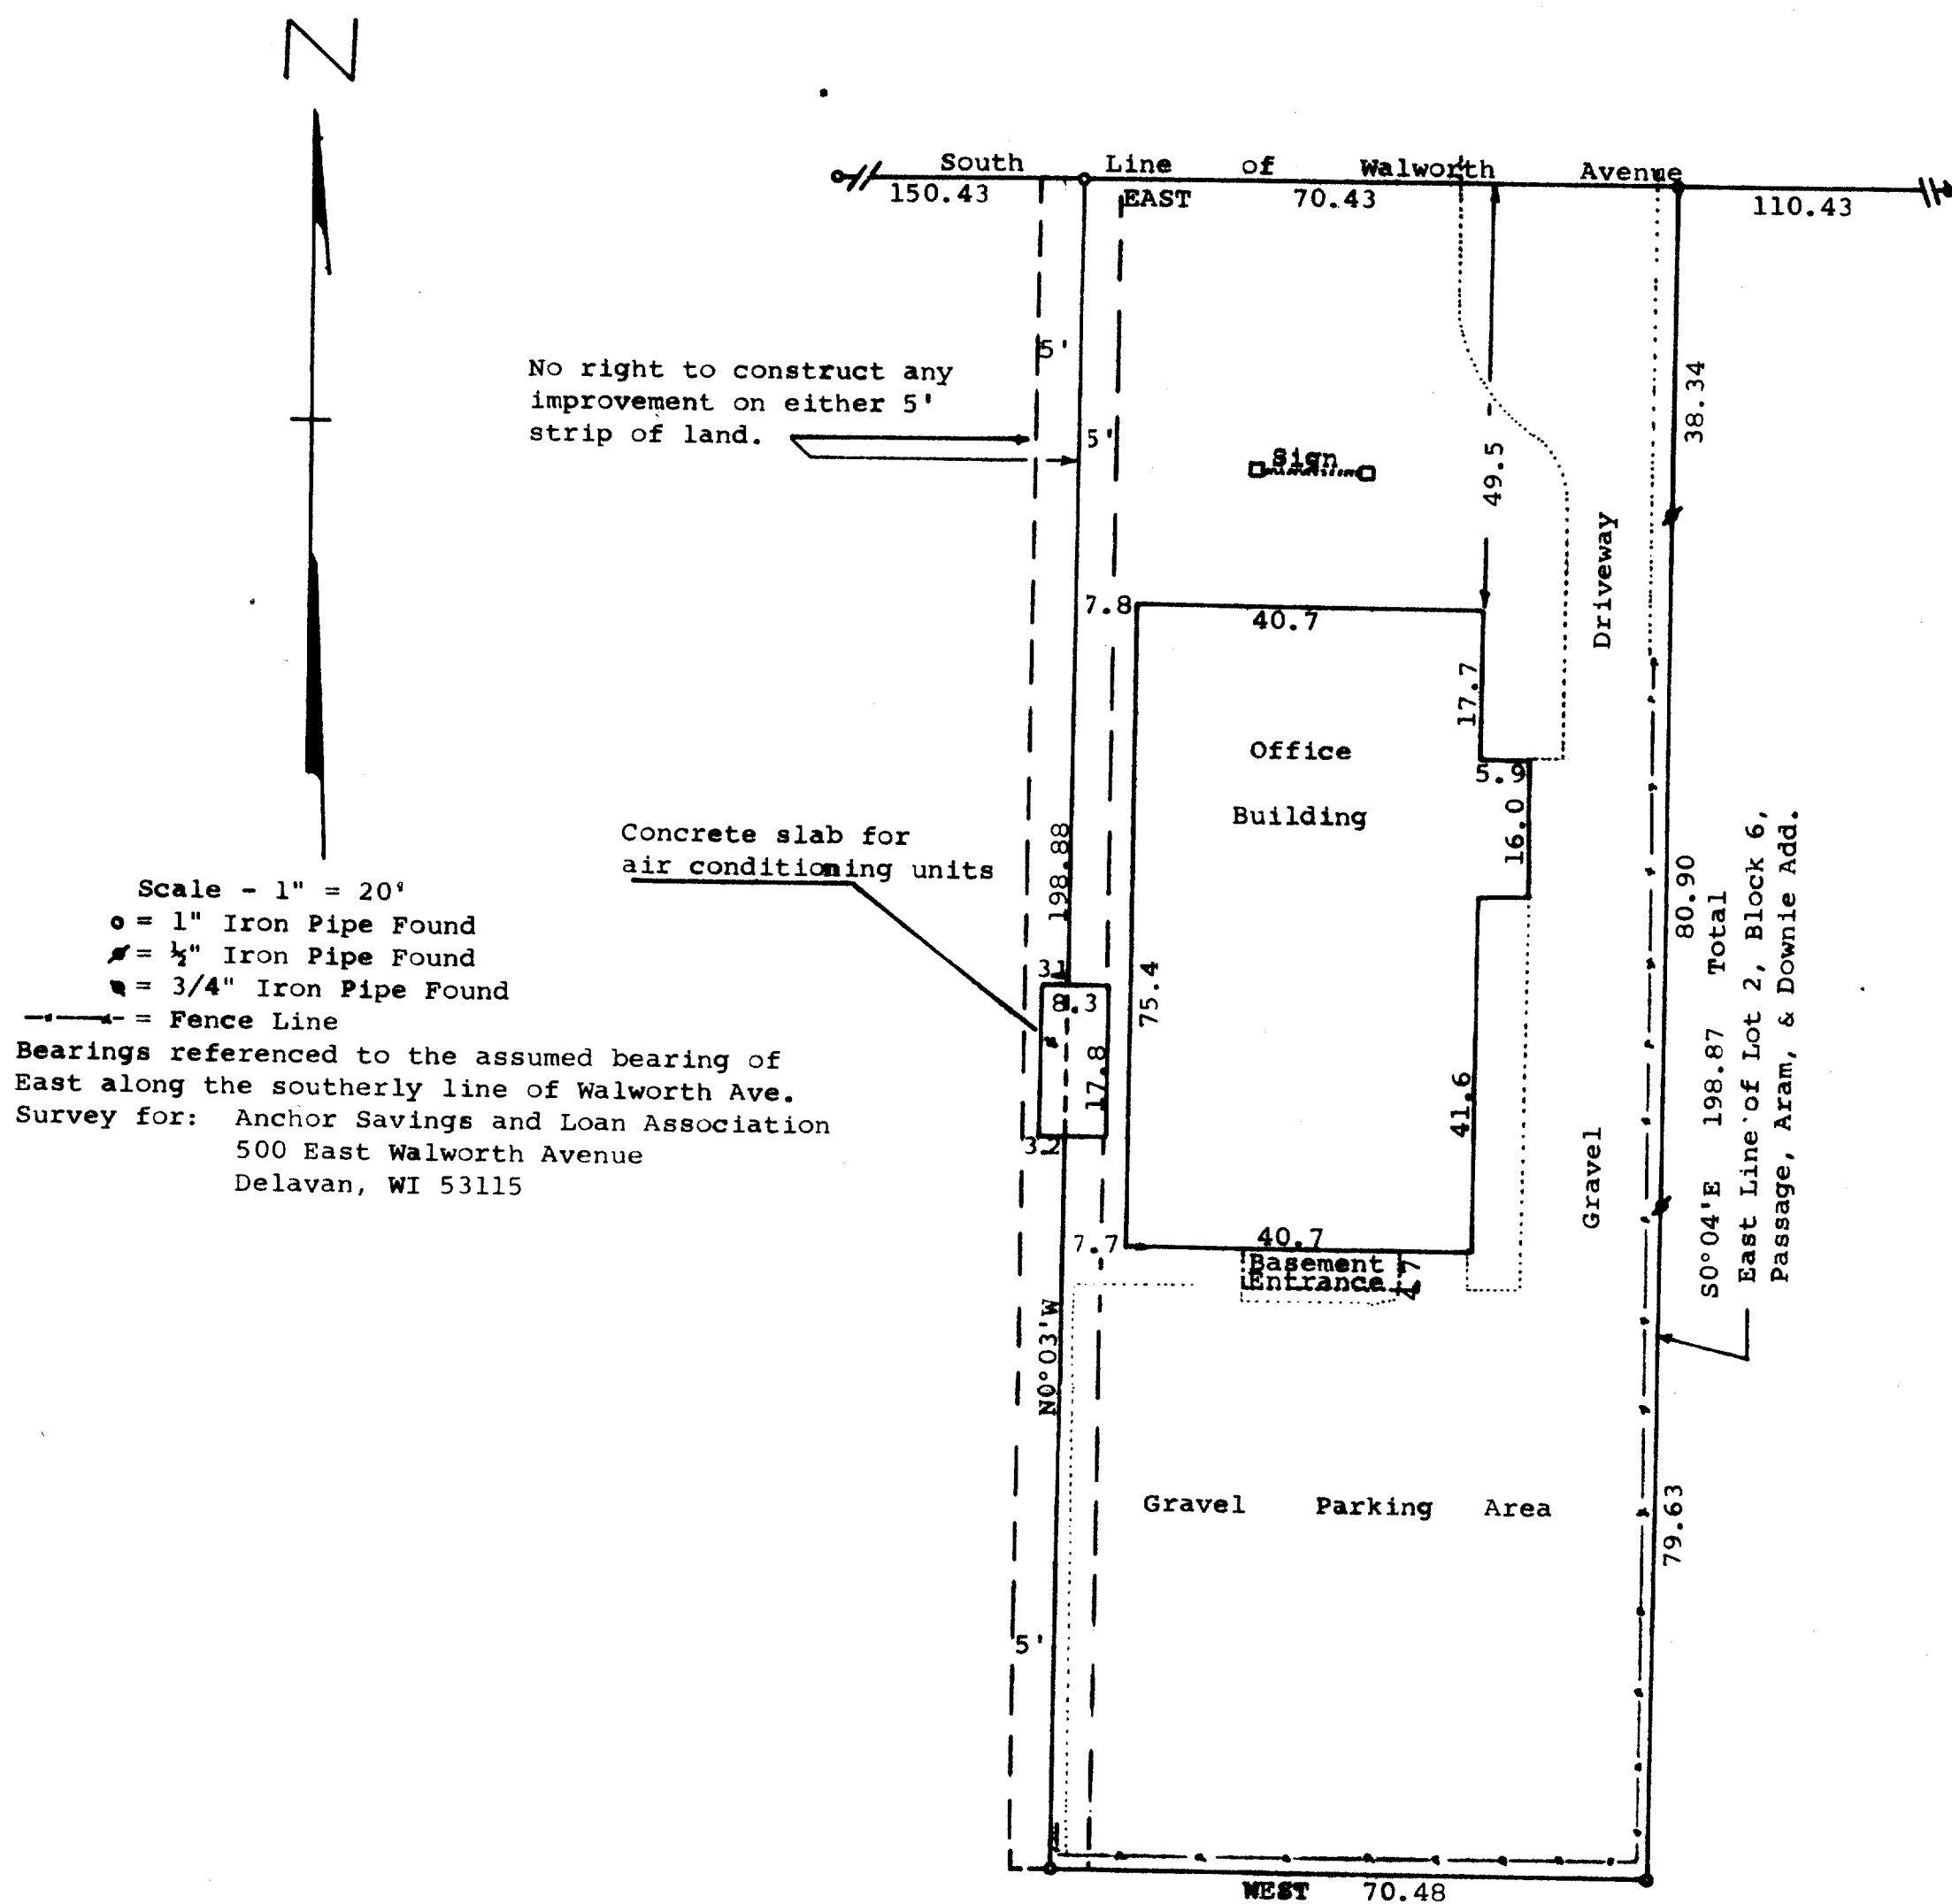

STATE OF WISCONSIN) SS
 COUNTY OF WALWORTH)
 I, George T. Dunham, Surveyor, certify that I have surveyed the property described as follows:
 Lot 2 in Block 6 of Passage, Aram & Downie's Addition to the Village (Now City) of Delavan, Walworth County, Wisconsin, except the West 40.00 feet thereof, subject to easements of record,
 and that the map shown above is a true representation thereof and shows the size and location of the property, its exterior boundaries, the location of all visible structures and dimensions of all principal buildings thereon, boundary fences, apparent easements, roadways and visible encroachments, if any, and that I have surveyed the property hereon described according to the official records to the best of my knowledge and belief.
 October 15, 1985

George T. Dunham
 George T. Dunham, Surveyor

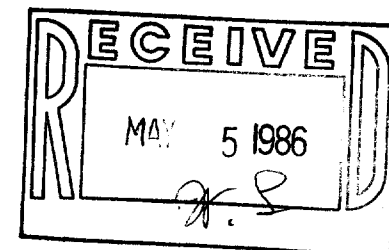