



DUNHAM SURVEYING, S.C.  
SURVEYING & SUBDIVIDING  
DELAVER, WISCONSIN 53115

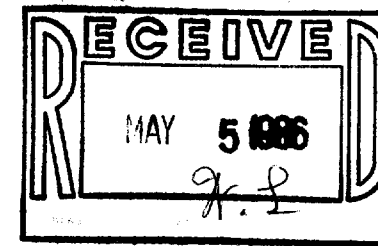

SYCAMORE

STREET

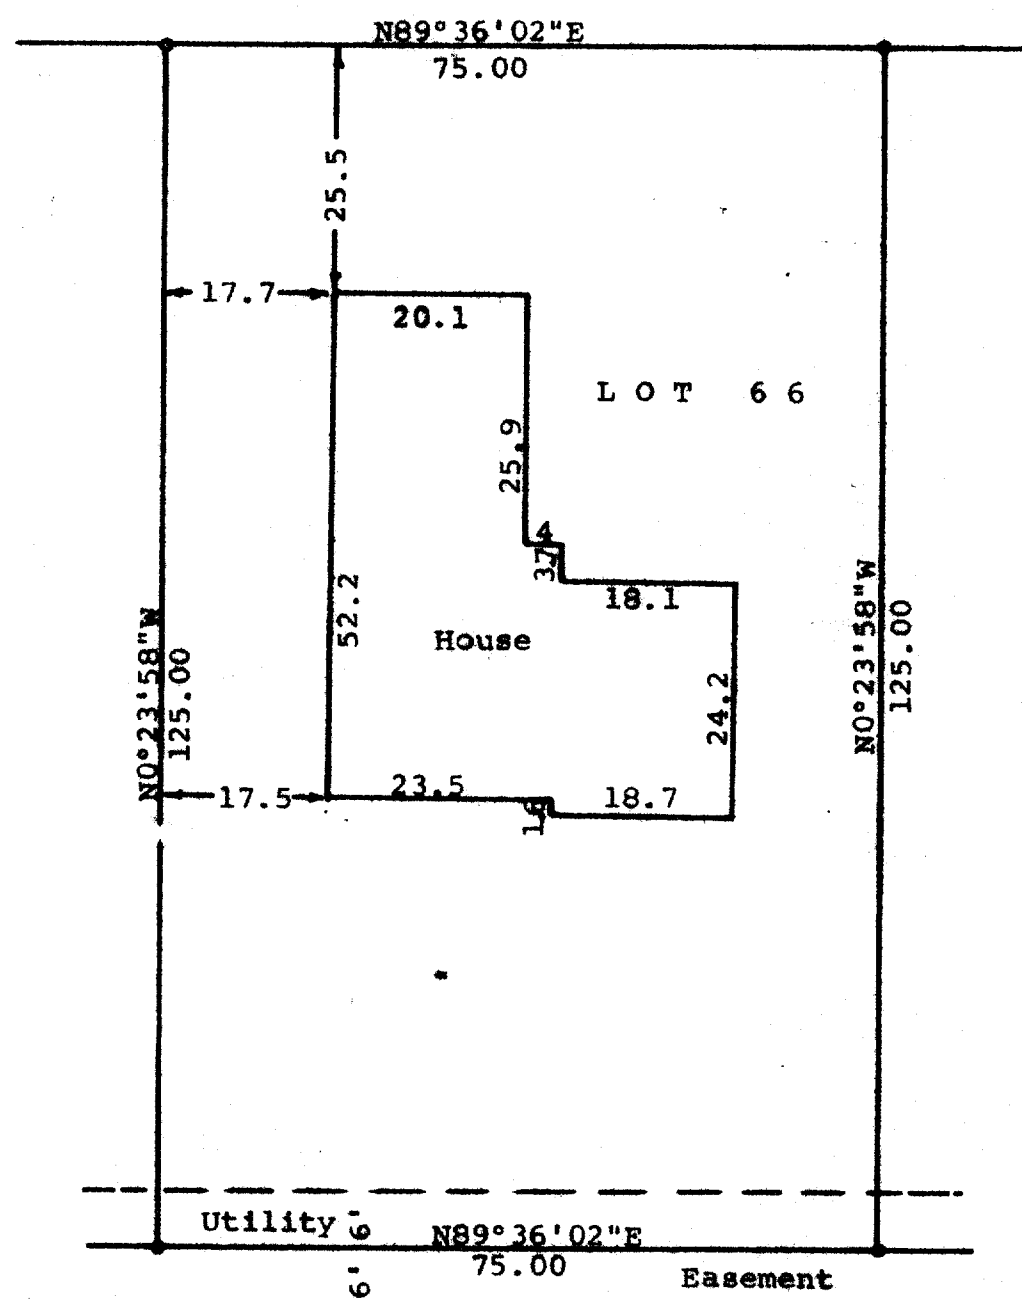

N

Scale - 1" = 20'  
• = 1" Iron Pipe Found  
• = 5/8" Iron Rod Found  
Bearings are those as shown on the recorded plat of Turtle Creek  
Survey ordered by: Custom Homes by Tim Mack  
826 Alpine Drive  
Janesville, WI 53546

STATE OF WISCONSIN)  
COUNTY OF WALWORTH) SS

I, George T. Dunham, Surveyor, certify that I have surveyed the property described as follows:

Lot 66 in Turtle Creek, a subdivision located in Section 13, T 2 N, R 15 E, City of Delavan, Walworth County, Wisconsin, and that the map shown above is a true representation thereof and shows the size and location of the property, its exterior boundaries, the location of all visible structures and dimensions of all principal buildings thereon, boundary fences, apparent easements, roadways and visible encroachments, if any, and that I have surveyed the property hereon described according to the official records to the best of my knowledge and belief.  
January 10, 1986

*George T. Dunham*  
George T. Dunham, Surveyor

