



DUNHAM SURVEYING, S.C.  
SURVEYING & SUBDIVIDING  
DELAVAN, WISCONSIN 53115

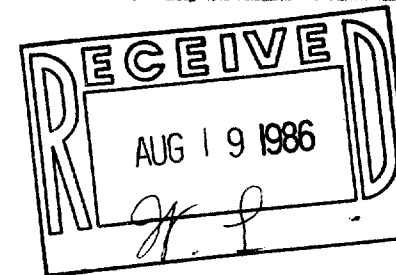

SEVENTH

STREET

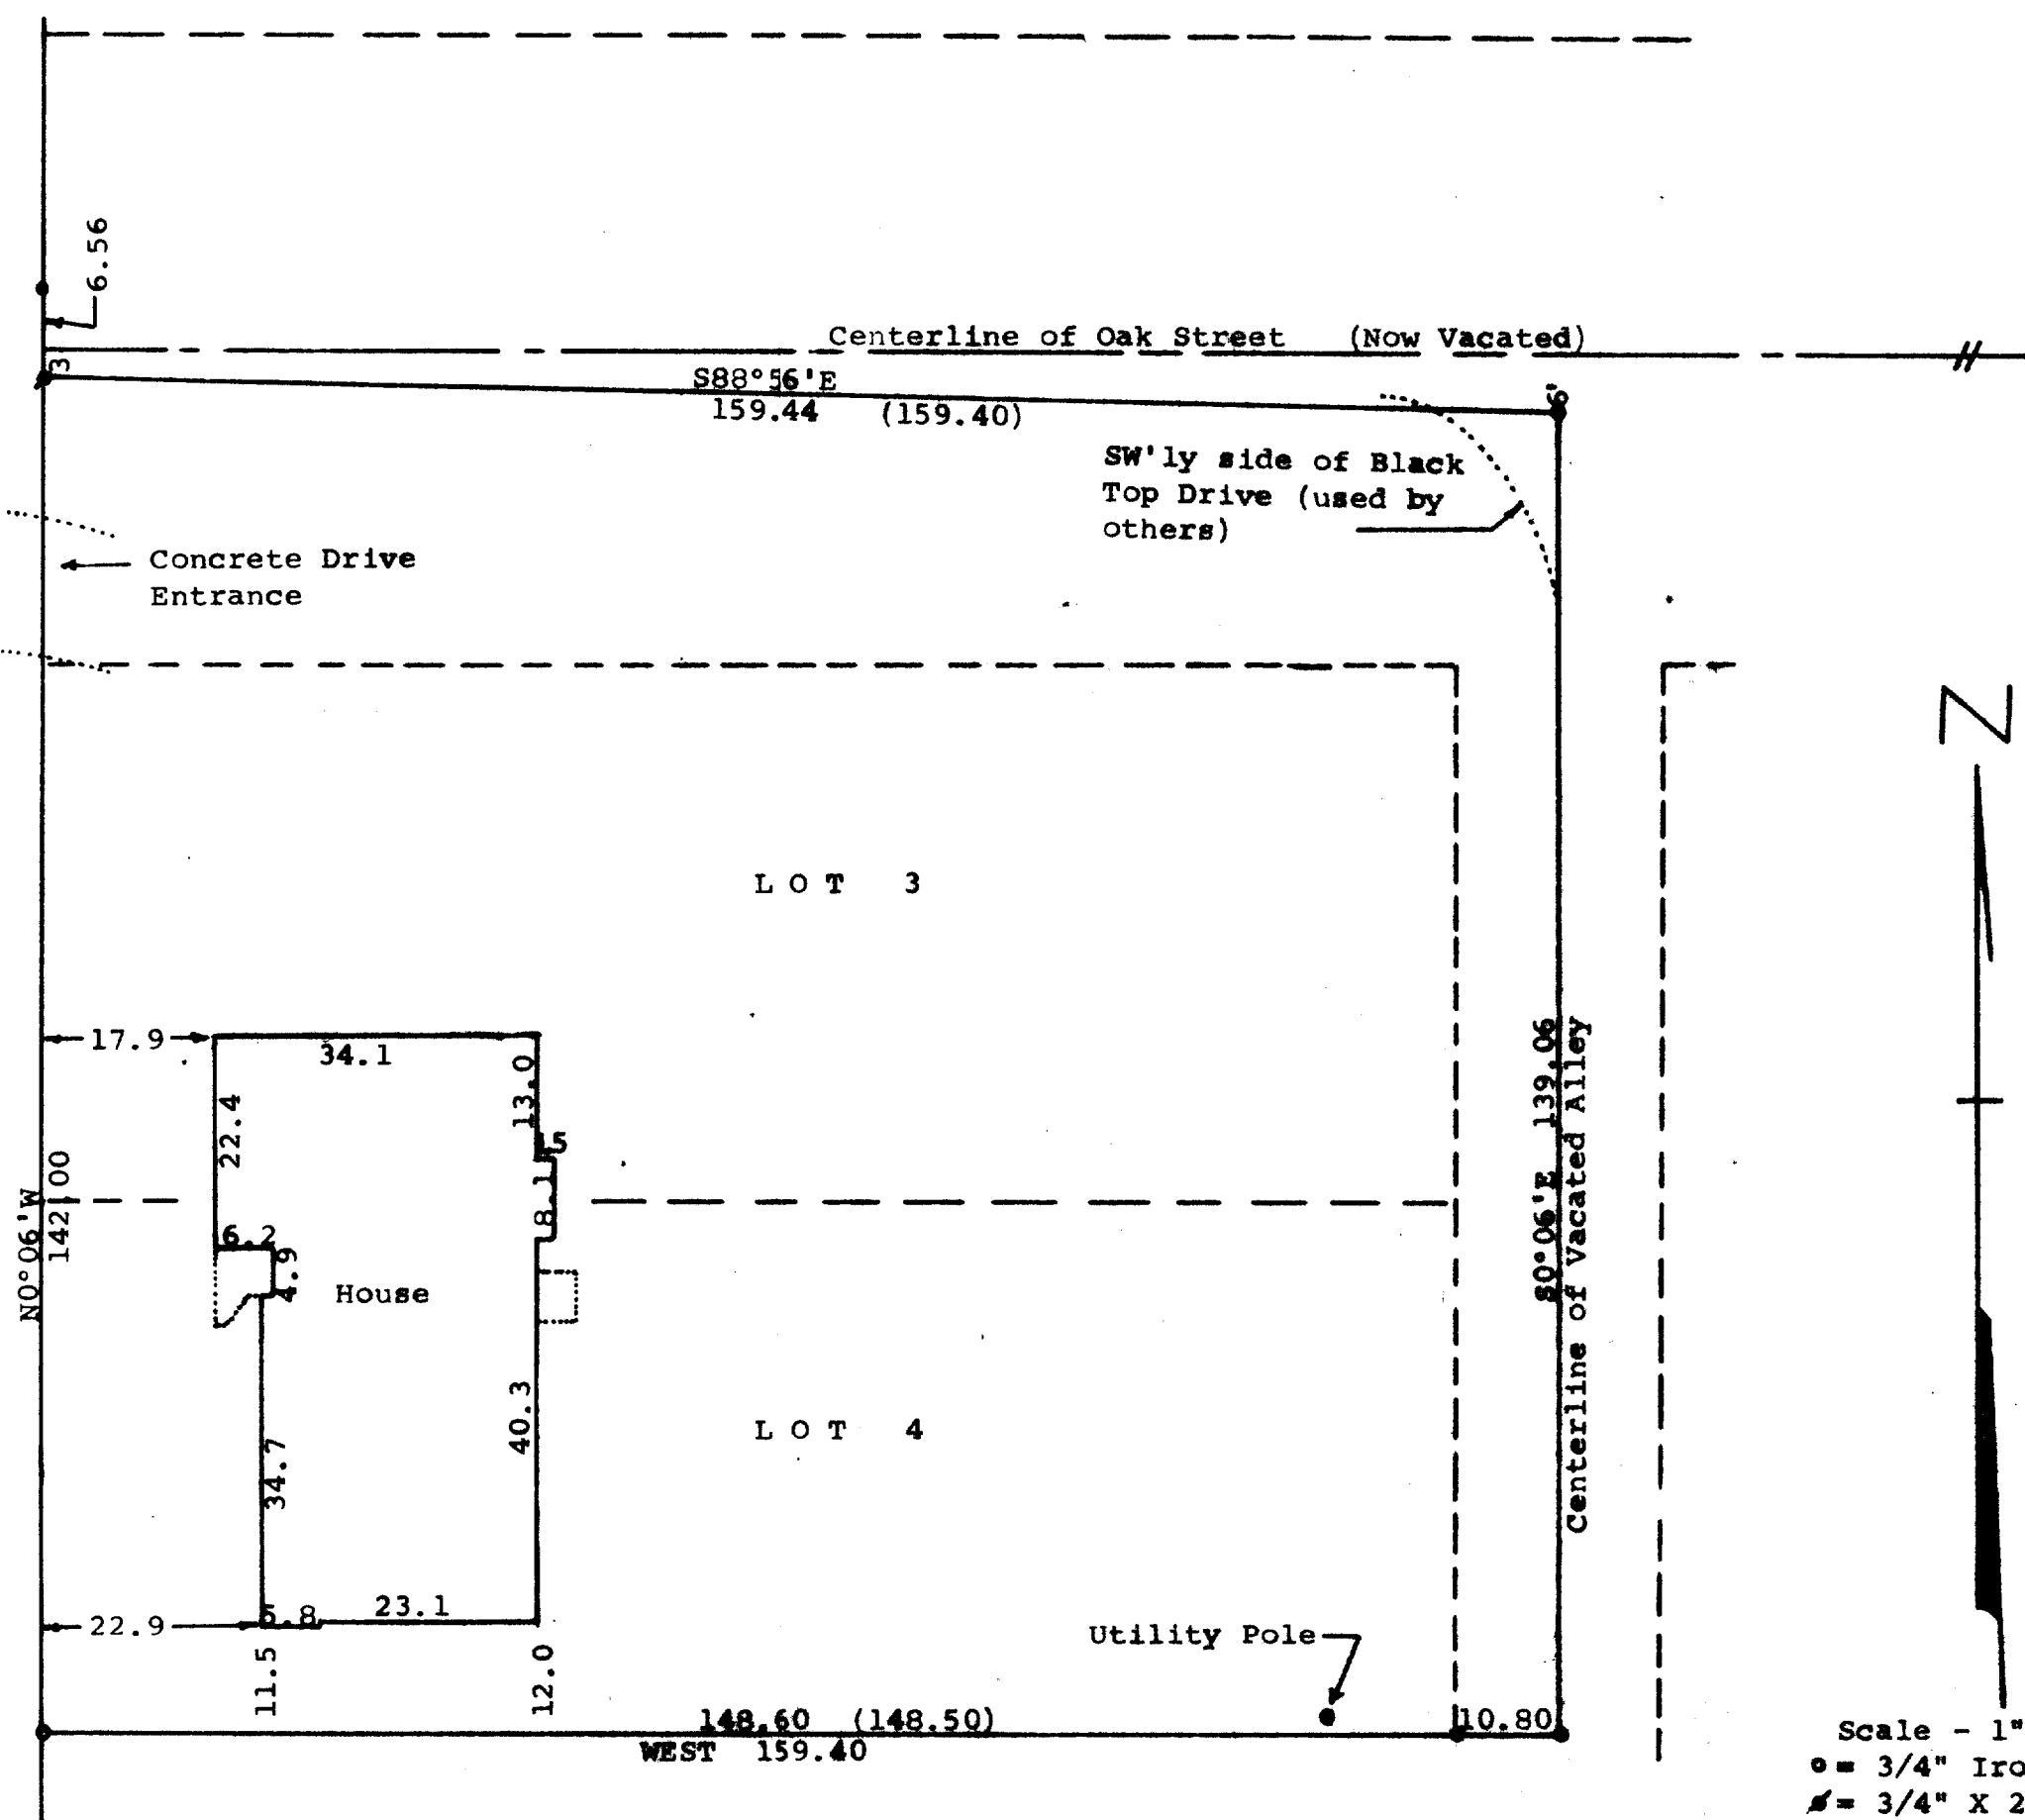

Scale - 1" = 20'  
 • = 3/4" Iron Pipe Found  
 / = 3/4" X 24" Iron Pipe Set  
 • = 1" X 24" Iron Pipe Set  
 (0.00) = recorded distance  
 Bearings referenced to the  
 previously recorded bearing of  
 N0°06'W along the east line of  
 Seventh Street.  
 Survey ordered by:  
 Century 21, Skandia Realty Inc.  
 312 South Seventh Street  
 Delavan, WI 53115

STATE OF WISCONSIN)  
COUNTY OF WALWORTH) SS


I, George T. Dunham, Surveyor, certify that I have surveyed  
the property described as follows:

Lots 3 and 4 of Katie A. Lathrop's Second Addition to the City  
of Delavan, Walworth County, Wisconsin together with the West 1/4  
of the Vacated Alley lying immediately east of said Lots 3 and 4,  
and the South 1/4 of Oak Street (Now Vacated) lying immediately  
north of said Lot 3 and north of the West 1/4 of the said vacated  
alley, EXCEPTING the following described part of said vacated Oak  
Street: Commencing at the northwest corner of Lot 3 of Katie A.  
Lathrop's Second Addition to the City of Delavan; thence N0°06'W  
along the east line of North Seventh Street, 30.00 feet to the place  
of Beginning; thence continue N0°06'W along the east line of North  
Seventh Street, 3.00 feet to the point of intersection of said east  
line with the centerline of now vacated Oak Street; thence East along  
the centerline of said vacated Oak Street 159.40 feet; thence S0°06'E  
6.00 feet; thence N88°56'W 159.44 (described as 159.40) feet to the  
place of beginning.

and that the above map is a true representation thereof and shows the size and  
location of the property, its exterior boundaries, the location of all visible  
structures and dimensions of all principal buildings thereon, boundary fences,  
apparent easements, roadways and visible encroachments, if any, and that I have  
surveyed the property hereon described according to the official records to the  
best of my knowledge and belief.

August 14, 1985

*George T. Dunham*  
George T. Dunham, Surveyor

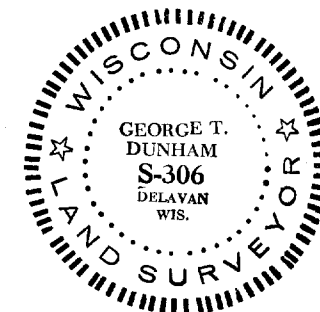

XL A2-1A

2-715-D