



ABELL
SURVEYING & MAPPING
DELAVAN, WISCONSIN 53115
414-728-6737

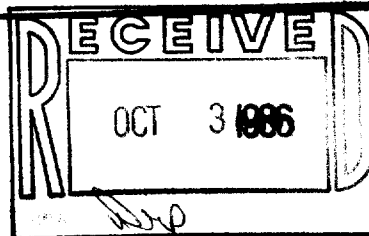

GENEVA


STREET

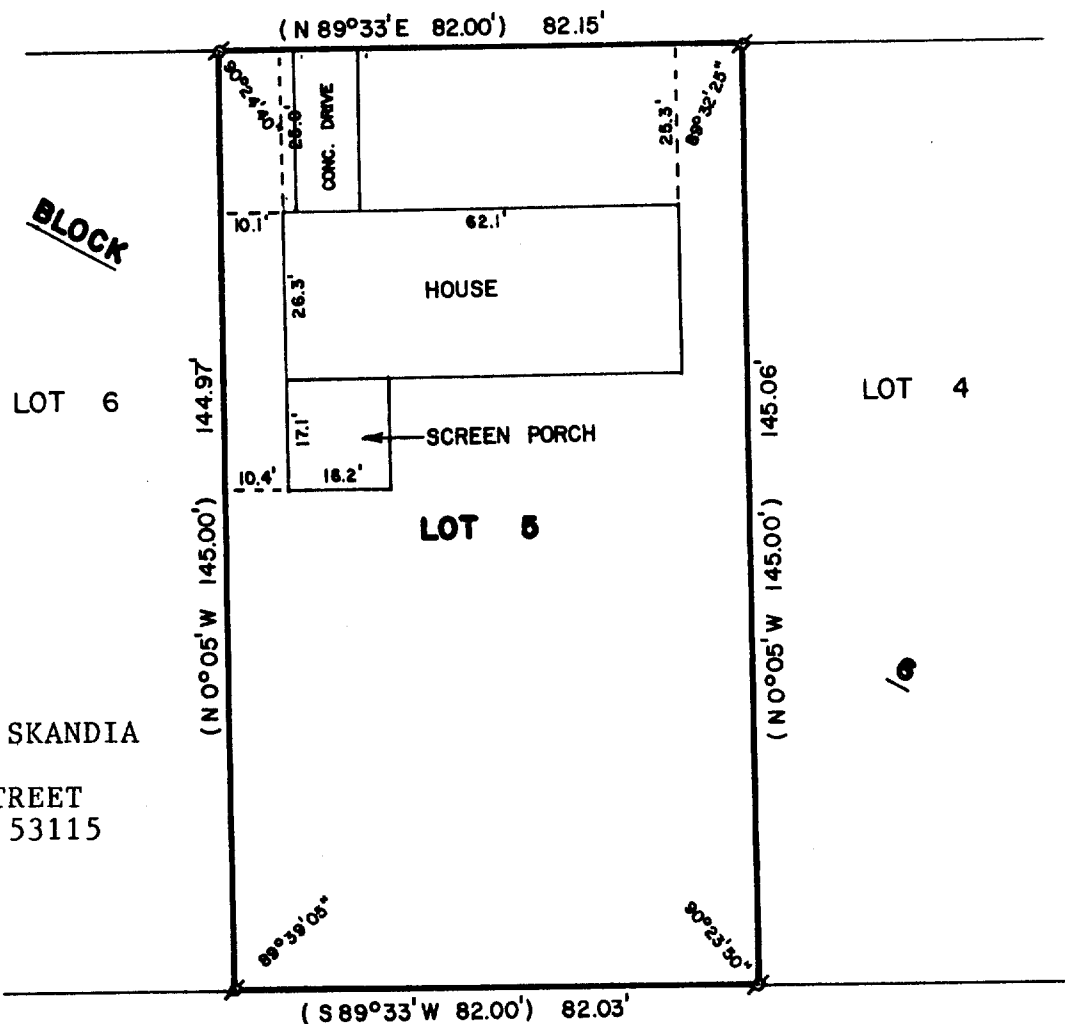

ORDERED BY:
CENTURY 21 - SKANDIA
REALTY
312 S. 7th STREET
DELAVAN, WI 53115

PLAT OF SURVEY OF

LOT 5, BLOCK 6, SPRINGS PARK SUBDIVISION,
CITY OF DELAVAN, WALWORTH COUNTY, WISCONSIN.

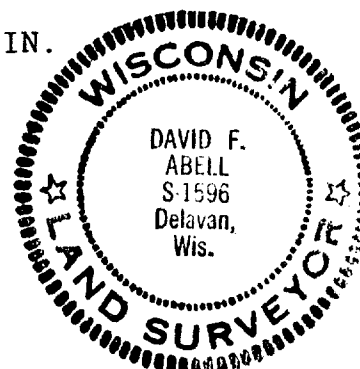

SCALE - 1"=30'

LEGEND

Ø - IRON PIPE FOUND
() - RECORDED AS

I, DAVID F. ABELL, DO HEREBY CERTIFY
THAT I HAVE SURVEYED THE PROPERTY
HEREON DESCRIBED ACCORDING TO THE
OFFICIAL RECORDS, AND THAT THE PLAT
HEREON IS A CORRECT REPRESENTATION
OF THE PROPERTY LINES TO THE BEST OF
MY KNOWLEDGE AND BELIEF.

David F. Abell
DAVID F. ABELL

WISCONSIN REGISTERED LAND SURVEYOR, S-1596

DATE *August 13, 1986* JOB NUMBER - 86033