



ABELL
WISCONSIN ST. SURVEYING & MAPPING
DELAVER, WISCONSIN 53115
414-728-6737

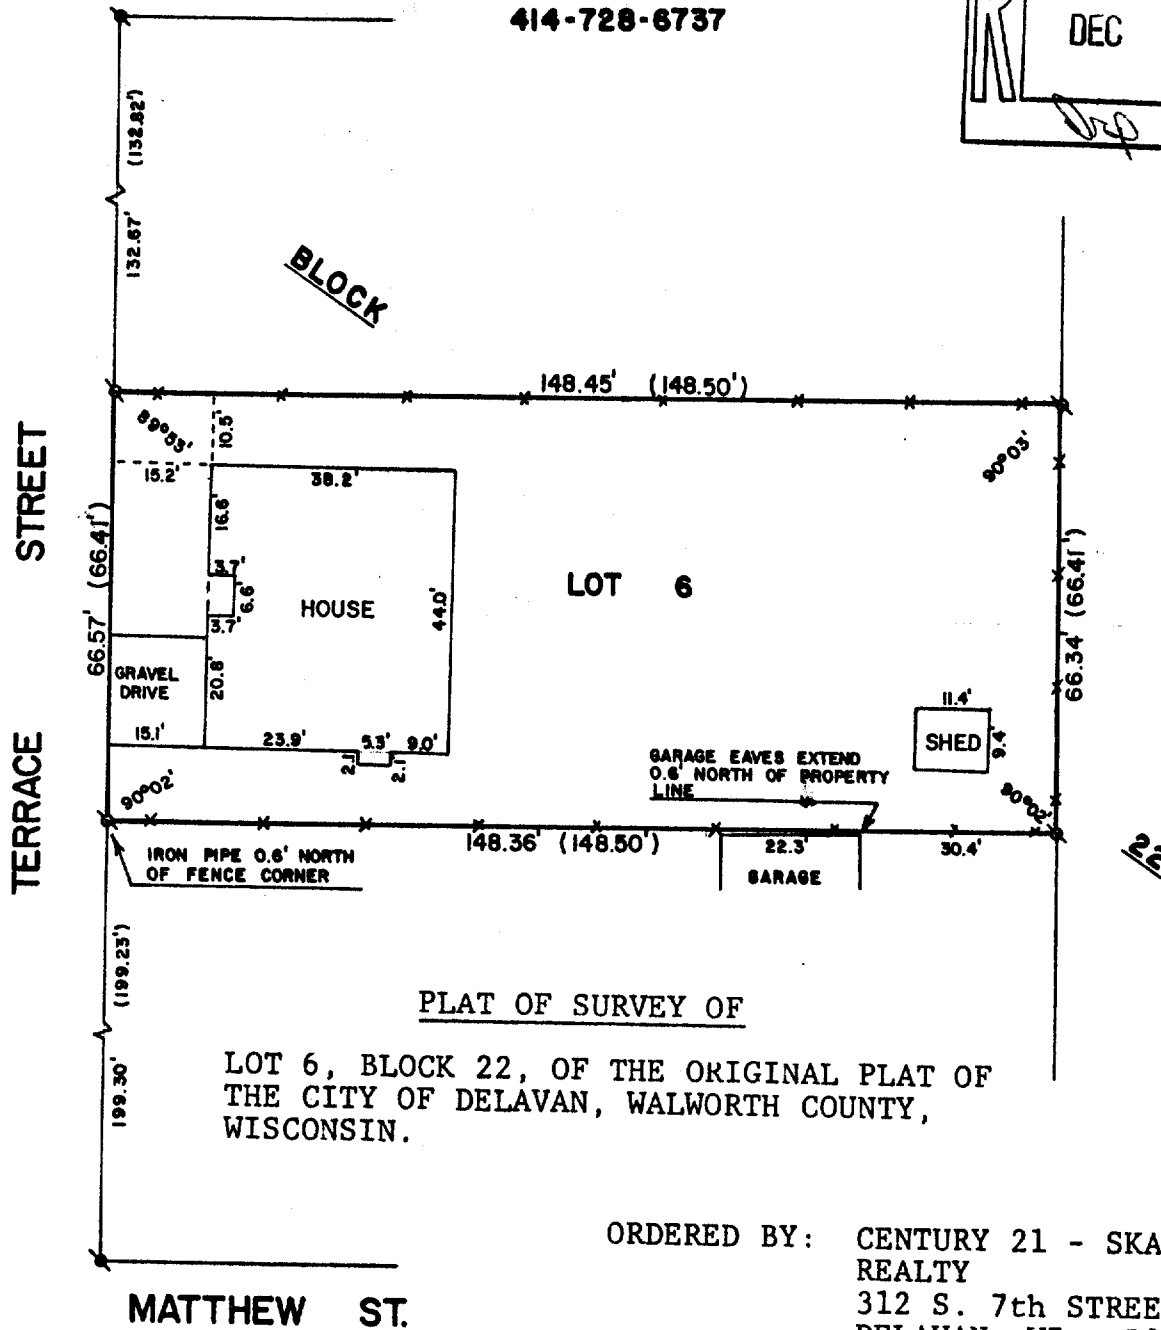


ORDERED BY: CENTURY 21 - SKANDIA
REALTY
312 S. 7th STREET
DELAVER, WI 53115

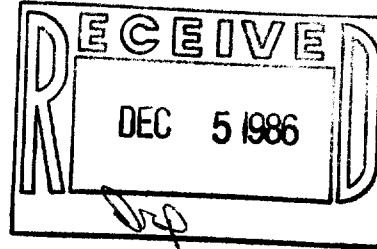

SCALE - 1"=30'

LEGEND

- IRON PIPE FOUND
- CONCRETE MONUMENT FOUND
- FENCE
- () - AS SHOWN ON CITY ENGINEERS RECORDS

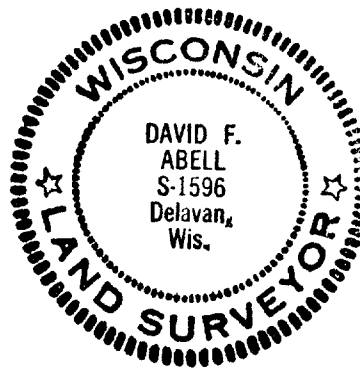

I, DAVID F. ABELL, DO HEREBY CERTIFY
THAT I HAVE SURVEYED THE PROPERTY
HEREON DESCRIBED ACCORDING TO THE
OFFICIAL RECORDS AND THAT THE PLAT
HEREON IS A CORRECT REPRESENTATION
OF THE PROPERTY LINES TO THE BEST OF
MY KNOWLEDGE AND BELIEF.

David F. Abell
DAVID F. ABELL
WISCONSIN REGISTERED LAND SURVEYOR, S-1596

November 10, 1986
DATE JOB NUMBER - 86068