



ABELL
SURVEYING & MAPPING
 DELAVAN, WISCONSIN 53115
 414-728-6737

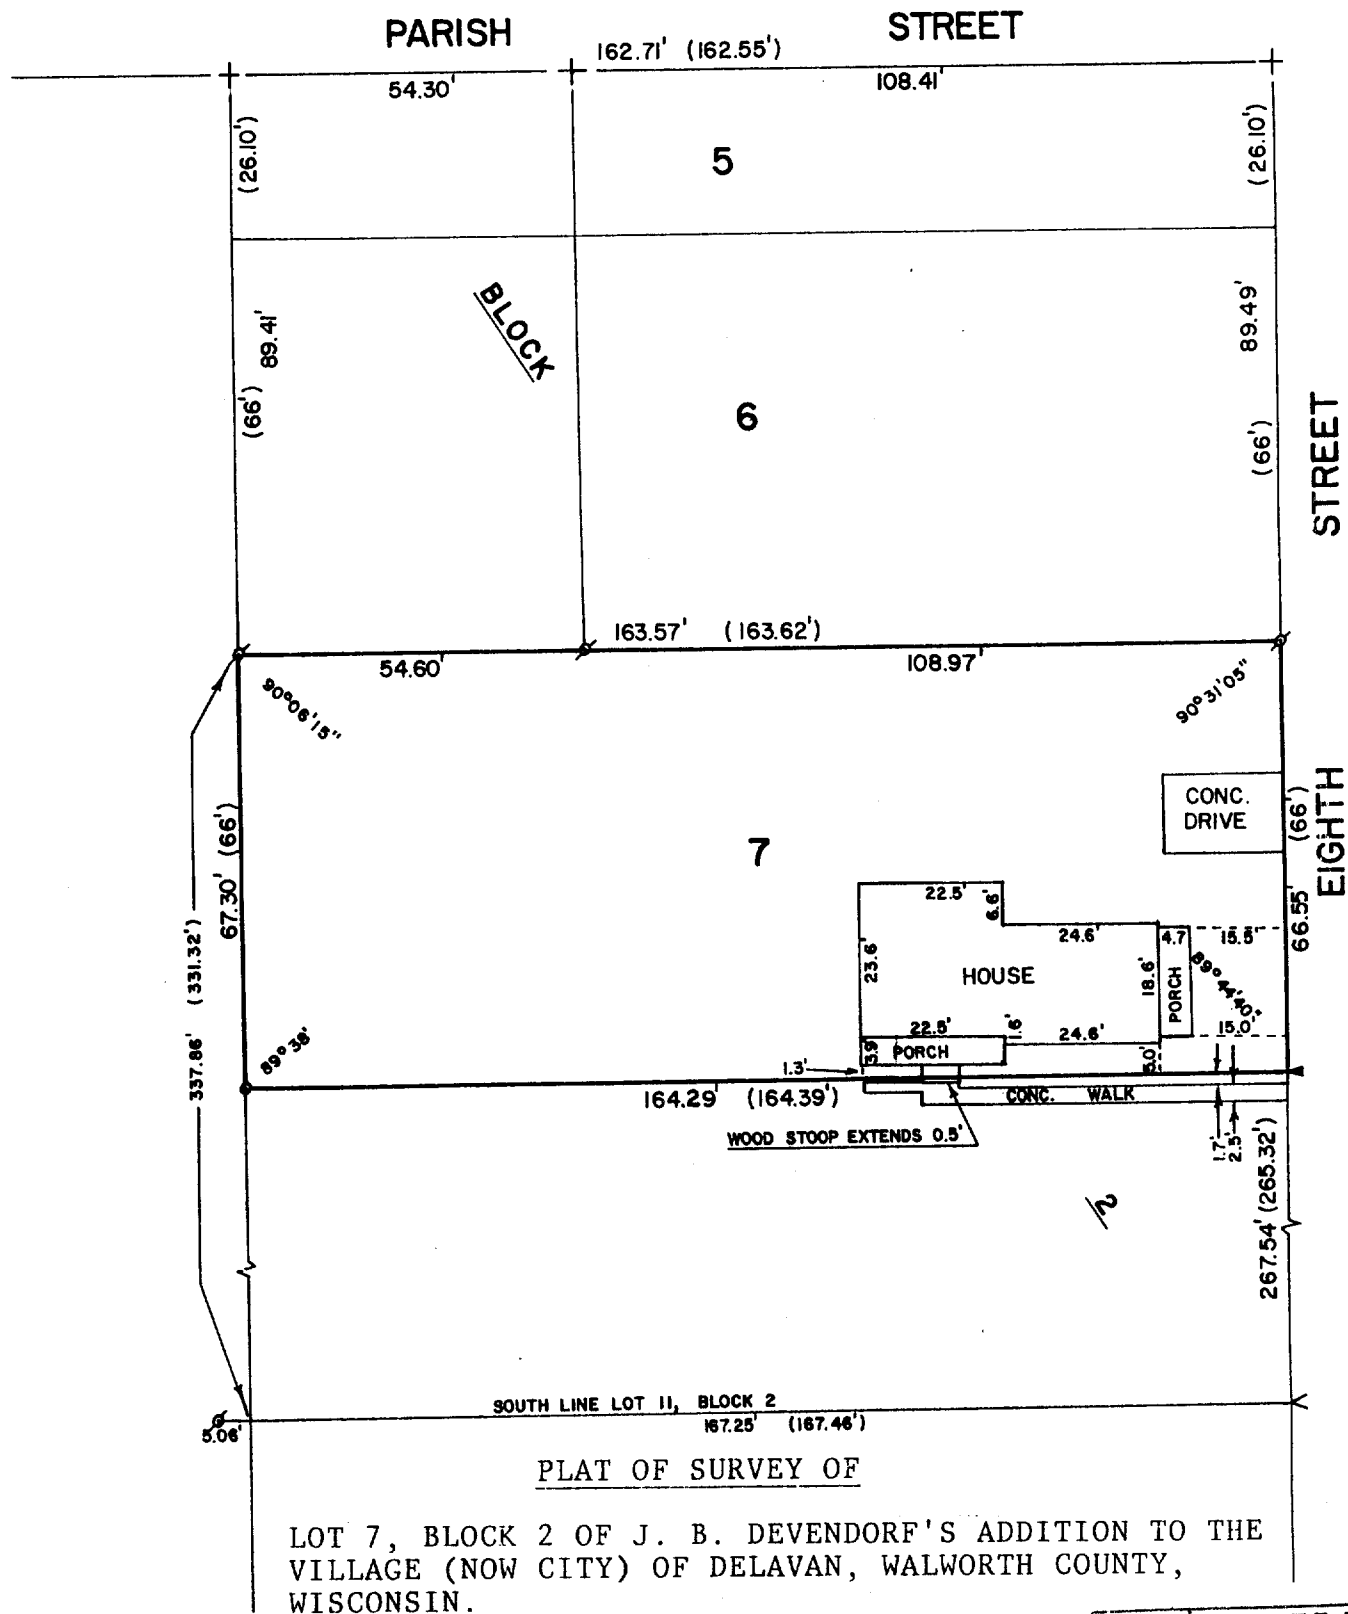

ORDERED BY: HARRY JENSEN
 212 NORTH 8th ST.
 DELAVAN, WI 53115

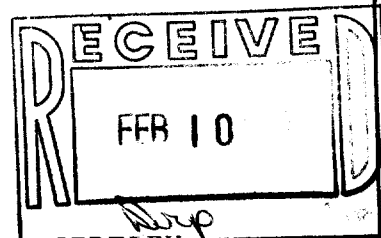

SCALE - 1"=30'

LEGEND

- ⊙ - IRON PIPE FOUND
- - IRON PIPE SET
- + - CUT CROSS IN CONCRETE FOUND
- < - CUT V IN CONCRETE FOUND
- ▲ - CUT V IN WEST EDGE OF CONCRETE WALK PLACED
- () - RECORDED DISTANCES

I, DAVID F. ABELL, DO HEREBY CERTIFY THAT I HAVE SURVEYED THE PROPERTY HEREON DESCRIBED ACCORDING TO THE OFFICIAL RECORDS AND THAT THE PLAT HEREON IS A CORRECT REPRESENTATION OF THE PROPERTY LINES TO THE BEST OF MY KNOWLEDGE AND BELIEF.

David F. Abell
 DAVID F. ABELL
 WISCONSIN REGISTERED LAND SURVEYOR, S-1596

DATE *January 13, 1987* JOB NUMBER - 87003

NOTE: THIS IS NOT A CERTIFIED COPY UNLESS SEALED.