


RECEIVED
MAR 10 1987

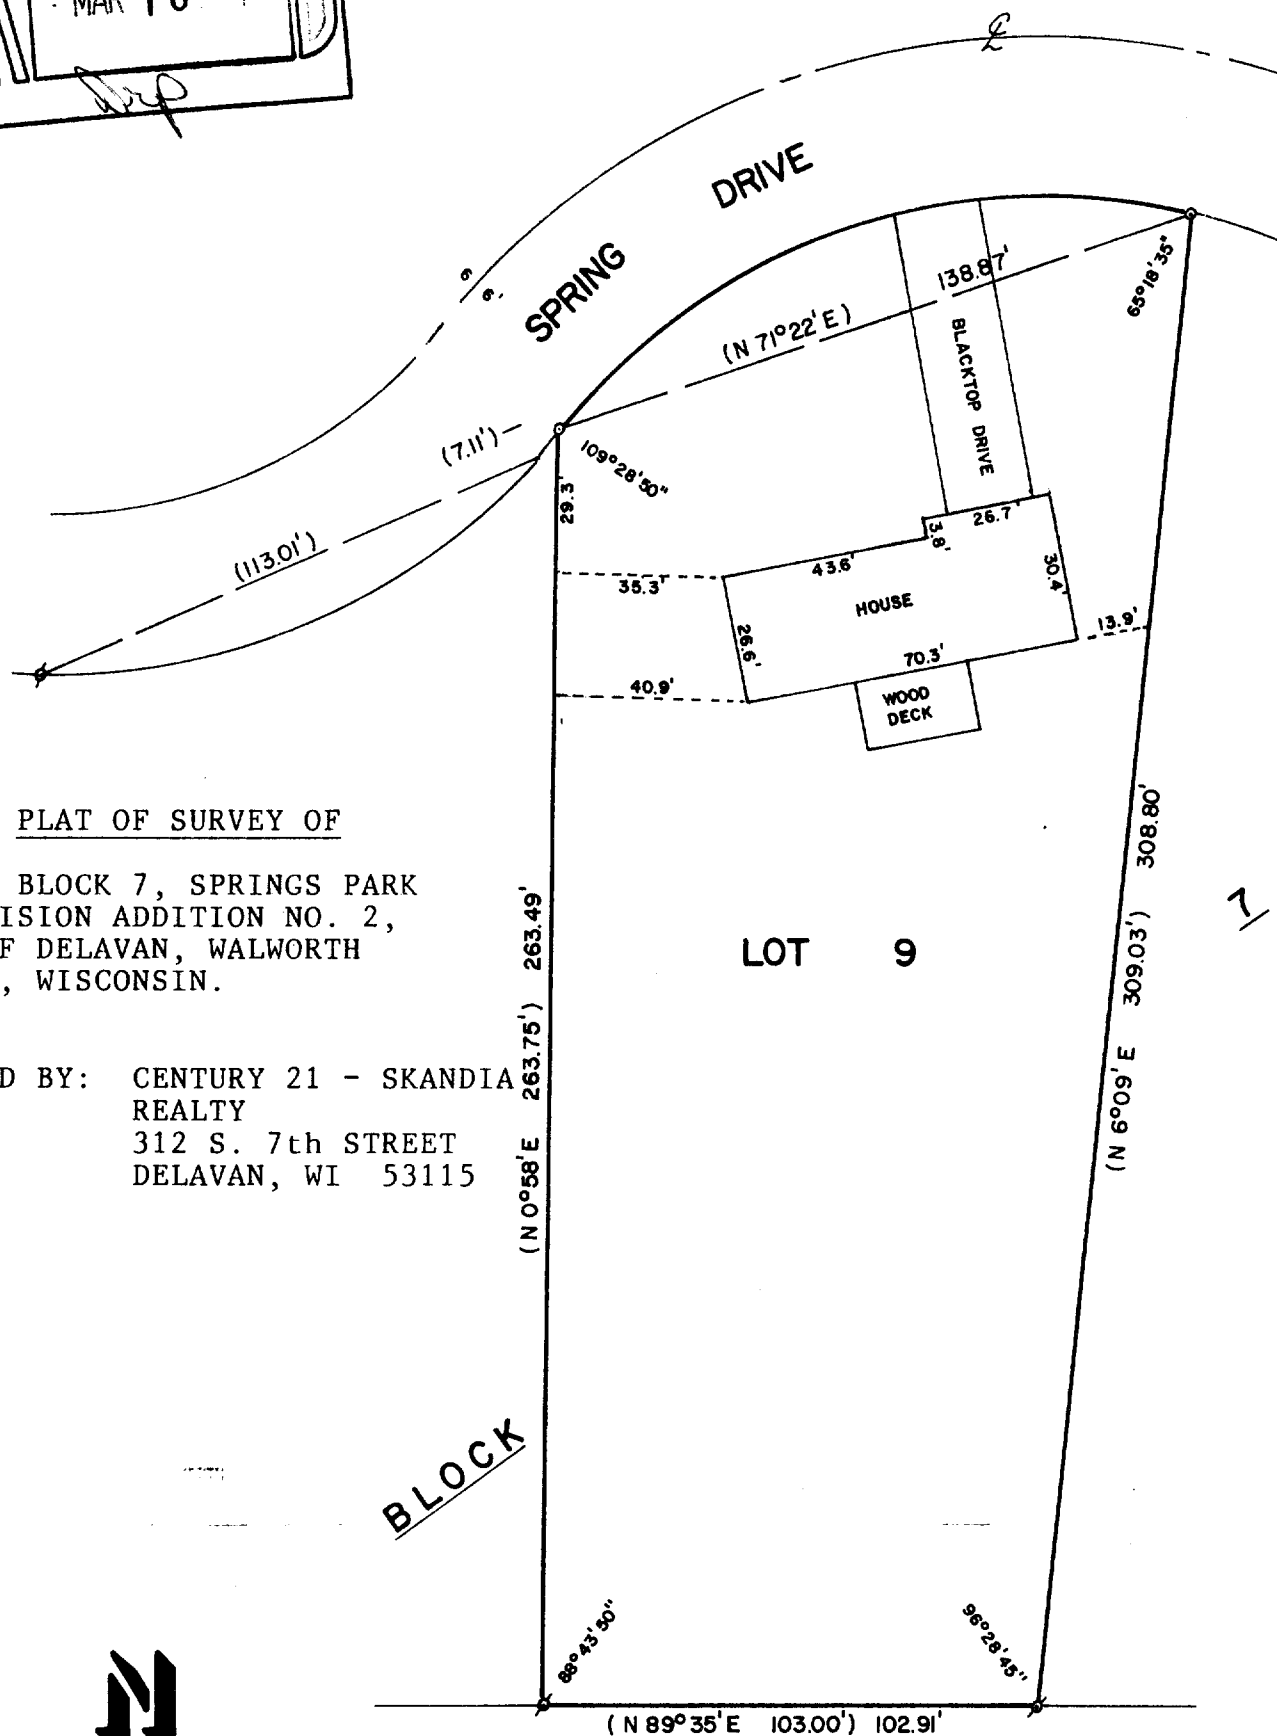

NOTE: THIS IS NOT A CERTIFIED COPY UNLESS SEALED.