
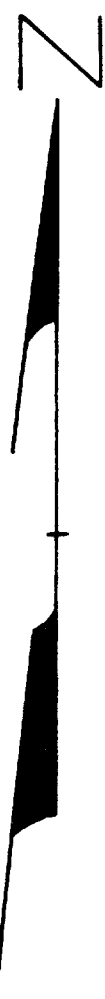


DUNHAM SURVEYING, S. C.
SURVEYING & SUBDIVIDING
DELAVAN, WISCONSIN 53115

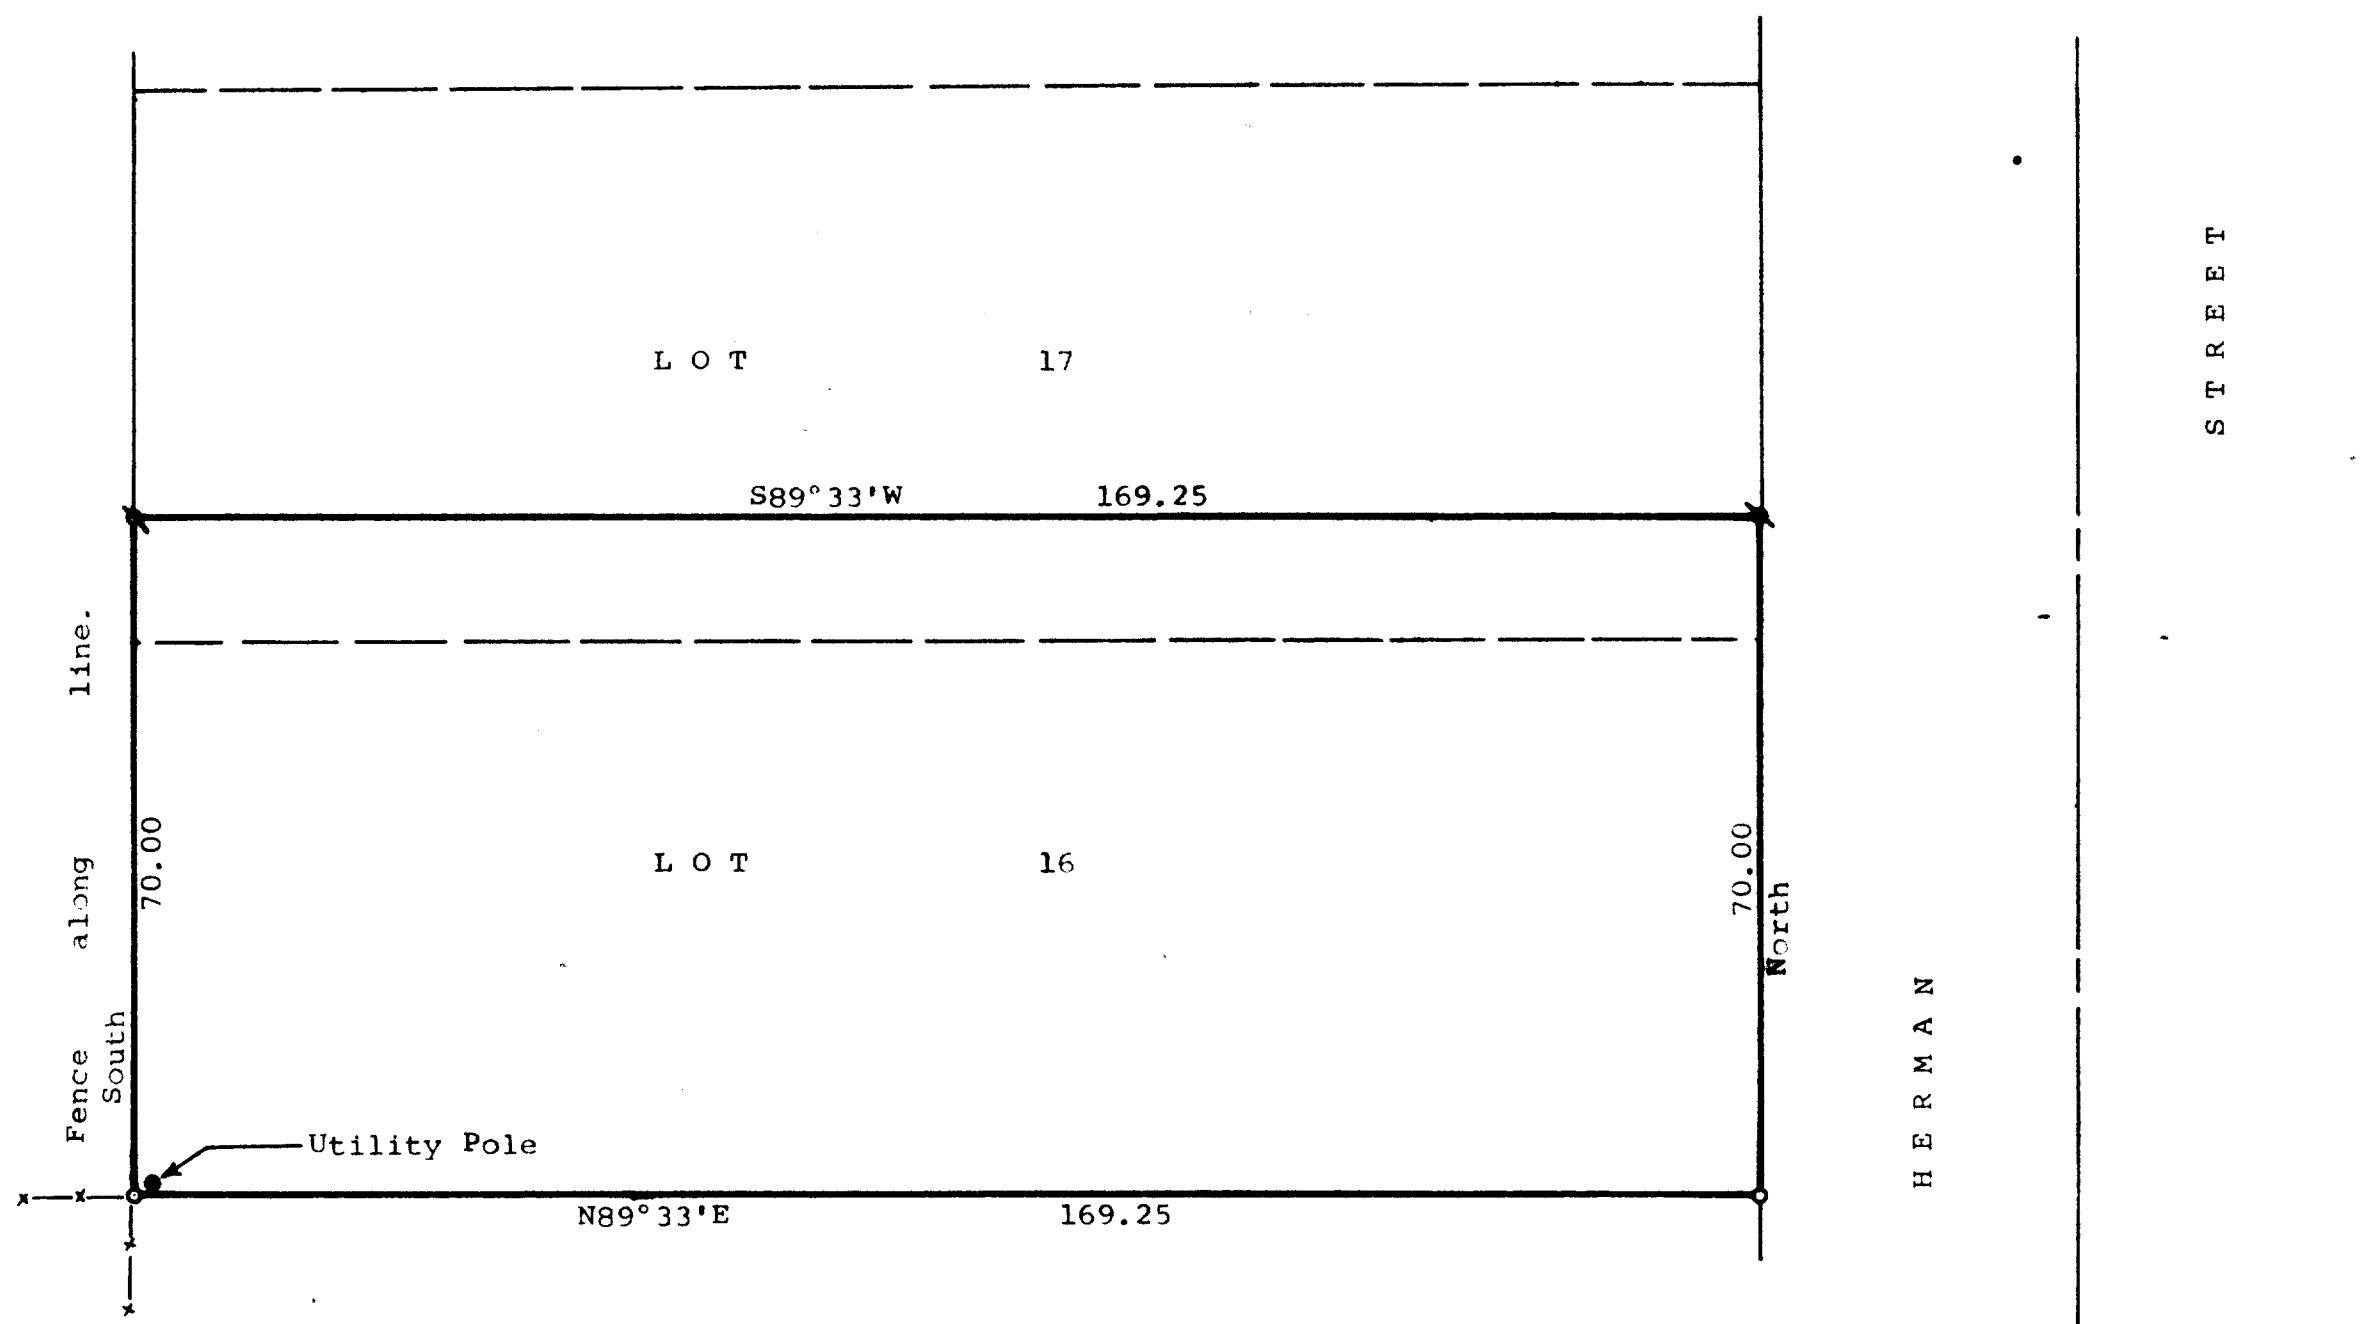


STATE OF WISCONSIN)
COUNTY OF WALWORTH) SS

I, George T. Dunham, Surveyor, certify that I have surveyed the property described as follows:


Lot 16 and the South 13.00 feet of Lot 17, Block 3 in Fairview Heights, a subdivision located in the City of Delavan, Walworth County, Wisconsin,

and that the map shown hereon is a correct representation thereof and shows the size and location of the property, its exterior boundaries, the location of all visible structures and dimensions of all principal buildings thereon, boundary fences, apparent easements, roadways and visible encroachments, if any, and that I have surveyed the property hereon described according to the official records, to the best of my knowledge and belief.

April 21, 1987

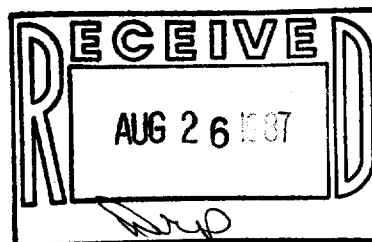

George T. Dunham, Surveyor

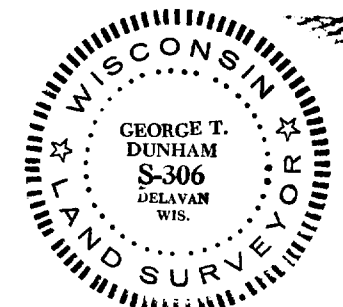

Scale - 1" = 20'
○ = 3/4" Dia. Iron Pipe Found
● = 1/2" Dia. Iron Pipe Found
--- = Fence Line

Bearings are referenced to the West line of Herman Street, Assumed Bearing of North.

Survey ordered by: Century 21
Skandia Realty
312 S. 7th Street
Delavan, WI 53115